


Lt. & Glasgow.
21/8/82.

S. S. "Torreador"
Glasgow Report No. 6205.

Longitudinal Section for S.S. 24 S.S.
Scale 1/8" = One foot

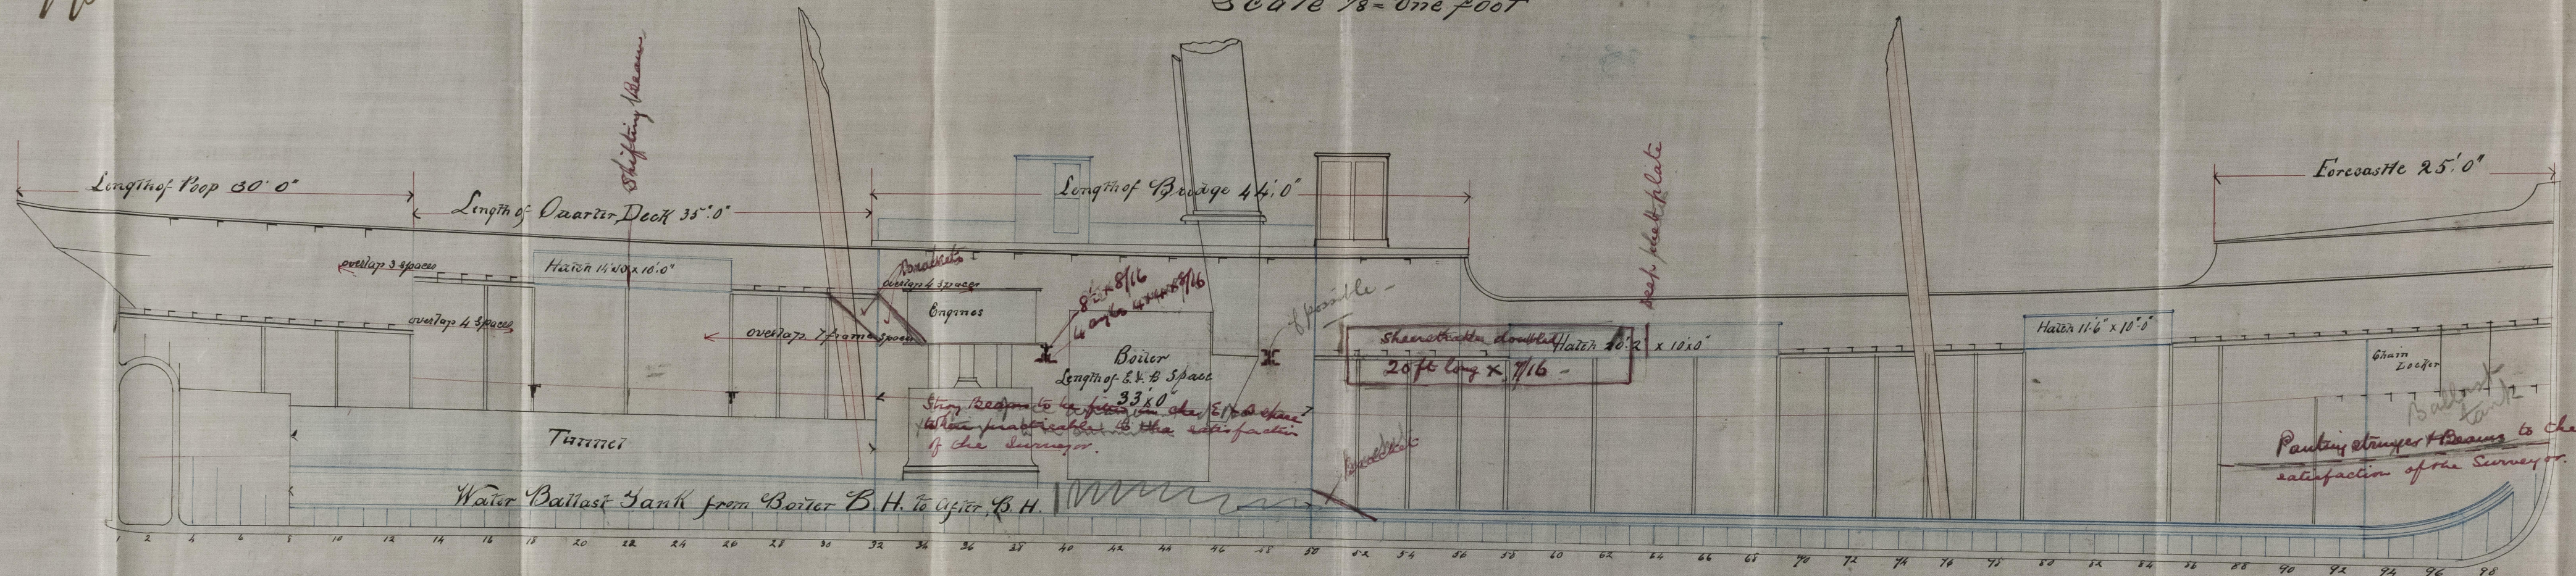

C. 19/8/82

