




18/1/83

MARINE BOILER FOR ENGINES N^o 74 Steel.

SCALE / INCH TO ONE FOOT

Working Pressure 80 lbs.
90 lb tested to 160 lb.


S.S. "Hilda"
Glasgow Report
N^o 6235.

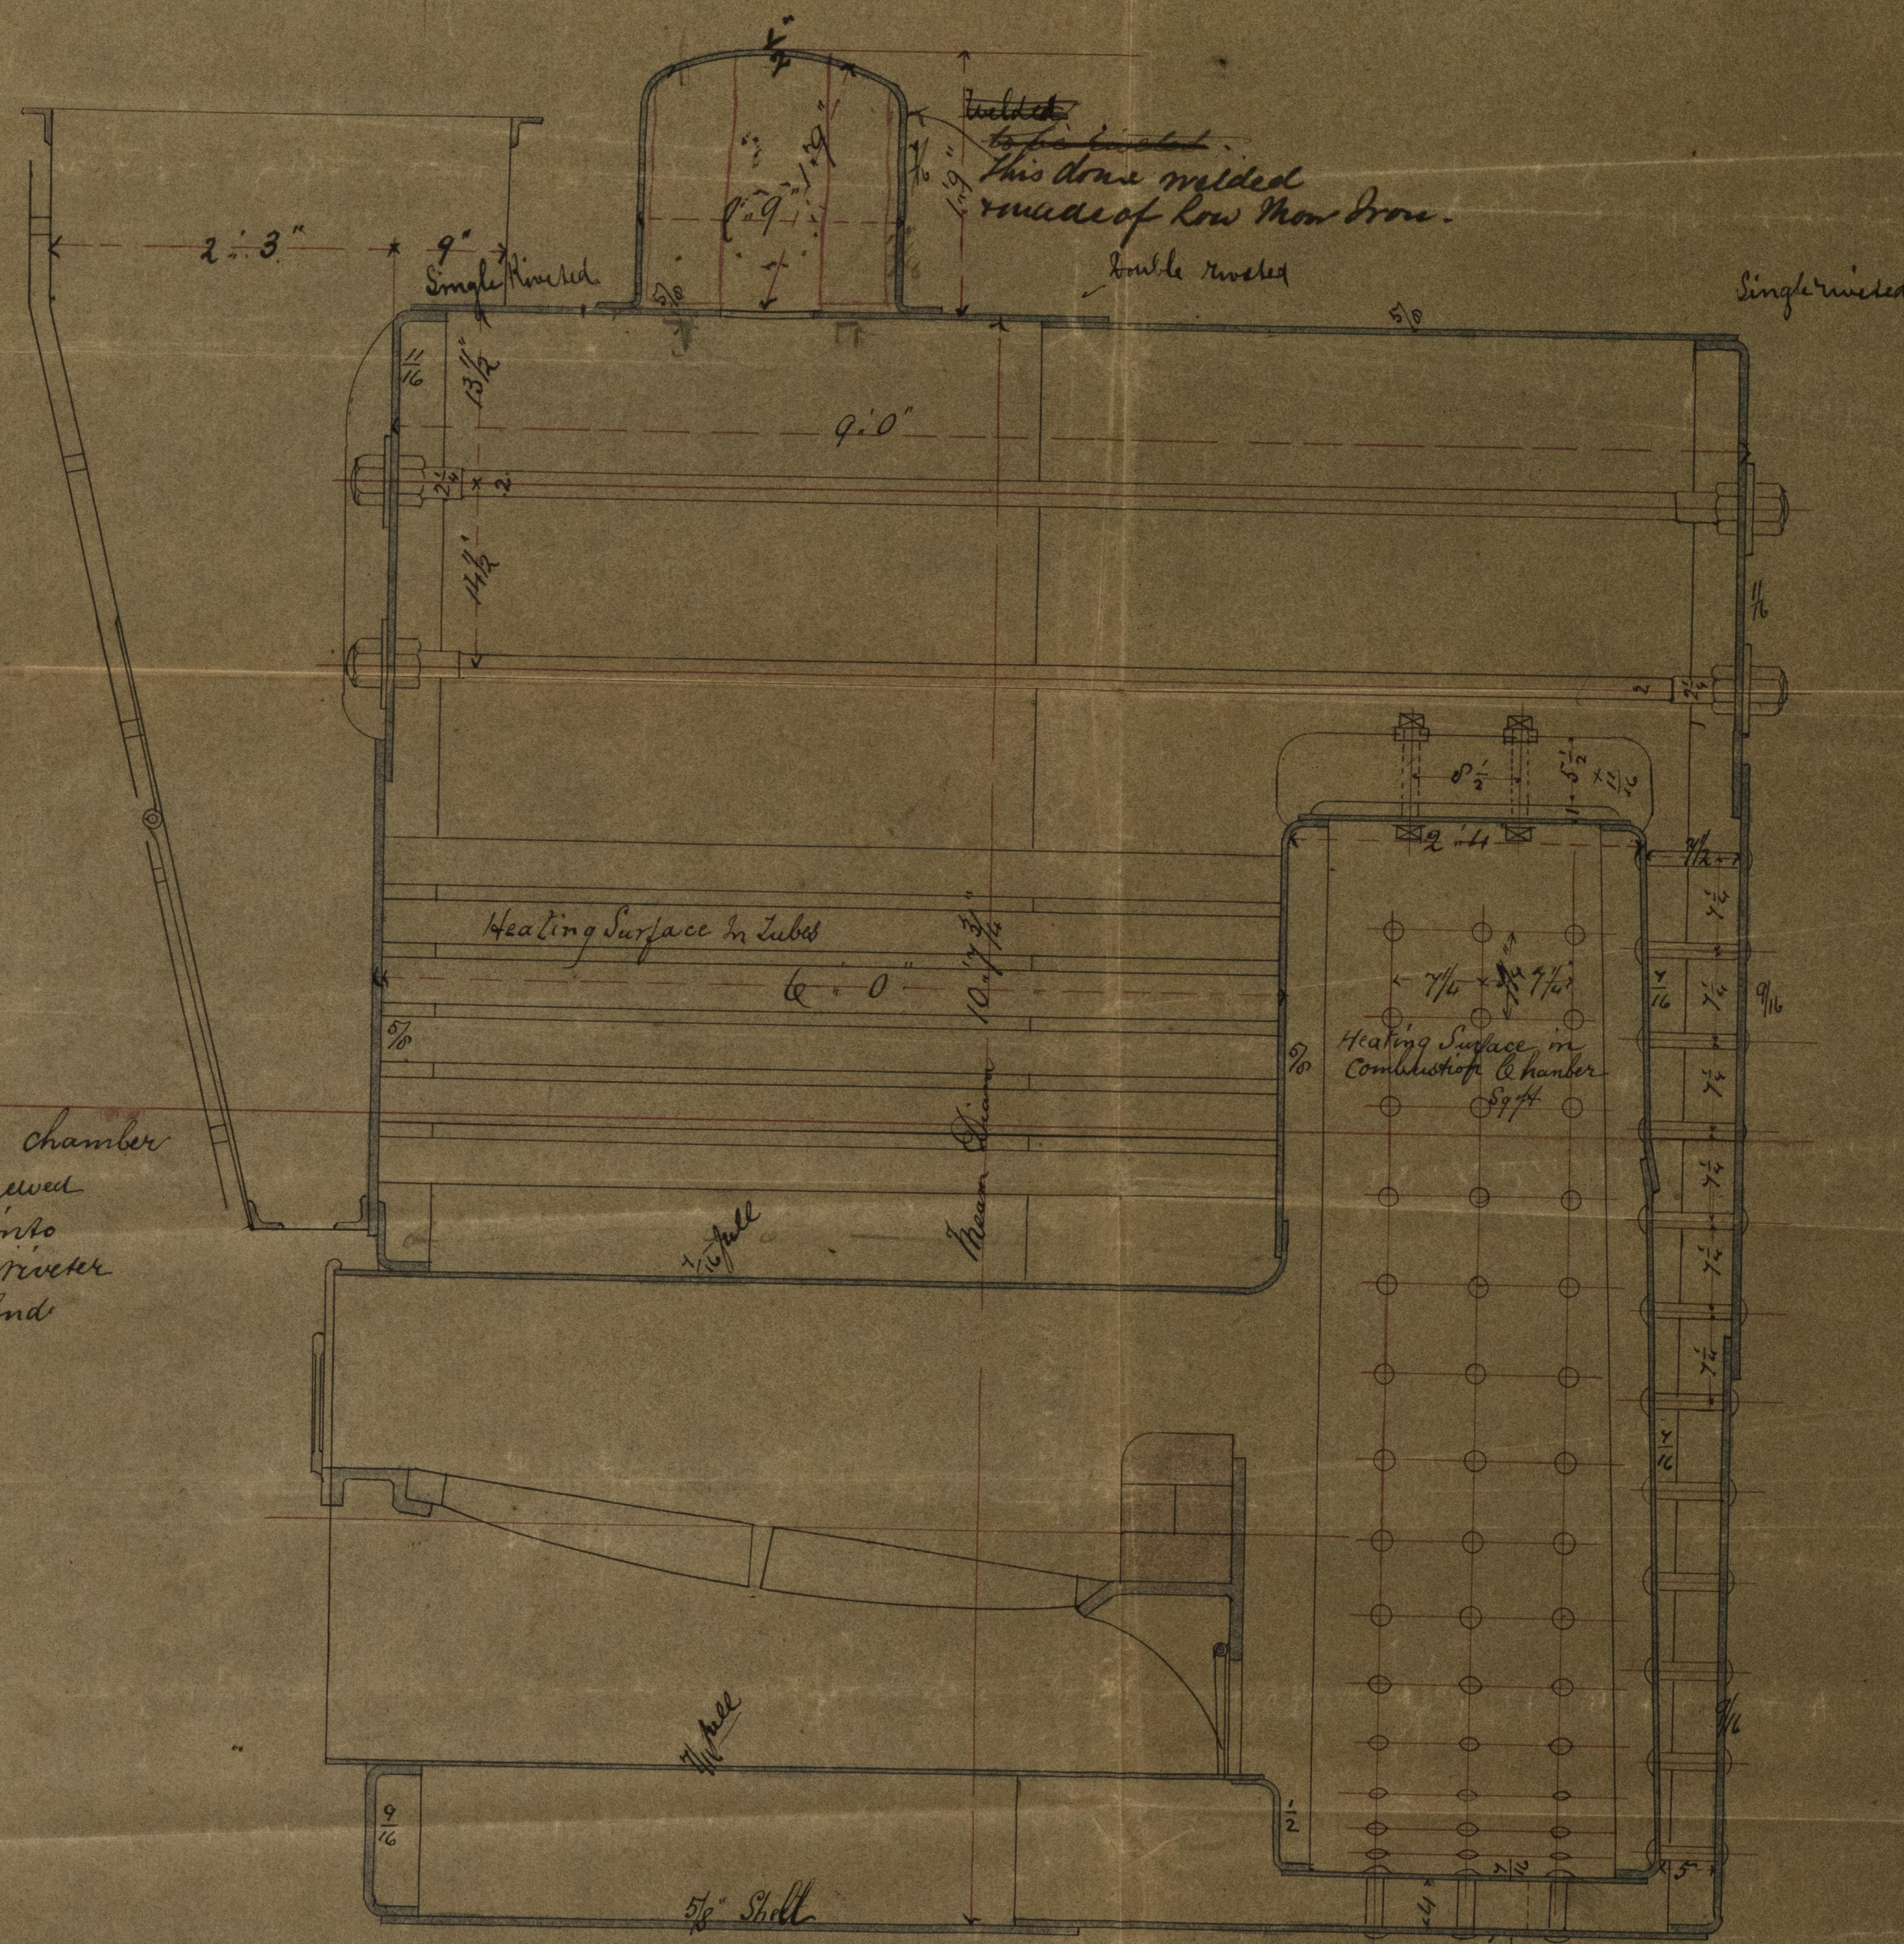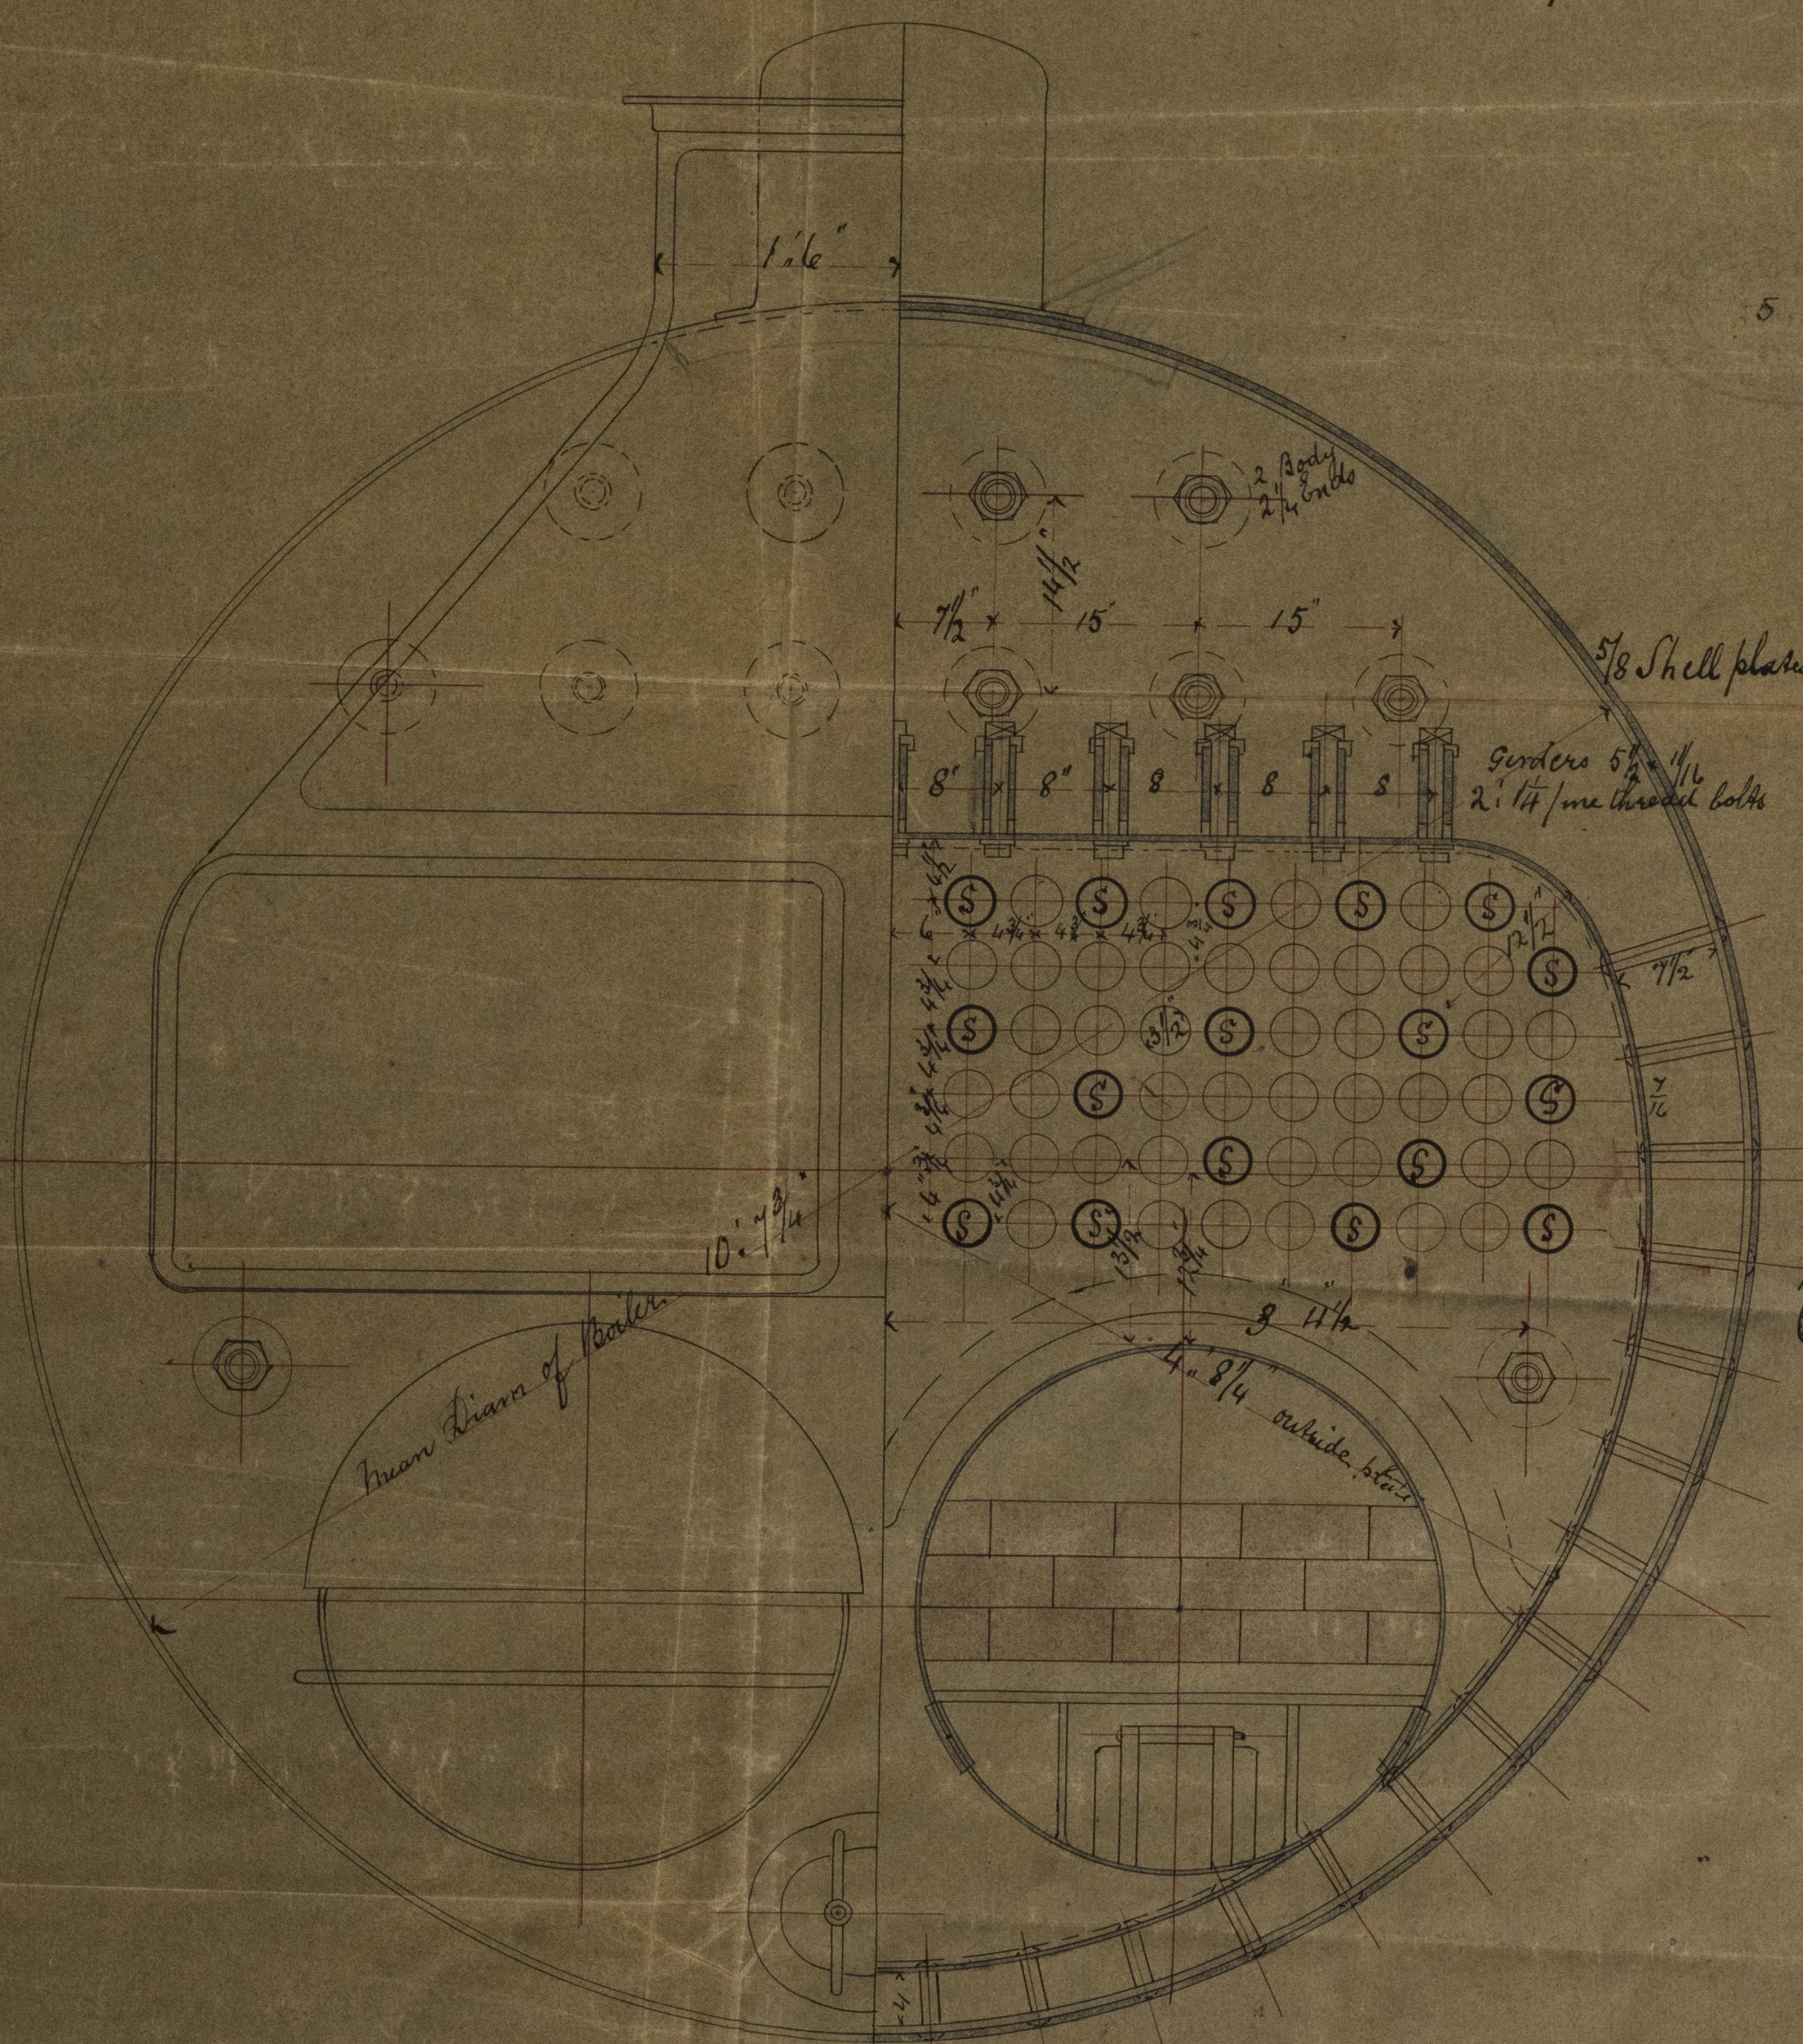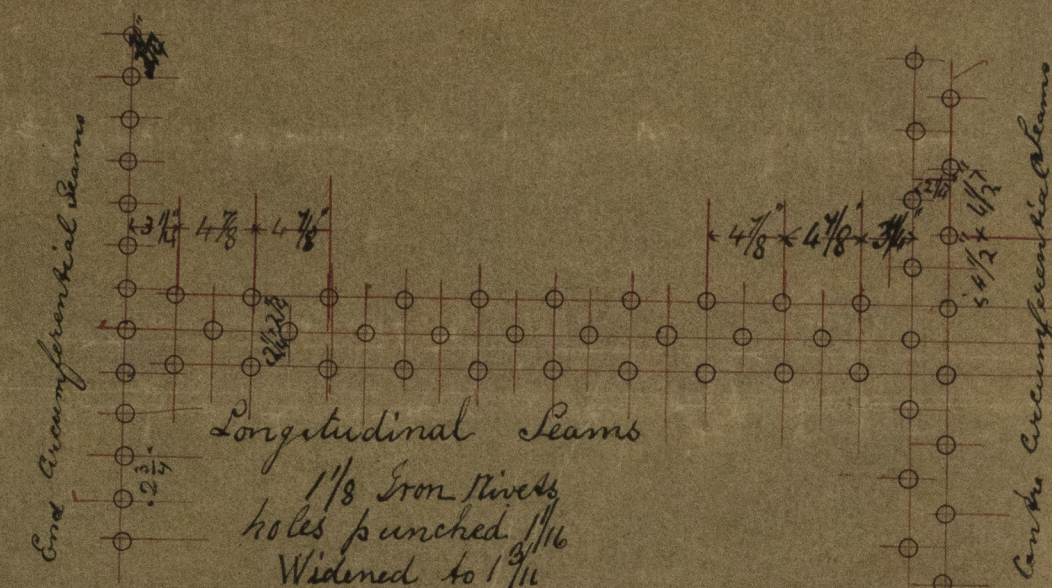

M. Glasgow
14.1.83

J. Glasgow
14/1/83

St Kilda
Shs 6285

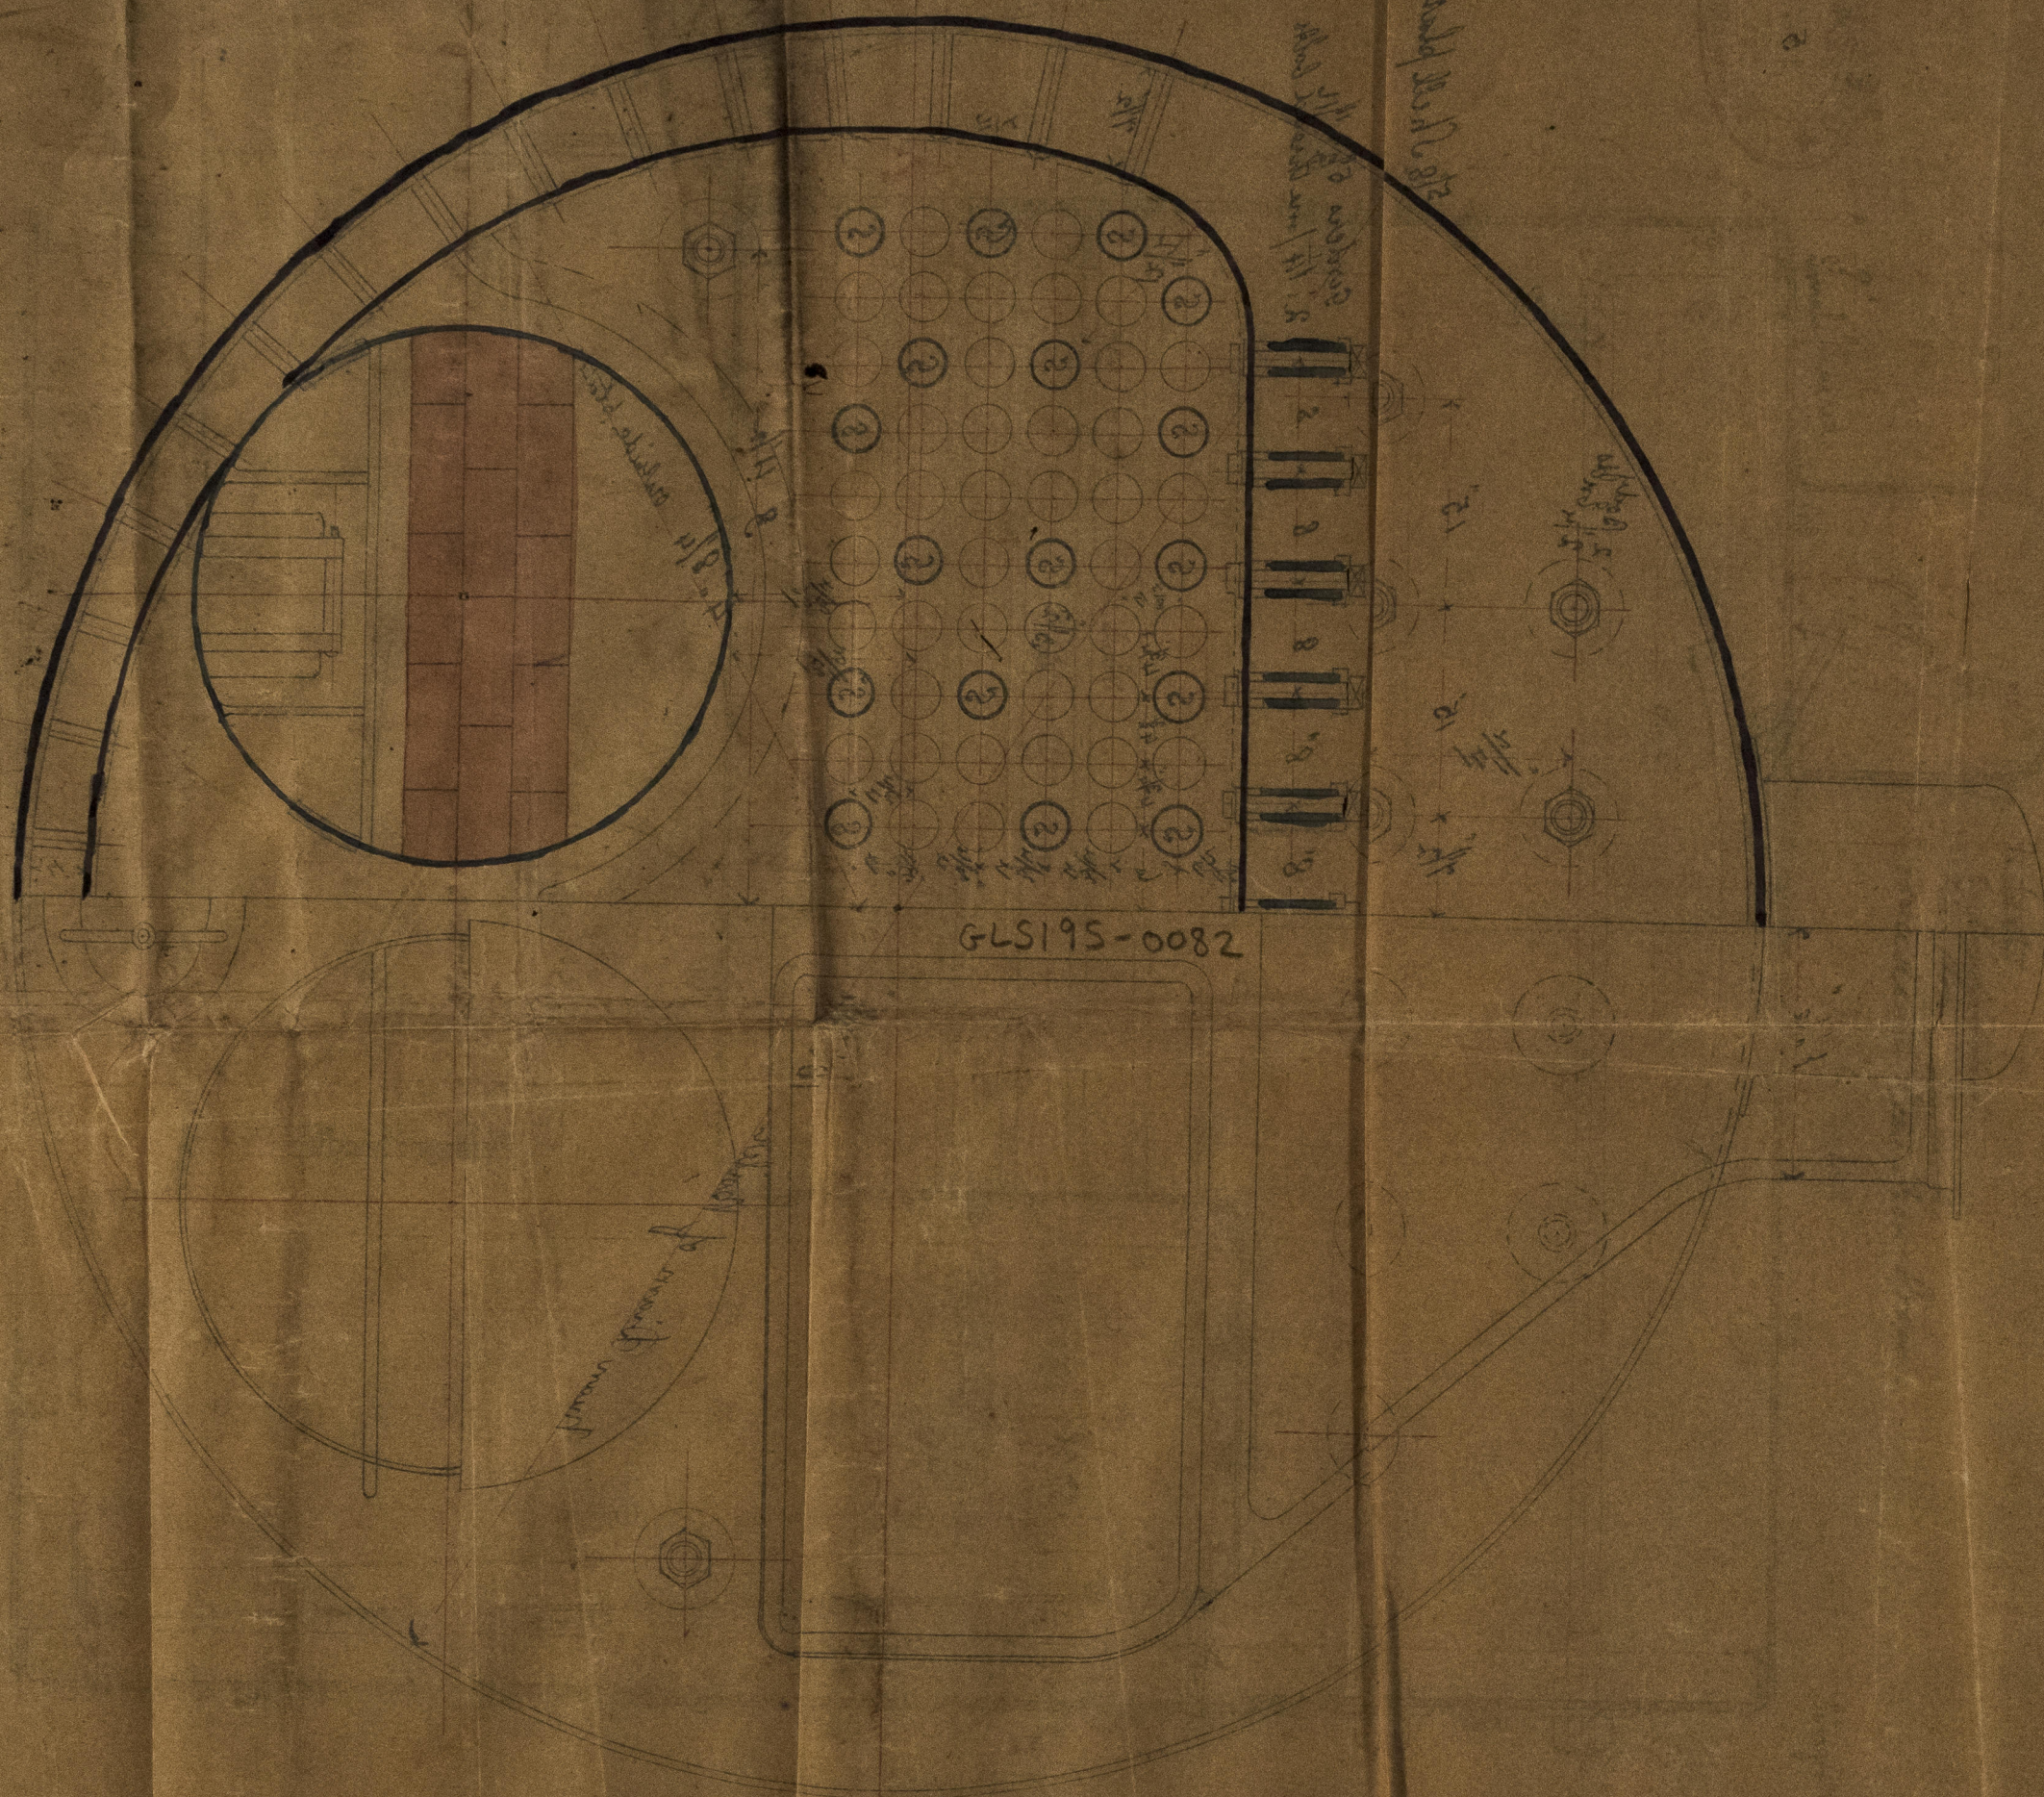

GLS195-0082

21/1/77

WYBINE BC