
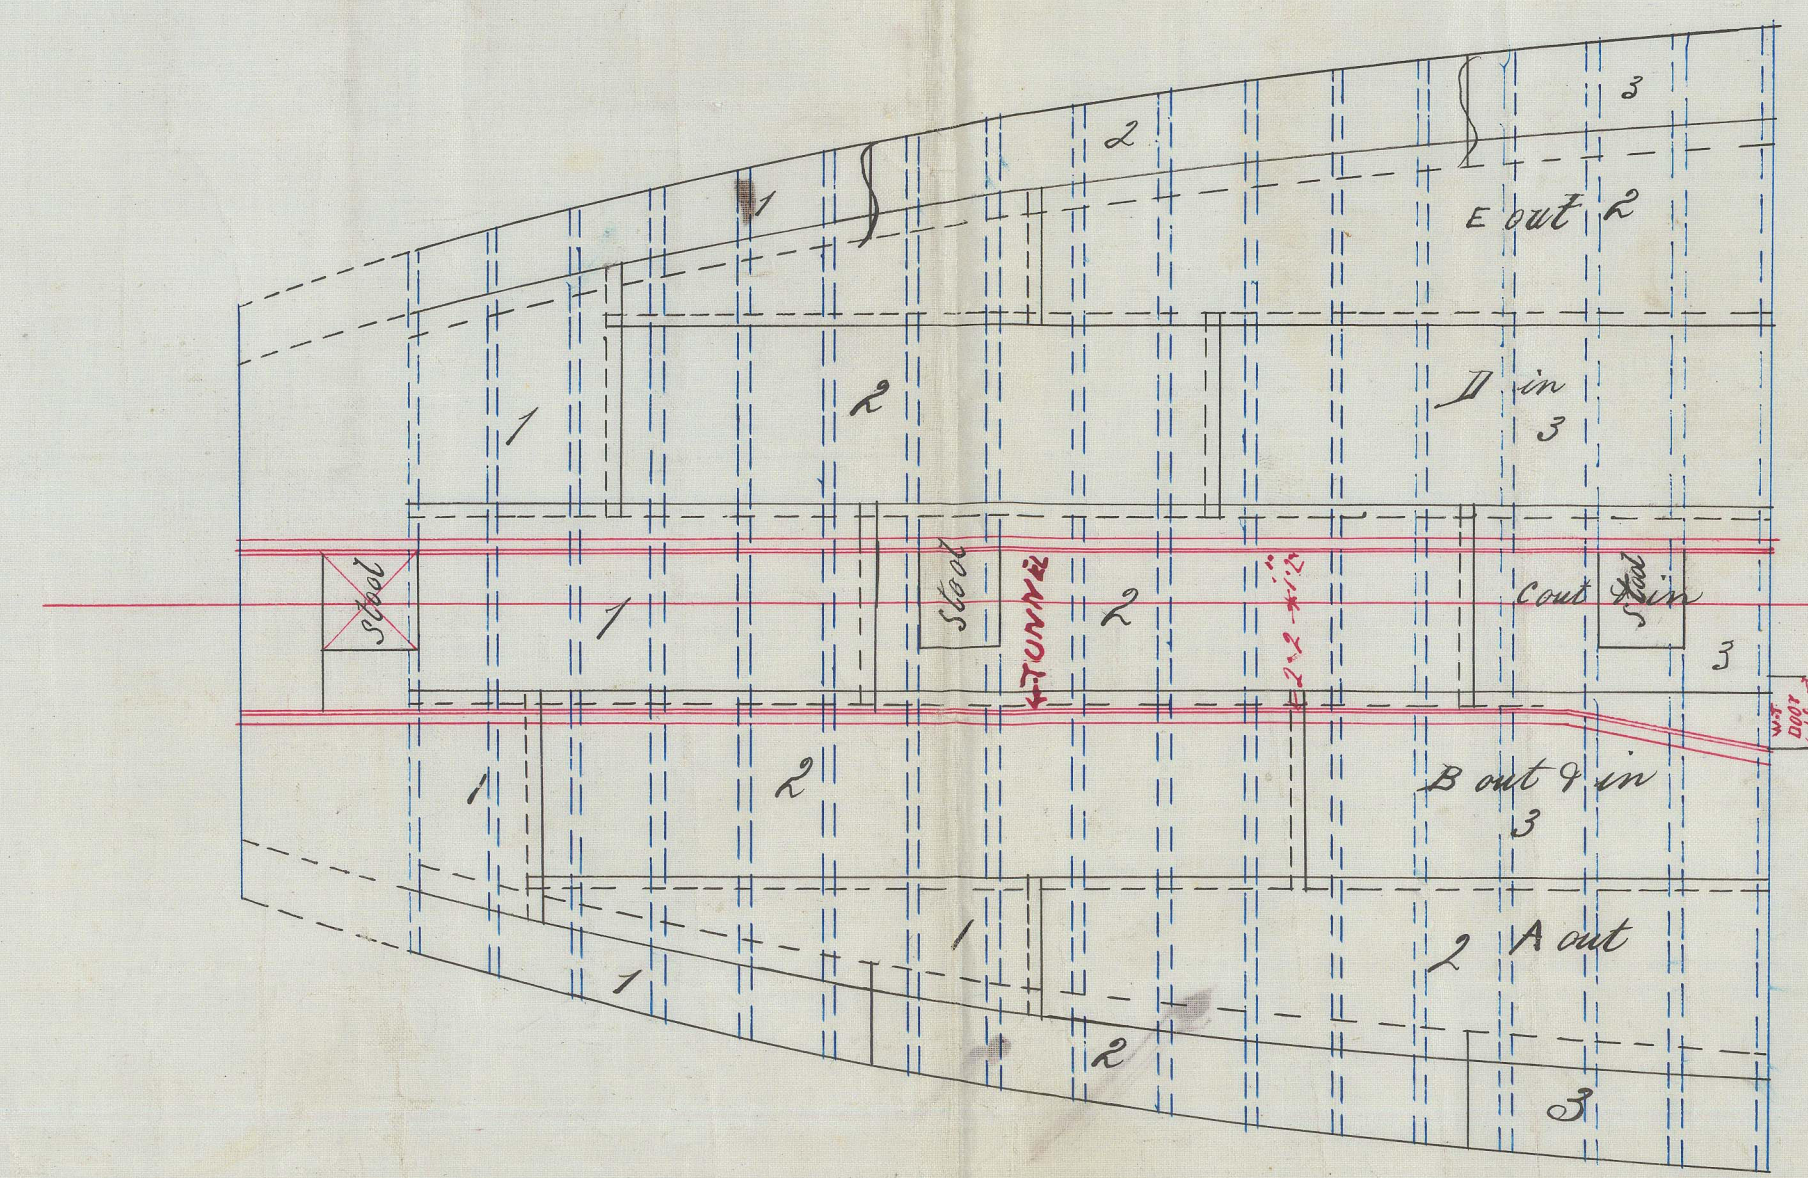


RECEIVED 149 NOV 22


Lt. to Gls.
15/11/82

Scale $\frac{1}{4}$ " = 1 foot.
S.S. No 93

No 93. - S.S. "Crowaiti" Glasgow Report No 6008
" 100. - S.S. "Wareatea" do do 6238.

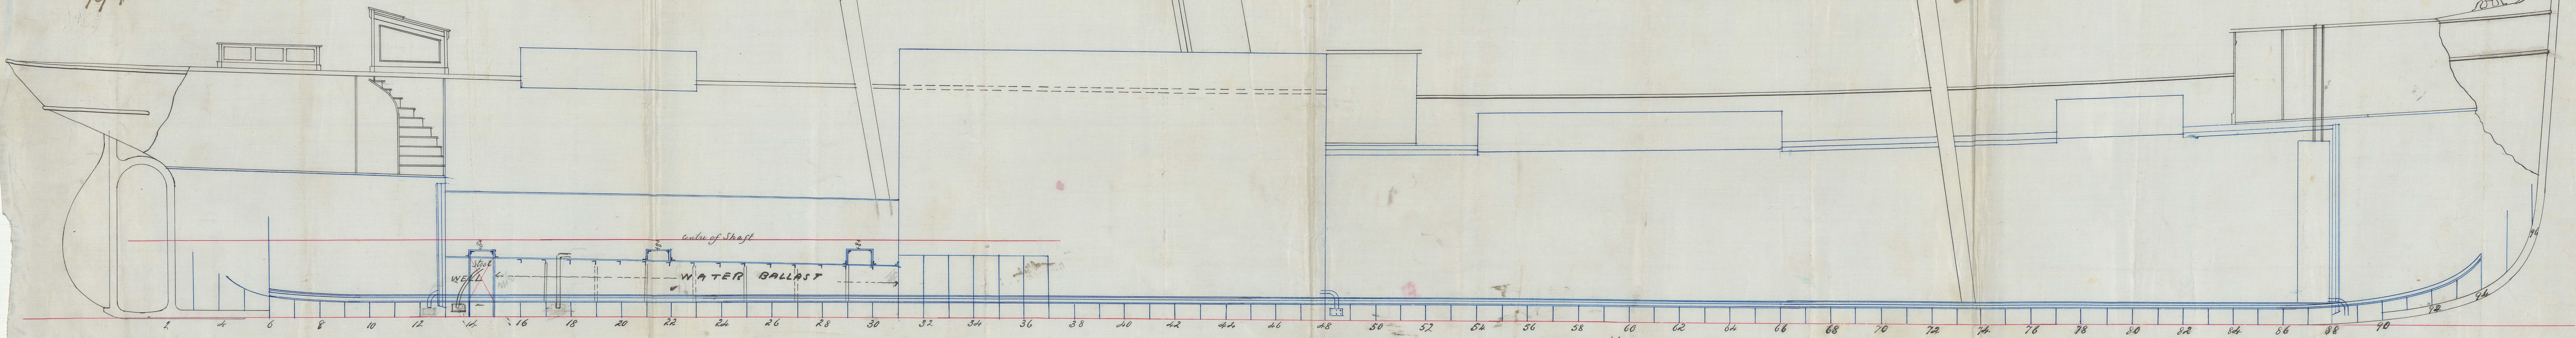

PLAN.

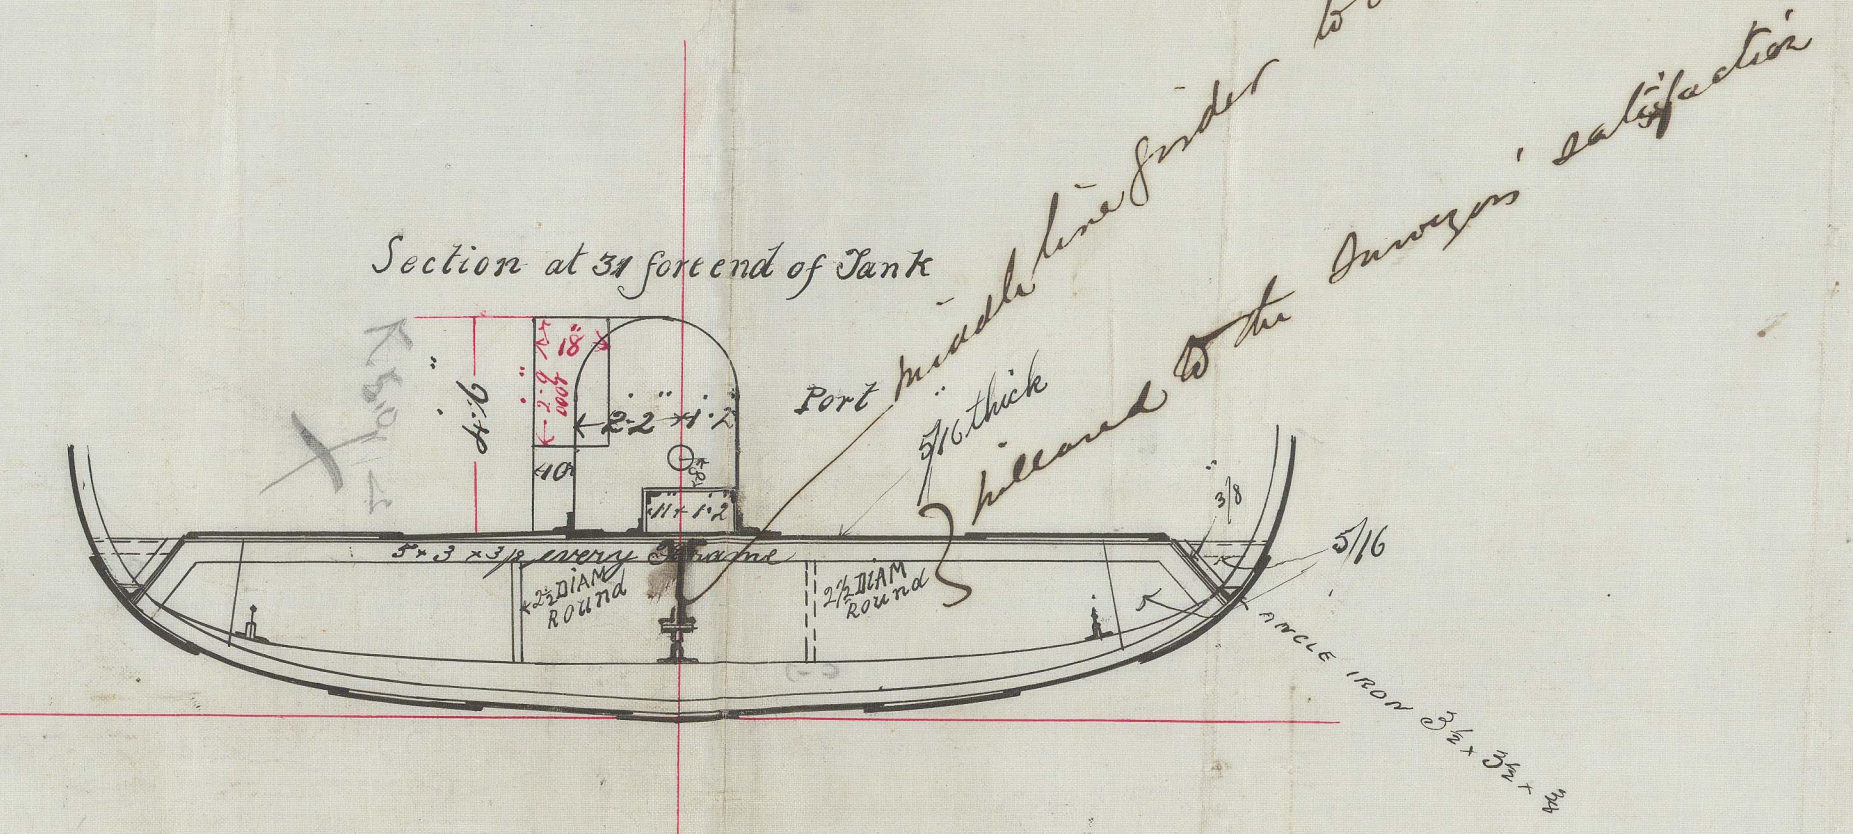

Section at fore end of Tank

H. MONTYRE & CO.
8/11/82
Drawing No 938

13/11/82
15/11/82