

Lloyd's Register of British and Foreign Shipping.

(Received in the London Office, RECEIVED 19th APR 83)

P.

No. 144

REPORT ON SHIP FORGINGS.

Sir,

I beg leave to report that the undermentioned Forgings, manufactured by
Messrs J & R McIntyre of *Dalmuir*
 for the Vessel No. 100, being built by *Messrs J. McIntyre & Co*
 of *Paisley* have been inspected by me in course
 of being forged and smithed, and found to be, so far as can be seen, *sound and*
efficient

Mark on Forging.

Lloyd's

No. 144

G. N

The Secretary,
 London.

I am, Sir,


Your Obedient Servant,

George Newcomb

Glasgow

	STERN FRAMES.	RUDDER FRAMES.	STEMS.
Material* - - - -	/	<i>Scrap iron</i>	/
How made - - - -		<i>Forged</i>	
Dimensions - - - -		<i>3 3/4 x 3 1/4 to 3 1/2 x 2 3/4</i>	
Progress on Inspection -		<i>Forged and smithed</i>	
Dates when Inspected -		<i>6.12.14/4/83.</i>	

SKETCHES OF FRAMES SHEWING POSITION AND DESCRIPTION OF WELDS.

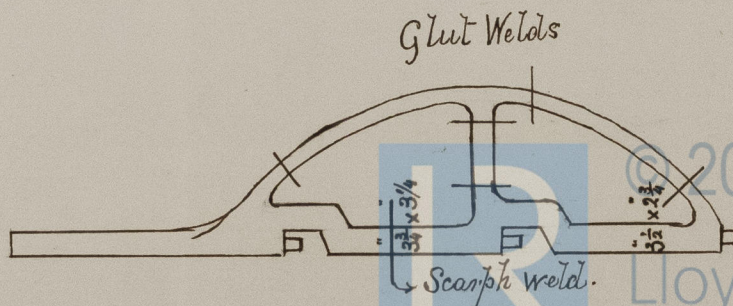

D.S.
19/4/83