

Lloyd's Register of British and Foreign Shipping.

(Received in the London Office) RECEIVED 30th MAR. '83.

P.

No. 144

REPORT ON SHIP FORGINGS.

Sir,

I beg leave to report that the undermentioned Forgings, manufactured by *Messrs H & R. Mc Intyre* of *Dalmuir* for the Vessel No. *100*, being built by *Messrs H. Mc Intyre & Co* of *Paisley* have been inspected by me in course of being forged and smithed, and found to be, so far as can be seen, *sound, and free from surface defects*

Mark on Forging.

Lloyd's

No. 144

I am, Sir,


Your Obedient Servant,

George Newcomb
Glasgow

The Secretary,
London.

	STERN FRAMES.	RUDDER FRAMES.	STEMS.
Material*	<i>Scrap iron</i>	/	<i>Scrap iron</i>
How made	<i>Forged</i>		<i>Forged</i>
Dimensions	<i>6 1/2 x 3 3/4</i>		<i>6 1/2 x 1 7/8</i>
Progress on Inspection	<i>Forged & smithed</i>		<i>Forged</i>
Dates when Inspected	<i>22. 30/11/82. 28/12/82</i>		<i>22/11/82.</i>

SKETCHES OF FRAMES SHEWING POSITION AND DESCRIPTION OF WELDS.

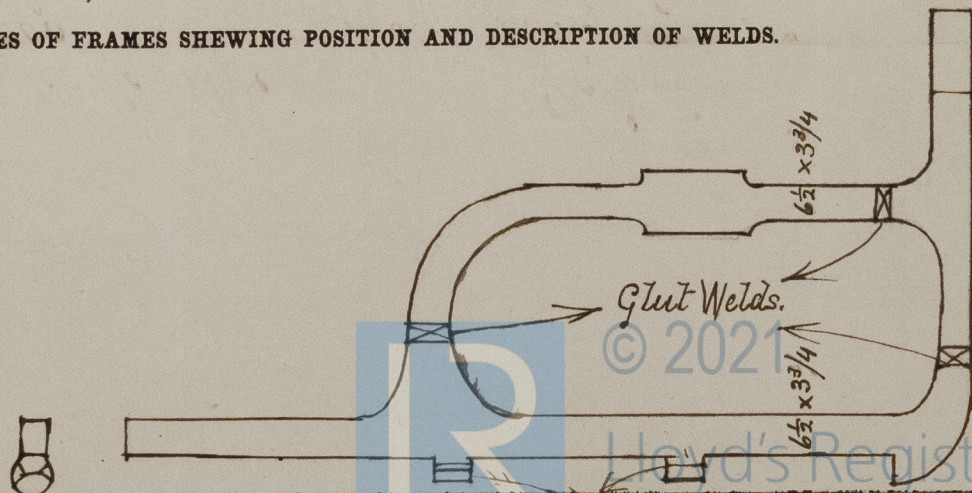

* If of iron, state whether scrap or puddled iron.

Piece welded on, and glut welded at each side.