
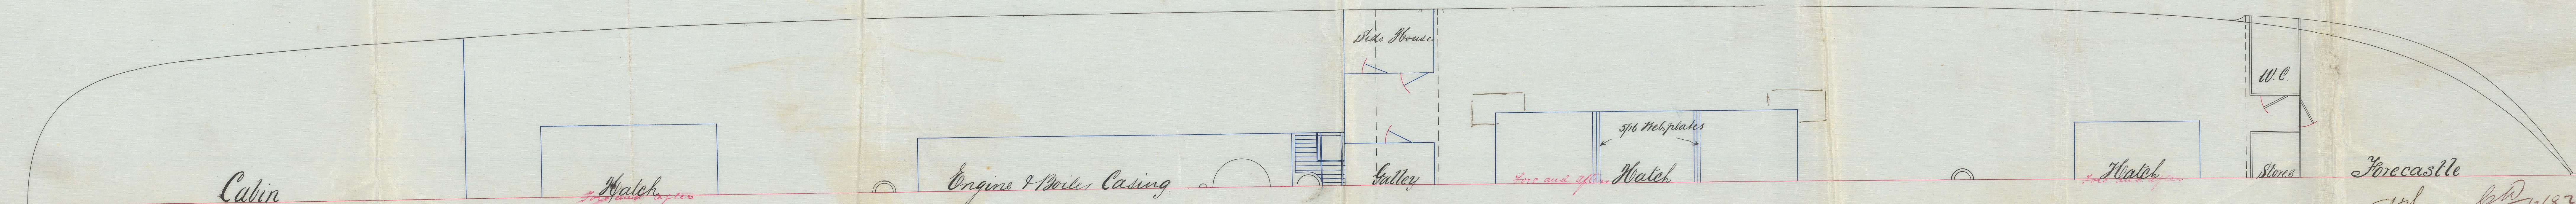


13. 24

N^o 90. - S. S. "Hawaitiro" - Glasgow Report N^o 5894. -
 " 93. - S. S. "Crowaiti" - do - 6008. -
 " 100. - S. S. "Wareatea" - do - 6238. -

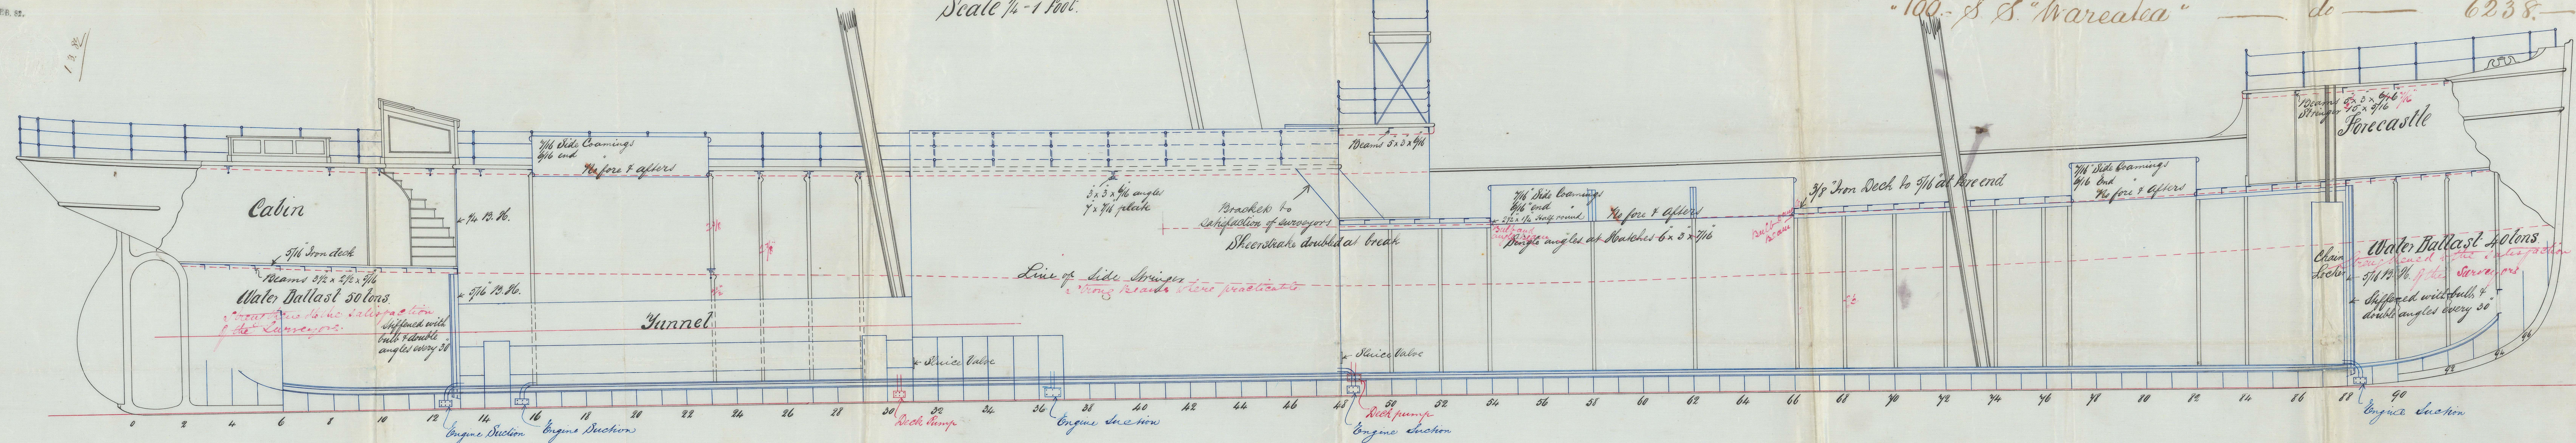

Tracing No 1769
J. MONTYRE & CO.,
Iron Shipbuilders,
PAISLEY
24/2/82

28 *W.L.*
1/2/82

W.L.
27/4/82