

RECEIVED 14 SEP. 82.  
RECEIVED 26th OCT. 82.  
RECEIVED 11 NOV. 82.  
29/9/82

4/11/82  
4/11/82


*S.S. "Maramoa" - Glasgow Report No. 6246.*

**SPAR DECKED STEEL STEAMER  
ELEVATION & POSITION  
OF**

**BULKHEADS**


**S.S. No 271**

SCALE 1" = 10 FEET.

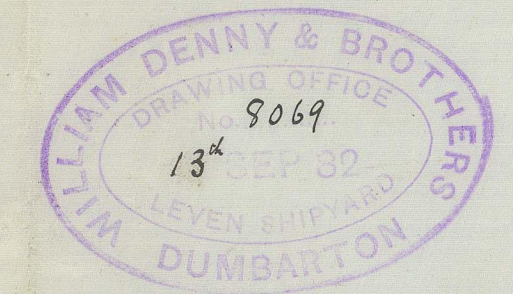

**EQUIPMENT NUMERAL 202690**

1/2 BREADTH	18'0"
1/2 GIRTH	38'55" TO SPAR DECK
DEPTH	24'95"
	81'5" x 248'7" = 202690
2 BOWER ANCHORS	27 1/2 CWT. EX. STOCK
1 " "	25 1/2 " " " " }
1 STREAM " "	8 1/2 " " " " }
1 KEDGE " "	4 1/2 " " " " }
1 " "	2 1/2 " " " " }
210 FATHOMS	1 1/2" STUD CHAIN.
75 " "	1 1/2" STREAM CHAIN OR 4" STEEL WIRE.
30 " "	11" HEMP TOWLINE OR 3 1/2" " "
20 " "	5" HAWSER.
20 " "	7" WARP.

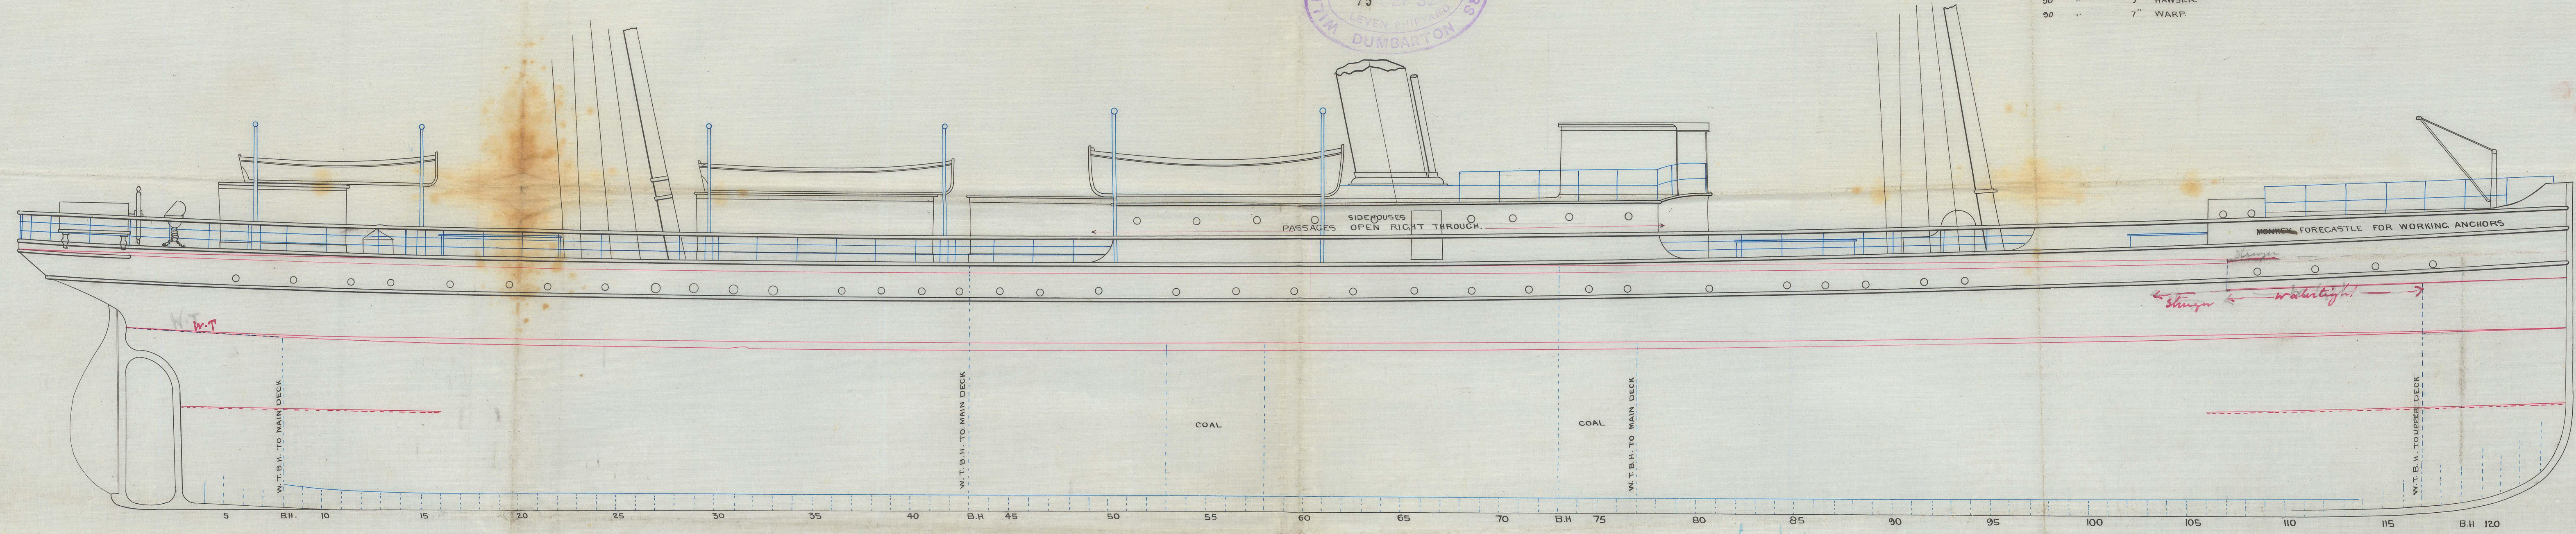

*Whole of Rev. frames to be extended to spar deck in way of Bridge house in addition to the web frames being extended to this height in Engine & Boiler space. See letters of the 22nd & 29th Sept 1882.*

*Rev. frames in way of anchor forecastle to be extended to the forecastle Rk and anchor Rk stringer alternately.*

*J. Rodd  
30/9/82*

*W.H.  
20/9/82*

GLS195-0110



© 2021  
Lloyd's Register  
Foundation