

RECEIVED 23rd SEP. 82.
RECEIVED 26th OCT. 82.
RECEIVED 6th NOV. 82.



29/9/82
1/11/82
9/11/82

S. S. "Mearanoo" Glasgow Report No. 6246

PLAN OF BRIDGE DECK

No 271

SCALE $\frac{1}{4}$ " = ONE FOOT.

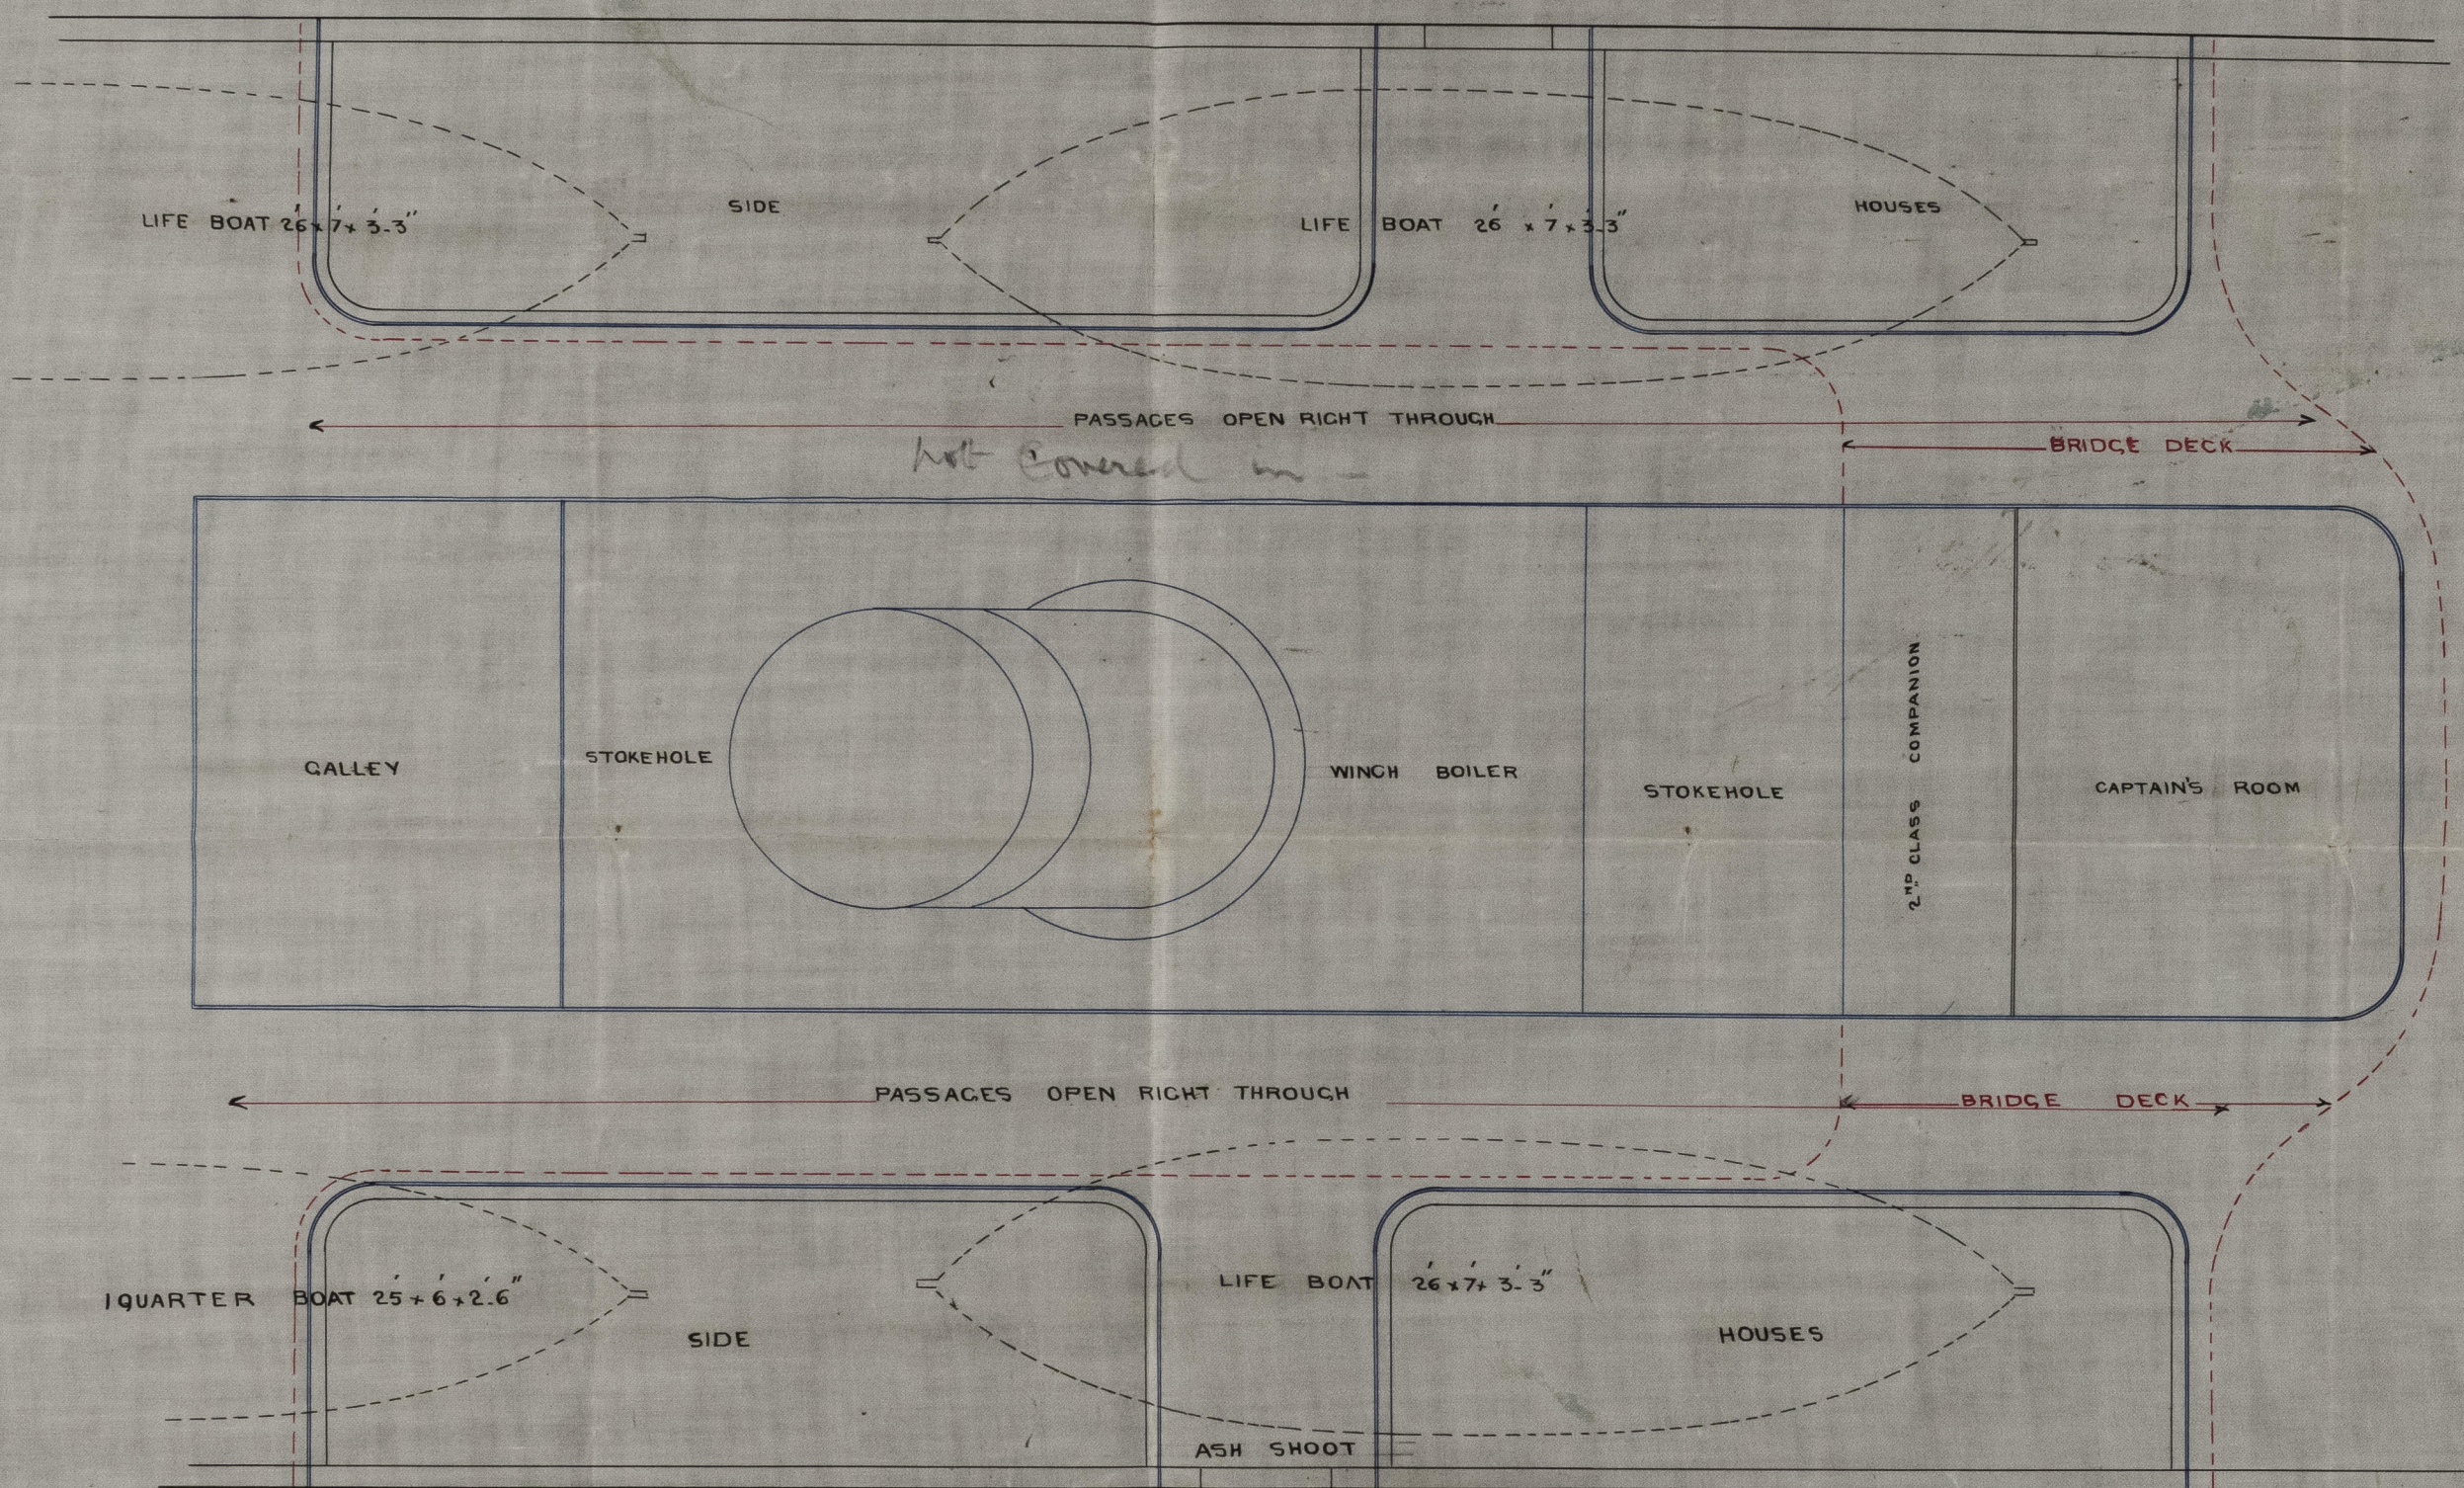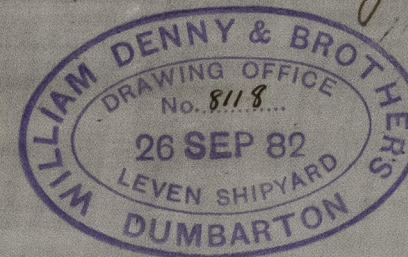

J.H.
29/9/82



© 2021

Lloyd's Register
Foundation
GLS195-0111