


RECEIVED 26th OCT. 82.
RECEIVED 6th NOV. 82.



H. S. Clanger
11/11/82
2/11/82

ENGINE & BOILER SPACES

SCALE $\frac{1}{2}$ - 1 FOOT

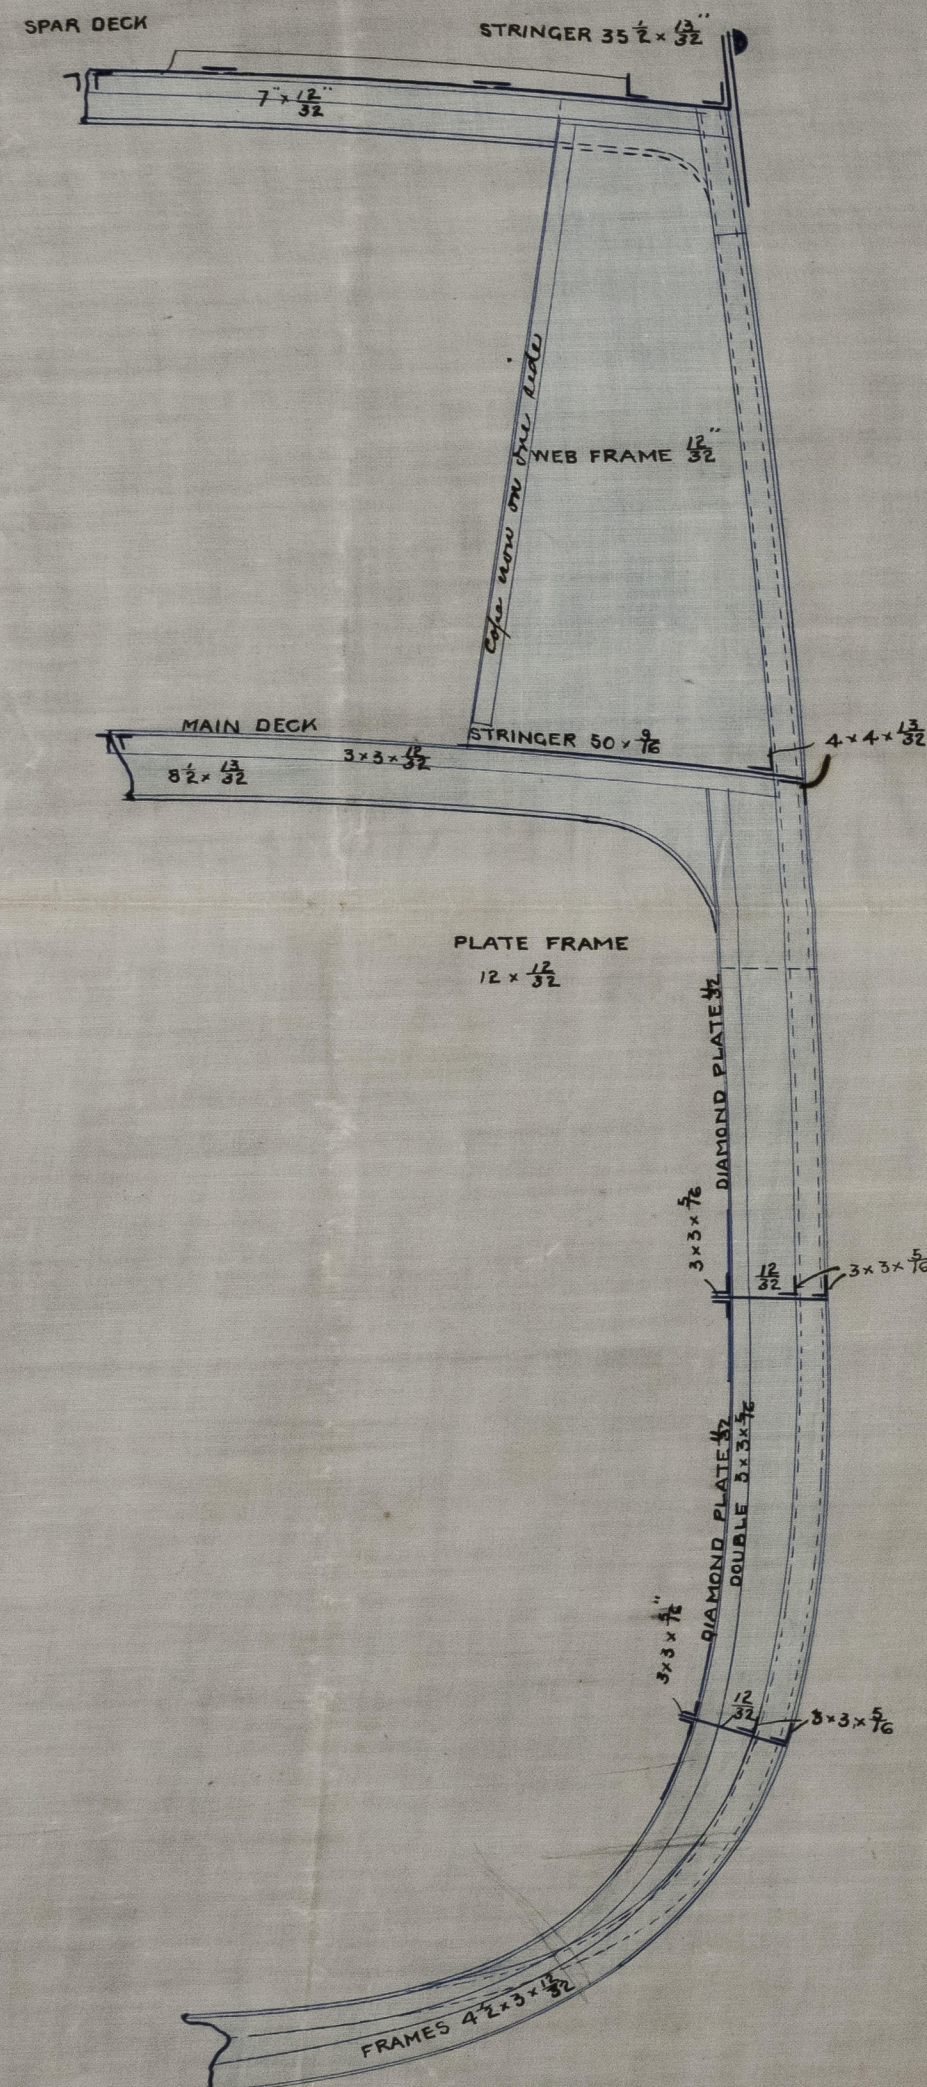

S.S. "Maranoa" - Glasgow Report No. 6246.

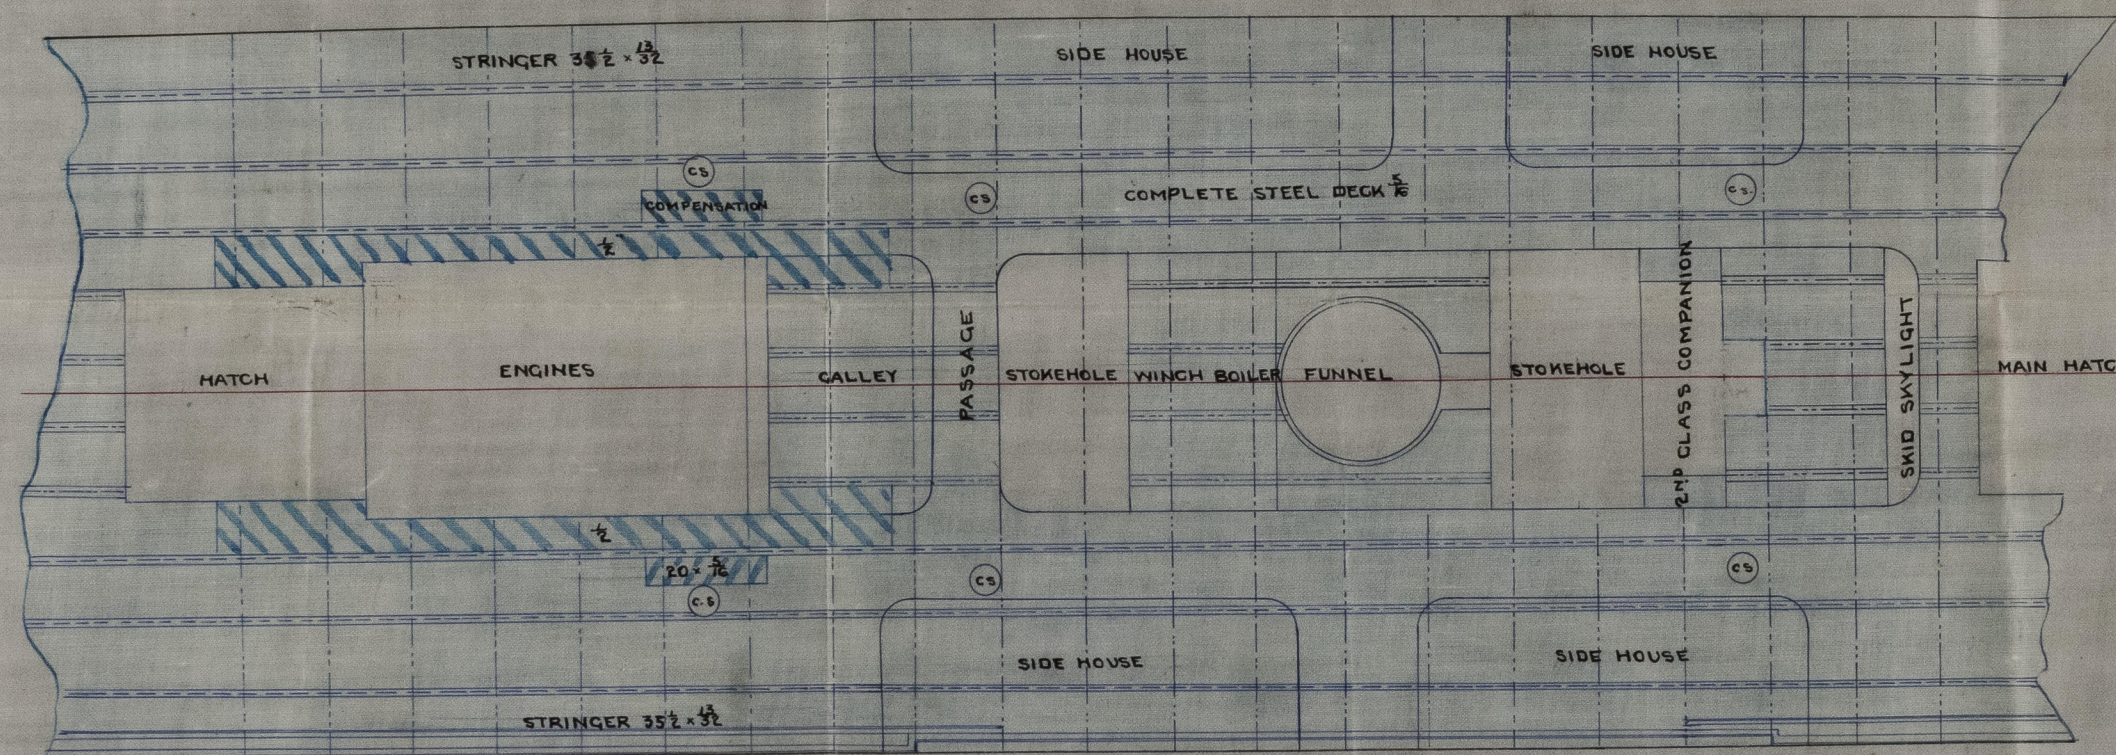
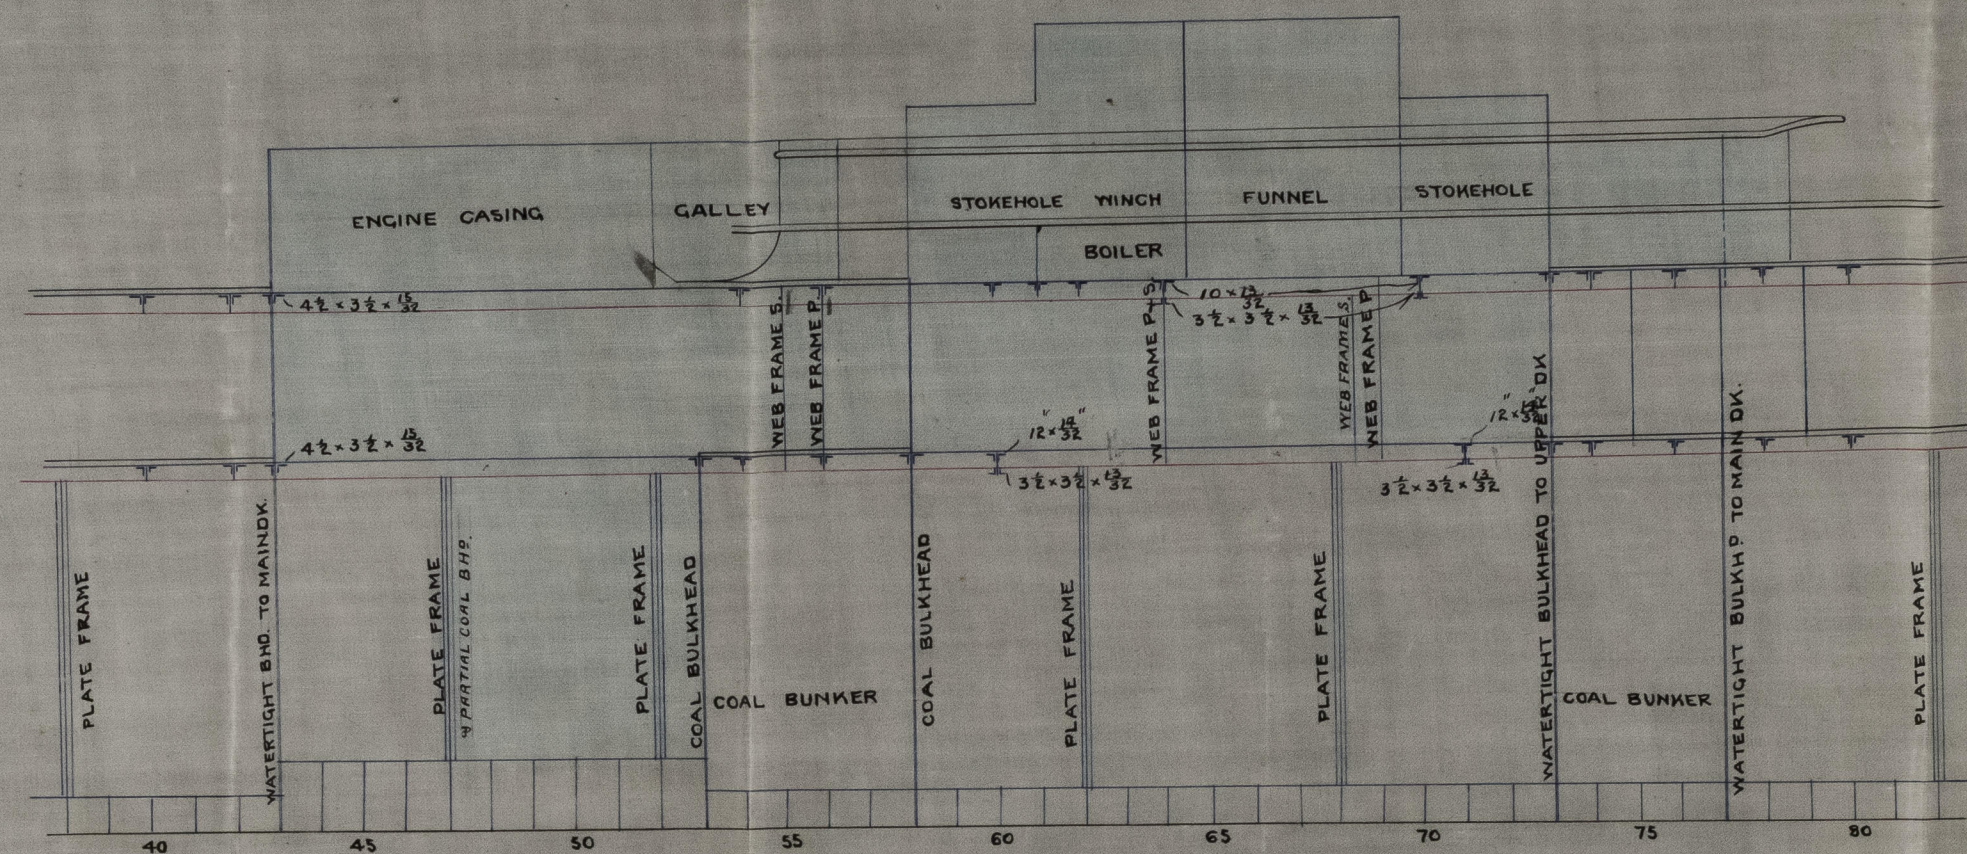


STRENGTHENING IN WAY OF MACHINERY

S.S. No. 271

SCALE $\frac{1}{8}$ - 1 FT.

SPAR DECK PLAN

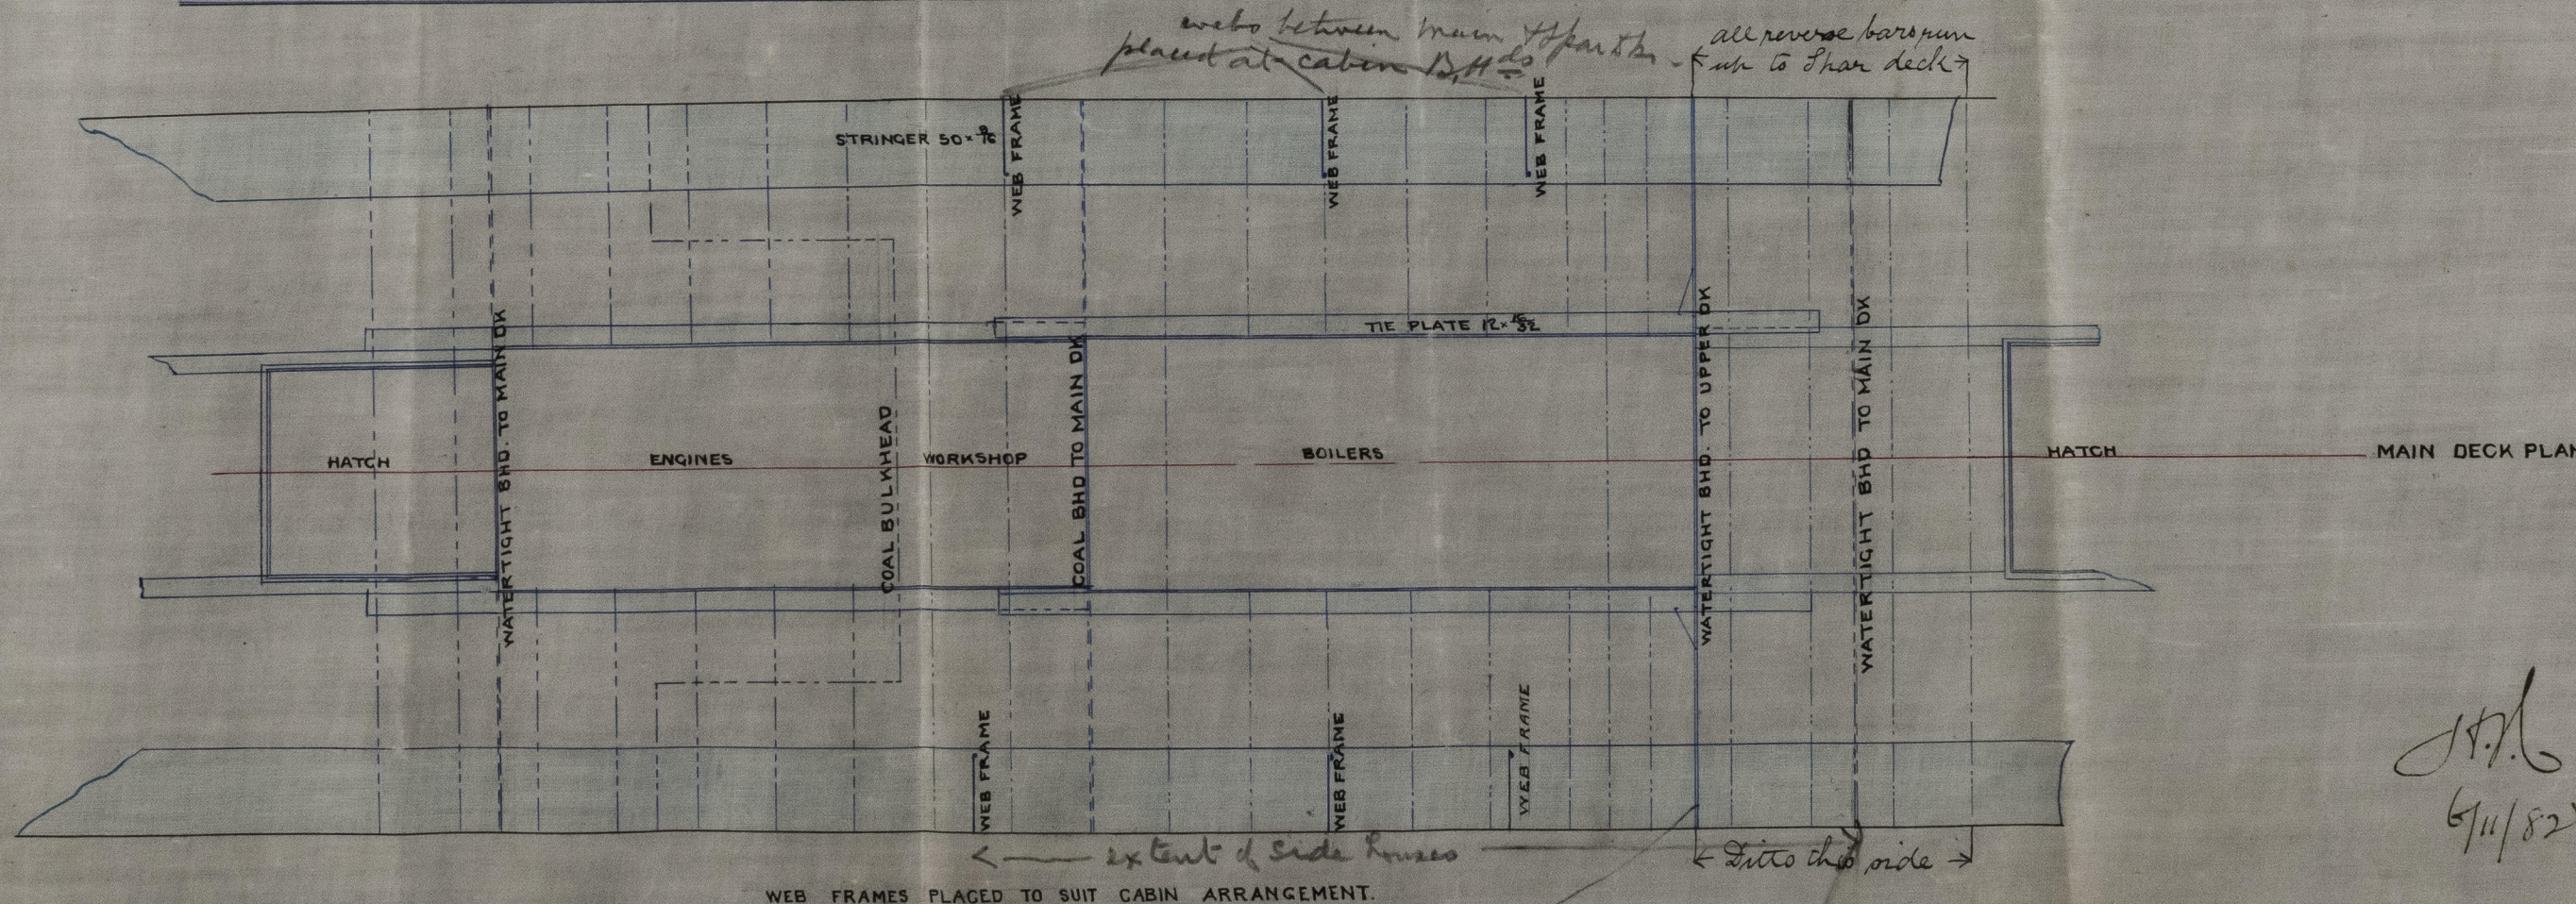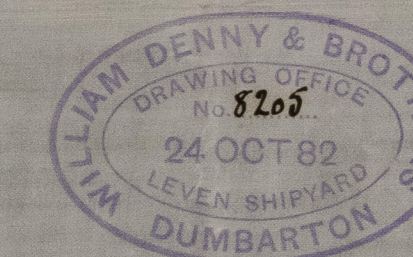

Web frames placed to suit cabin arrangement.
ex tent of side houses
into ship side
ex tent of boiler
see separate sketch
B.H. & spar deck



© 2021
Lloyd's Register
Foundation