


RECEIVED BY OUT.

Sh. to spec. 6/10/82



S.S. Owaro Maru  
Glasgow Report  
No. 6240

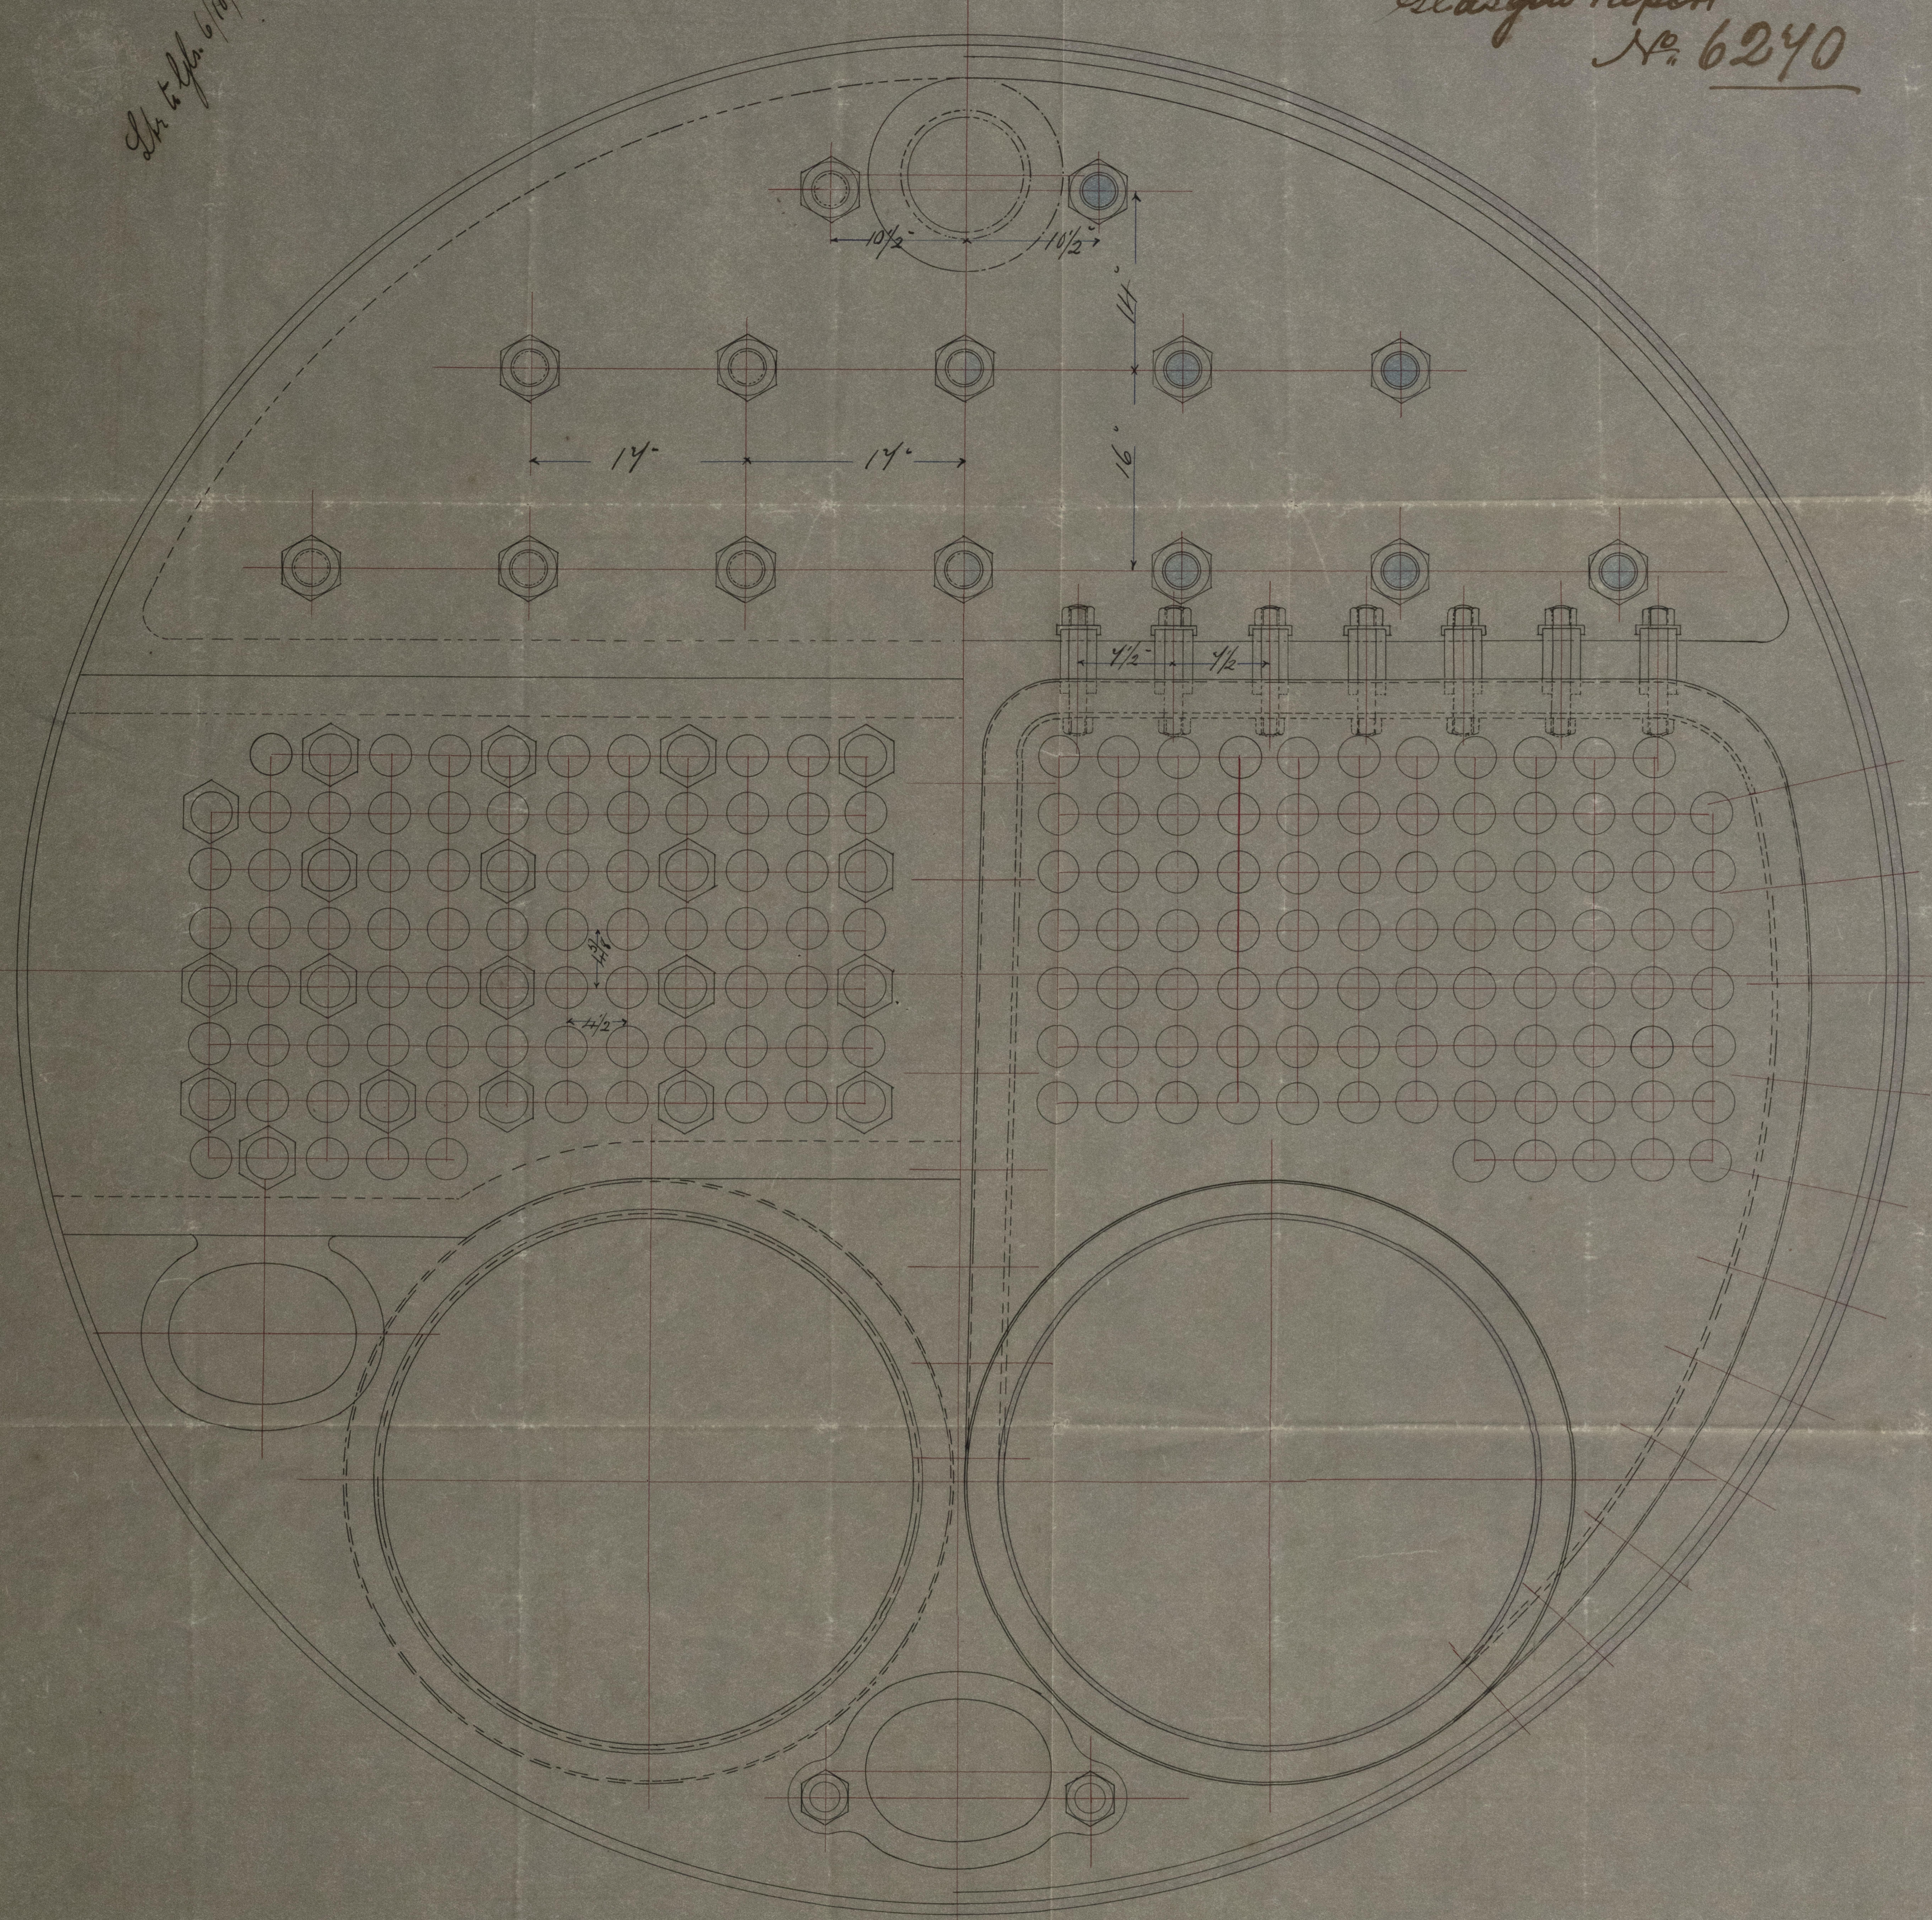

For 90 lbs working pressure.  
Boiler 16" dia Eng. No. 134  
Scale 1/2" = 1 foot Drawing 2709. 29 Sept 1882



MD  
6.10.82

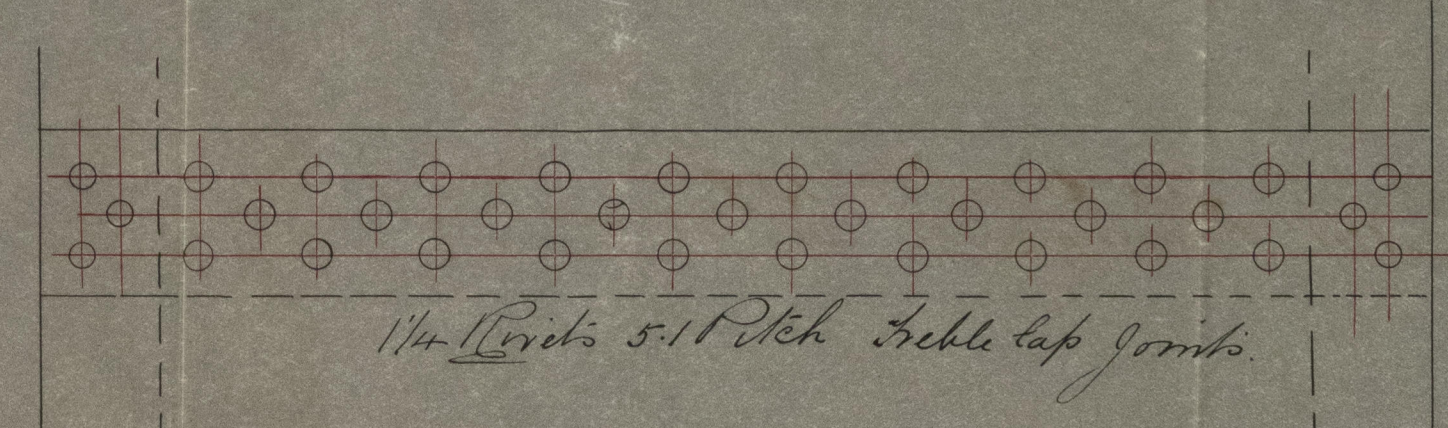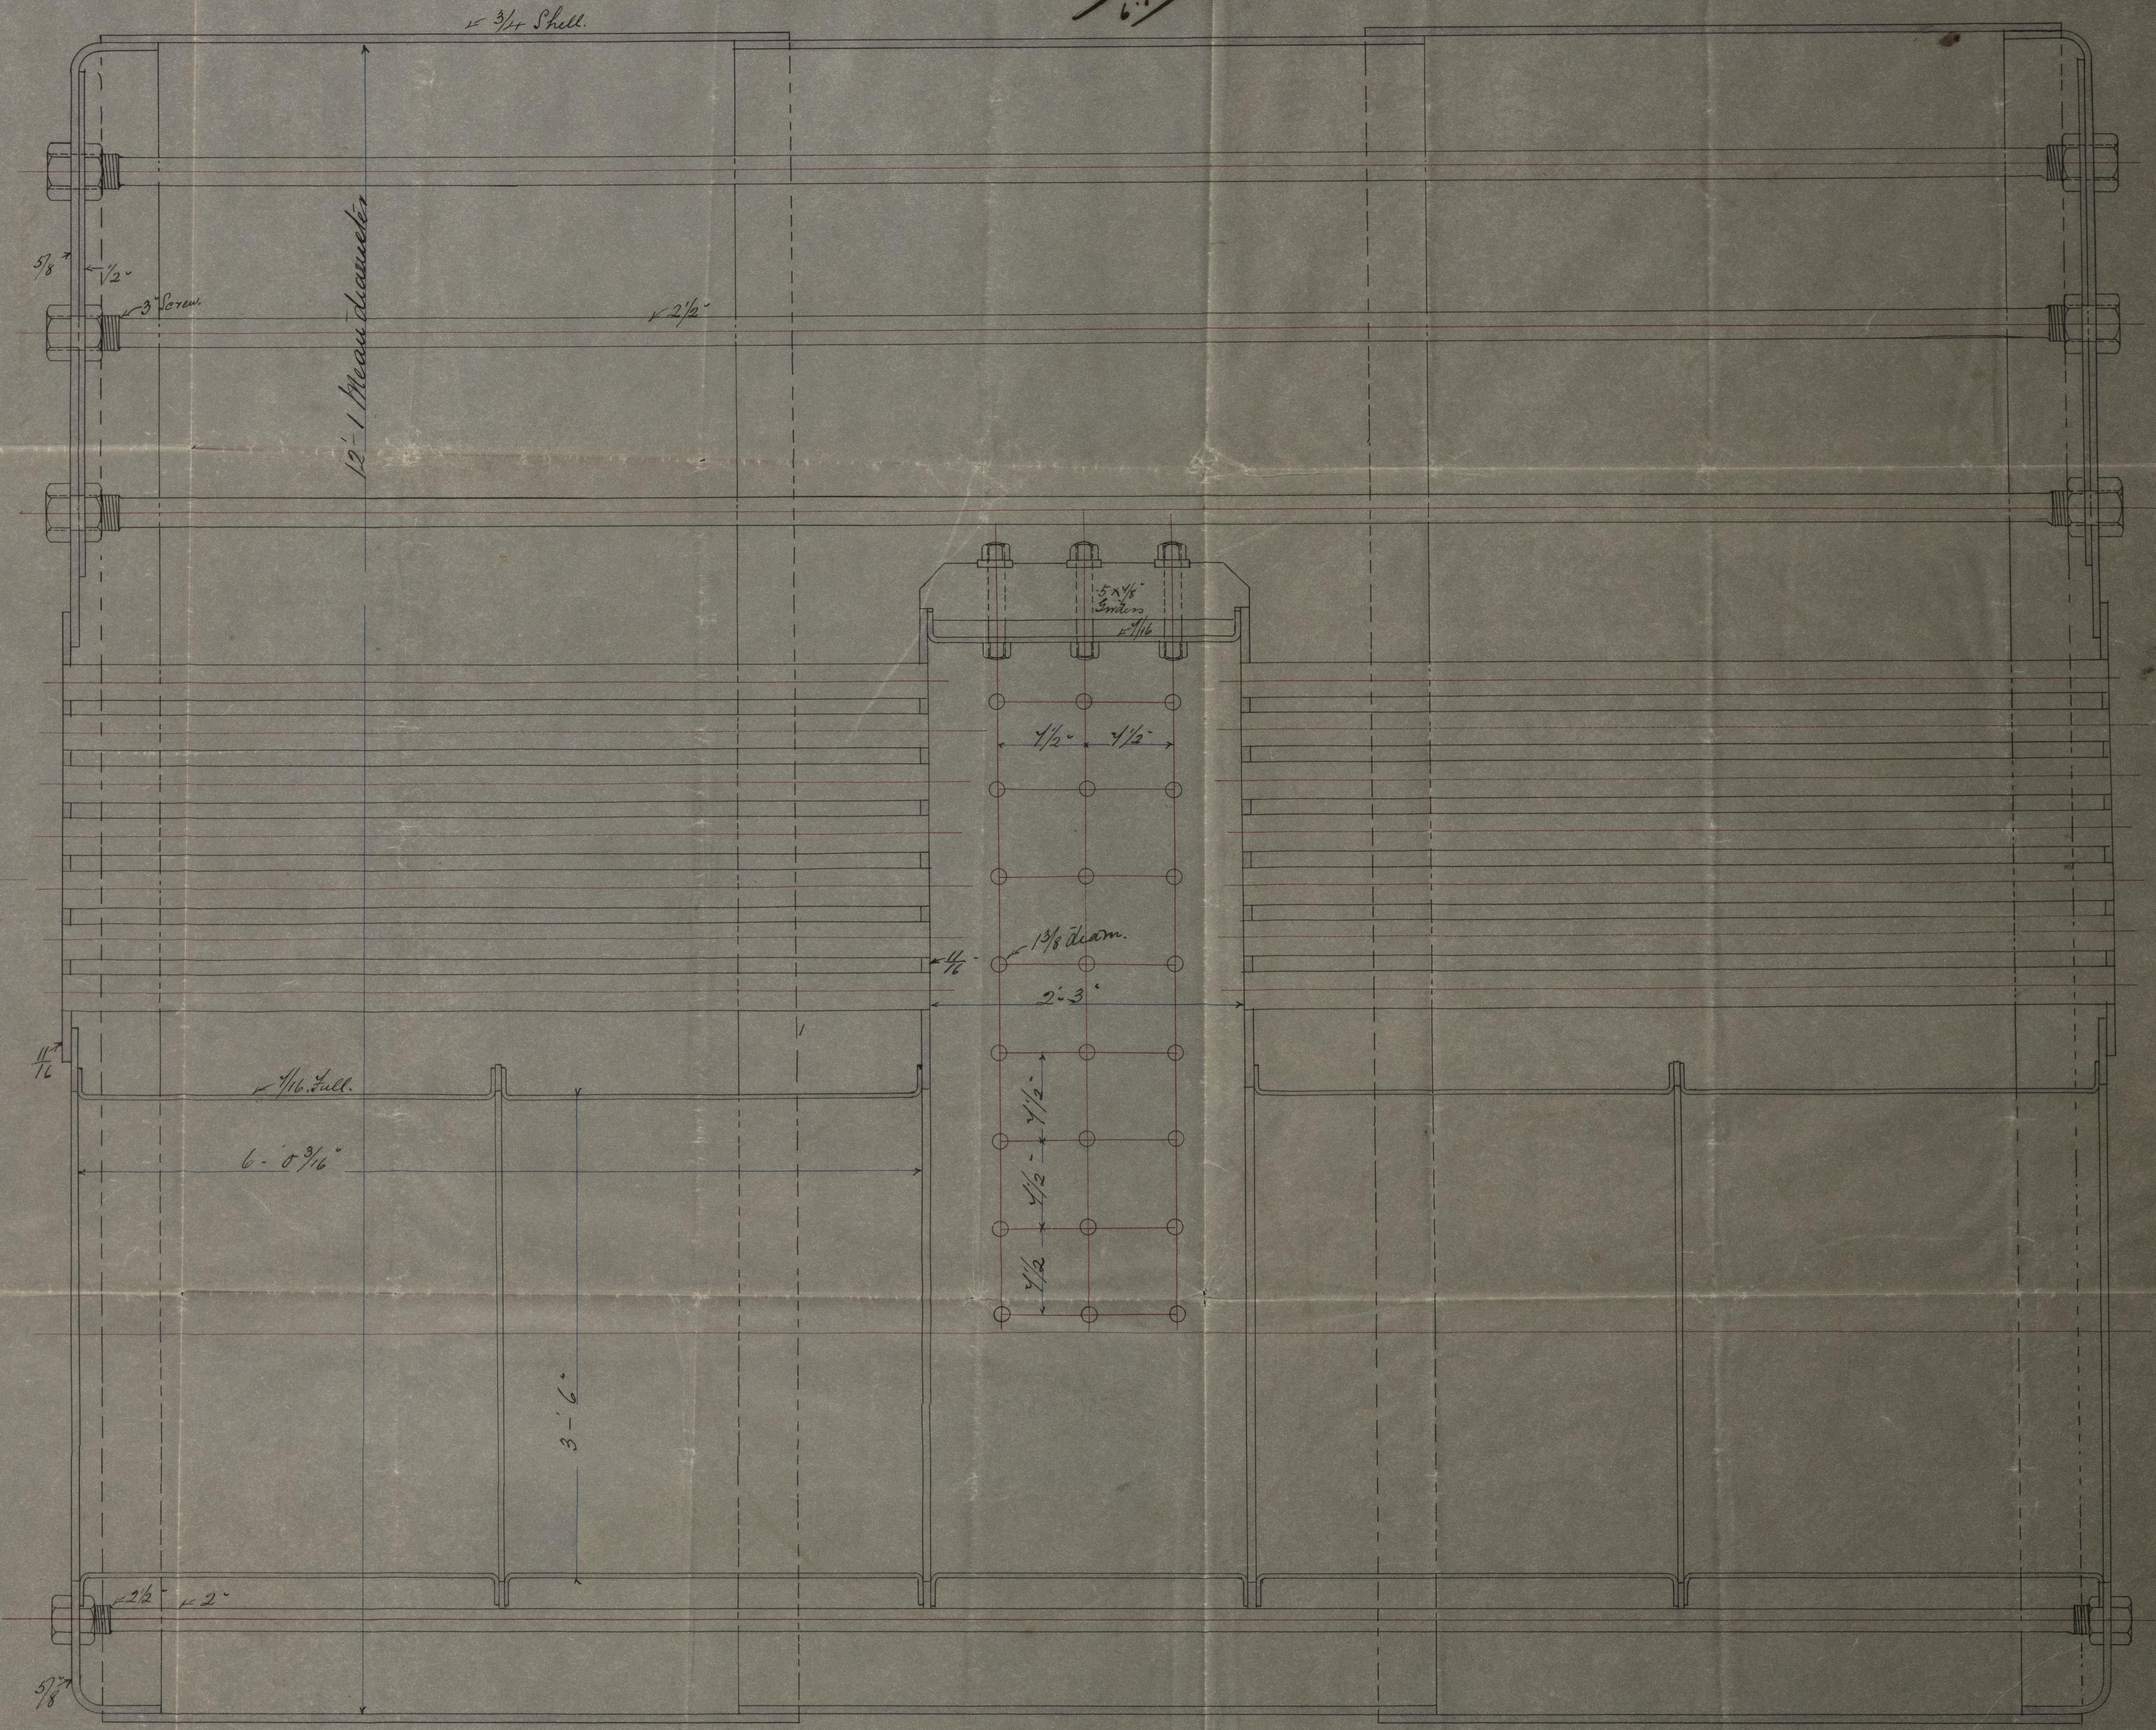

M Glasgow  
5.10.82

W. H. Howden



*L. M. L.*

