



L.R. 9/7/83

S.S. "Cwari Maru"
Glasgow Report No. 6240.

Pumping Arrangement S.S. No. 114
Scale 1/4" = One foot

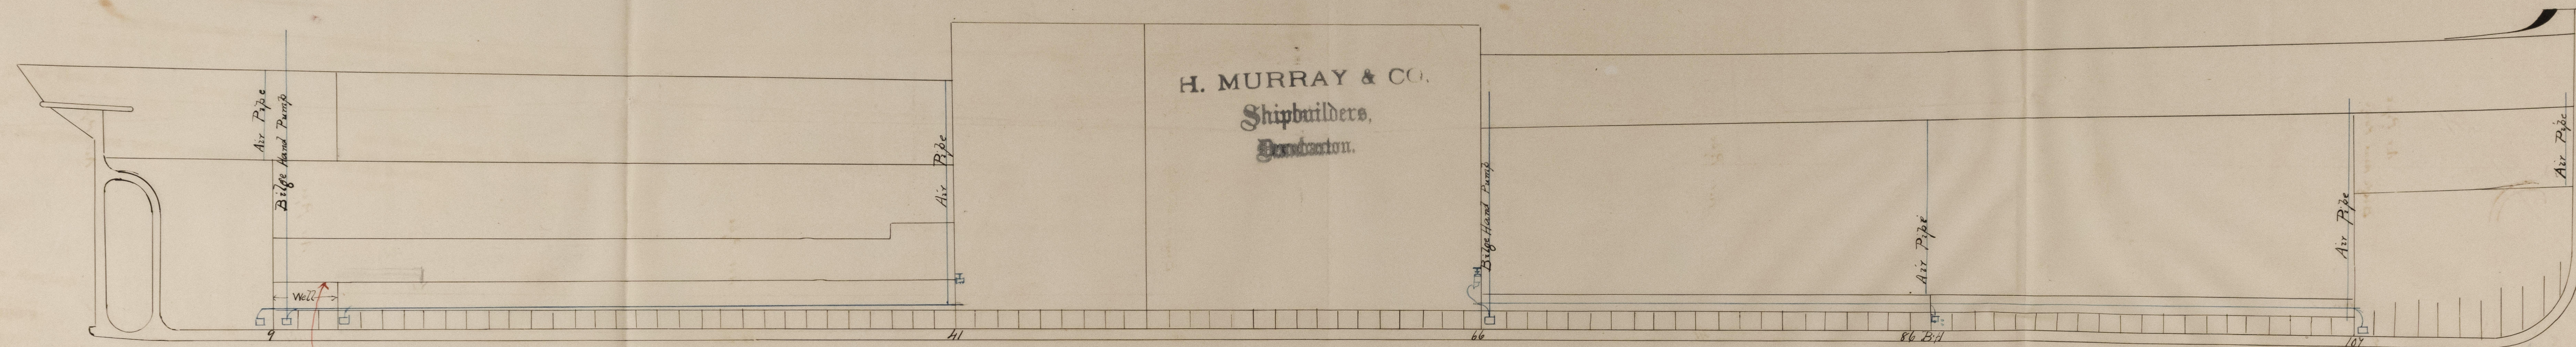

a suction to be fitted
at after end of tunnel
or drain to fitted therefrom.

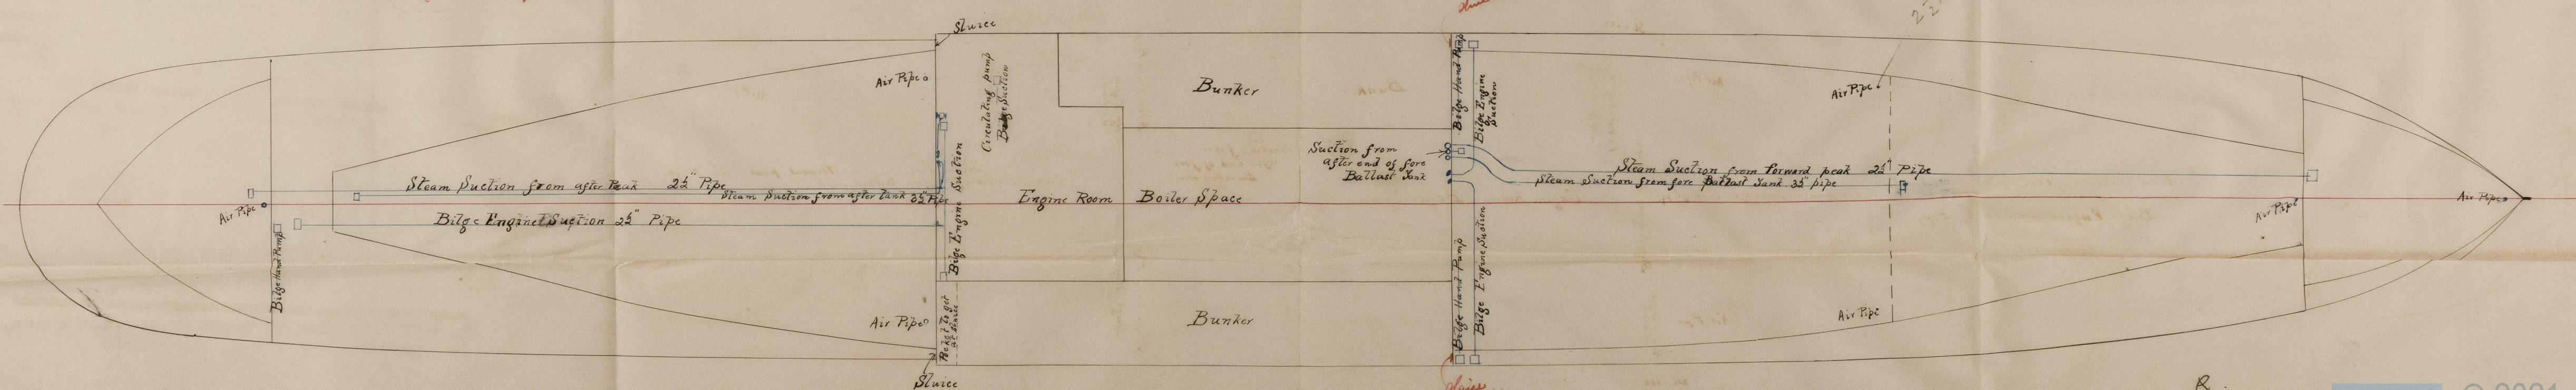

all air pipes 2 1/2" inside diameter.

D.S.
9/7/83