


# Lloyd's Register of British and Foreign Shipping.

(Received in the London Office,

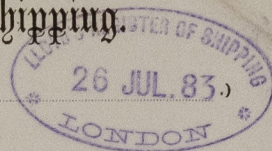

P.

No. 342

## REPORT ON SHIP FORGINGS.

Sir,

I beg leave to report that the undermentioned Forgings, manufactured by  
*Messrs Barclay & Co.* of *Newcastle*  
 for the Vessel No. *117*, being built by *Messrs Murray & Co.*  
 of *Dumbarton*. have been inspected by me in course  
 of being forged and smithed, and found to be, so far as can be seen, *sound*

Mark on Forging.

Lloyd's

No.

I am, Sir,

Your Obedient Servant,


*J. B. Cannon*

The Secretary,  
 London.

*Sunderland*

	STERN FRAMES.	RUDDER FRAMES.	STEMS.
Material* - - - -		<i>Scrap Iron</i>	
How made - - - -		<i>Forged</i>	
Dimensions - - - -		<i>5' x 3"</i>	
Progress on Inspection -		<i>Forging &amp; smithing</i>	
Dates when Inspected -		<i>May 30 June 8. 14. 20 July 6. 12. 13.</i>	

SKETCHES OF FRAMES SHEWING POSITION AND DESCRIPTION OF WELDS.

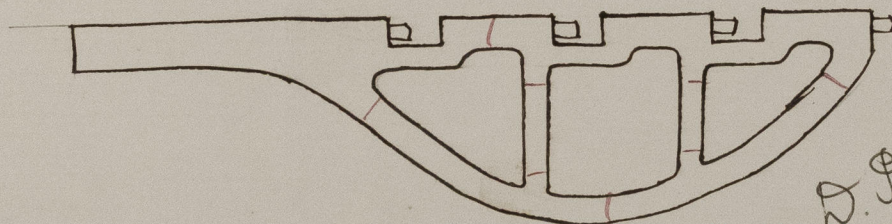

*Welds in Red*

*D. J. 26/7/83*

Lloyd's Register  
 Foundation