

RECEIVED 184832.44.
RECEIVED 184832.44.

S.S. "Owari Maru" Glasgow Report No. 6270.

HALF MIDSHIP SECTION. S.S. No. 117

Scale 1/2" = One foot.

Assume Coeff. 17.77


Moned depth 16'4"

Lt. H. Glasgow
20/10/82
15/5/83 23/5/83.
28/6/83.

Breadth in Length 6.97
Depth in Length 12.71
Depth 16.91
Half breadth 15.41
" Girth 28.38
60.70 Frame No.
215
303 50
607 0
12140
13050.50 Plating No.
1305.5
14336.00 Equipment

2/15 = 6.97

J. MURRAY & CO.
Shipbuilders,
Dumbarton.

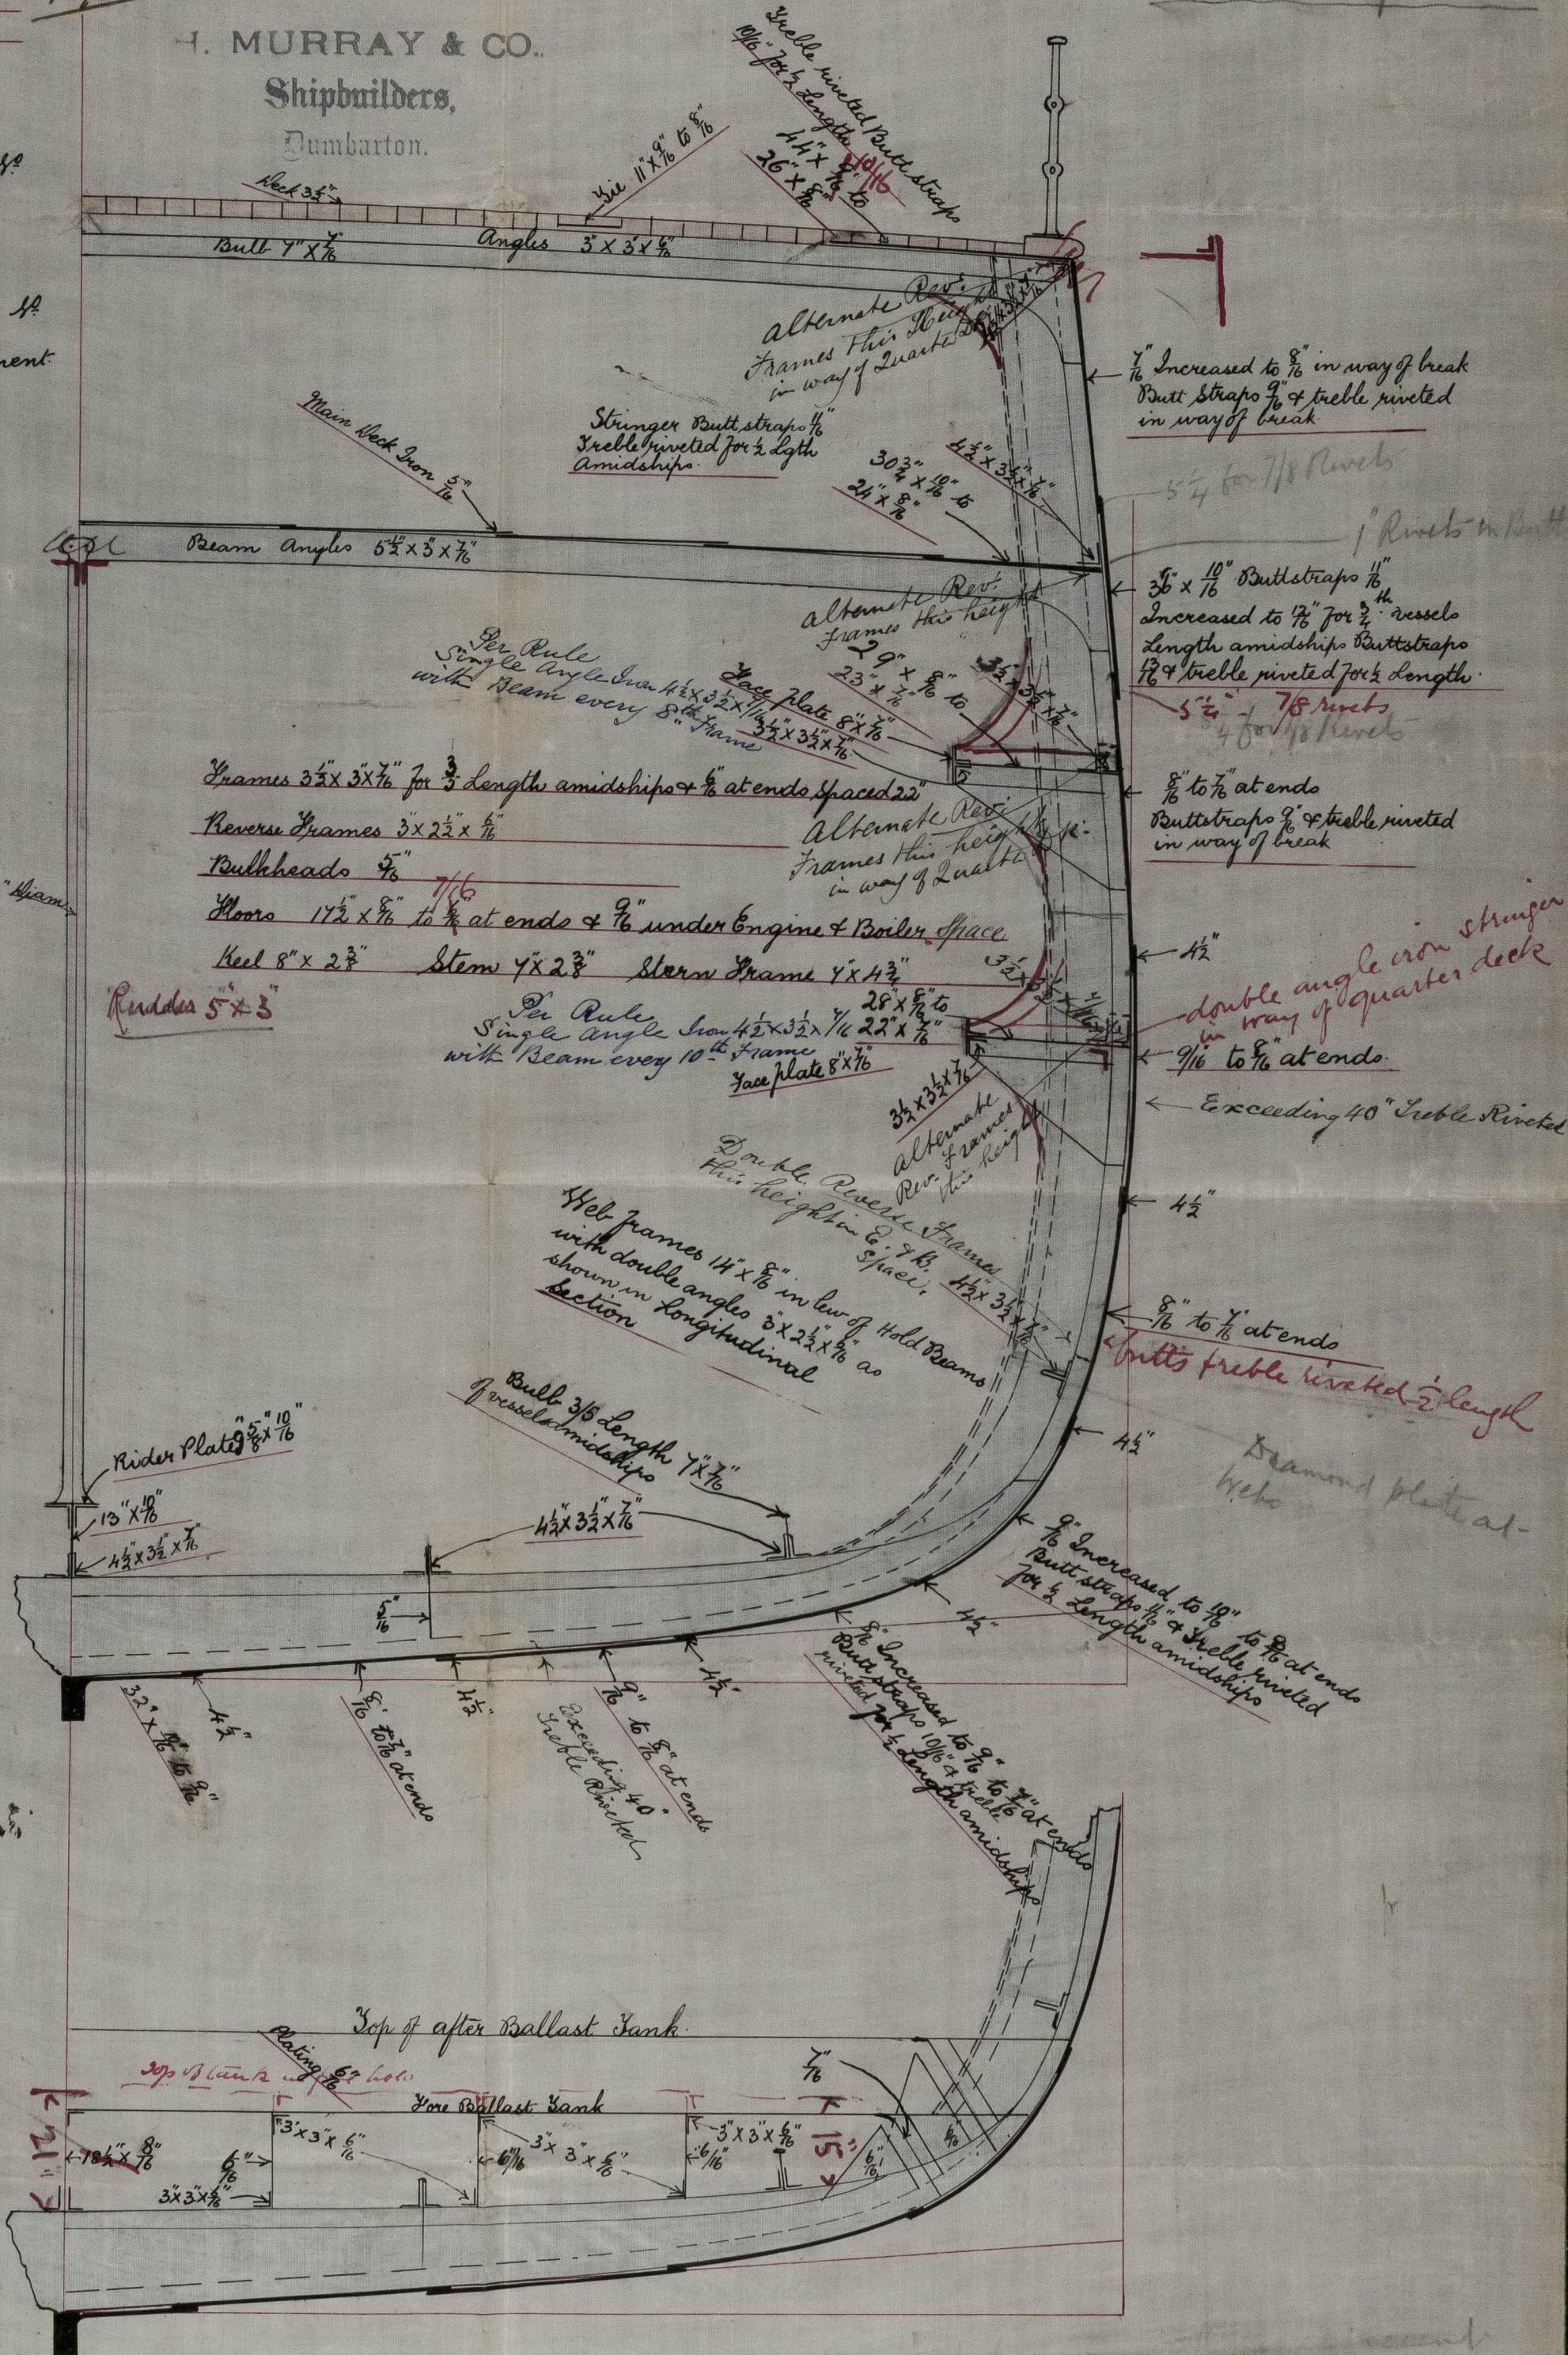

Raised Quarter Deck No.

Depth 21.41
Half Breadth 15.41
" Girth 32.88
69.70
215
348 50
6970
13940
14985.50

Depth in length under Raised Q. No. 10.042

Equipment

Anchors	Cut
2 Bowers Ex Stock	18
1 " " "	15 1/2
1 Stream " "	6 1/2
1 Hedge " "	3 1/2
1 " " "	1 1/2

Chains etc.

Cable 240 Fathoms	1 1/2"
Stream 60 "	1 1/2"
Line 90 "	9 1/2"
Hook 90 "	7 1/2"
Harpe 90 "	5 1/2"

J.H. Glasgow
19/10/82