


S. S. "Tongariro" Glasgow Report No. 6291

Lloyd's Register of British and Foreign Shipping

(Received in the London Office,

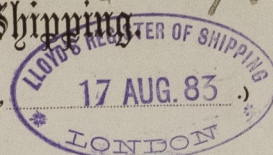

P.

No. 84

REPORT ON SHIP FORGINGS.

Sir,

I beg leave to report that the undermentioned Forgings, manufactured by Messrs J & W. Beardmore of Glasgow for the Vessel No. 280, being built by Messrs John Elder & Co of Glasgow have been inspected by me in course of being forged and smithed, and found to be, so far as can be seen, sound and efficient

Mark on Forging.

Lloyd's

No. 84

G.N

The Secretary,
London.


I am, Sir,

Your Obedient Servant,

George Newcomb
Glasgow

	STERN FRAMES.	RUDDER FRAMES.	STEMS.
Material* - - - -	/	Scrap iron	/
How made - - - -		Forgeed	
Dimensions - - - -		8 1/2 x 4 to 6 x 4 1/2	
Progress on Inspection -		Forgeed and smithed.	
Dates when Inspected -		10.27/5/83. 2.15.22/6/83. 3/7/83 2.7.11/8/83.	

SKETCHES OF FRAMES SHEWING POSITION AND DESCRIPTION OF WELDS.

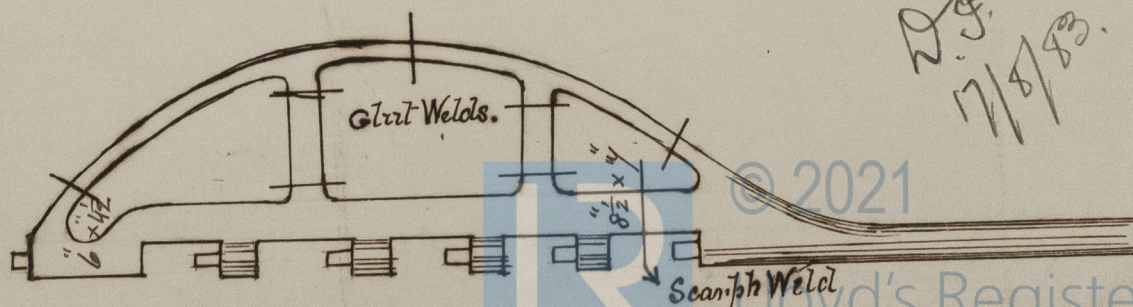

* If of iron, state whether scrap or puddled iron.