


RECEIVED 14 DEC 82.
RECEIVED 15 DEC 82.
RECEIVED 15 MAY 83.


Let to Gls.
7/12/82
21/12/82
24/5/83

Rev. frs. add. to open sk.

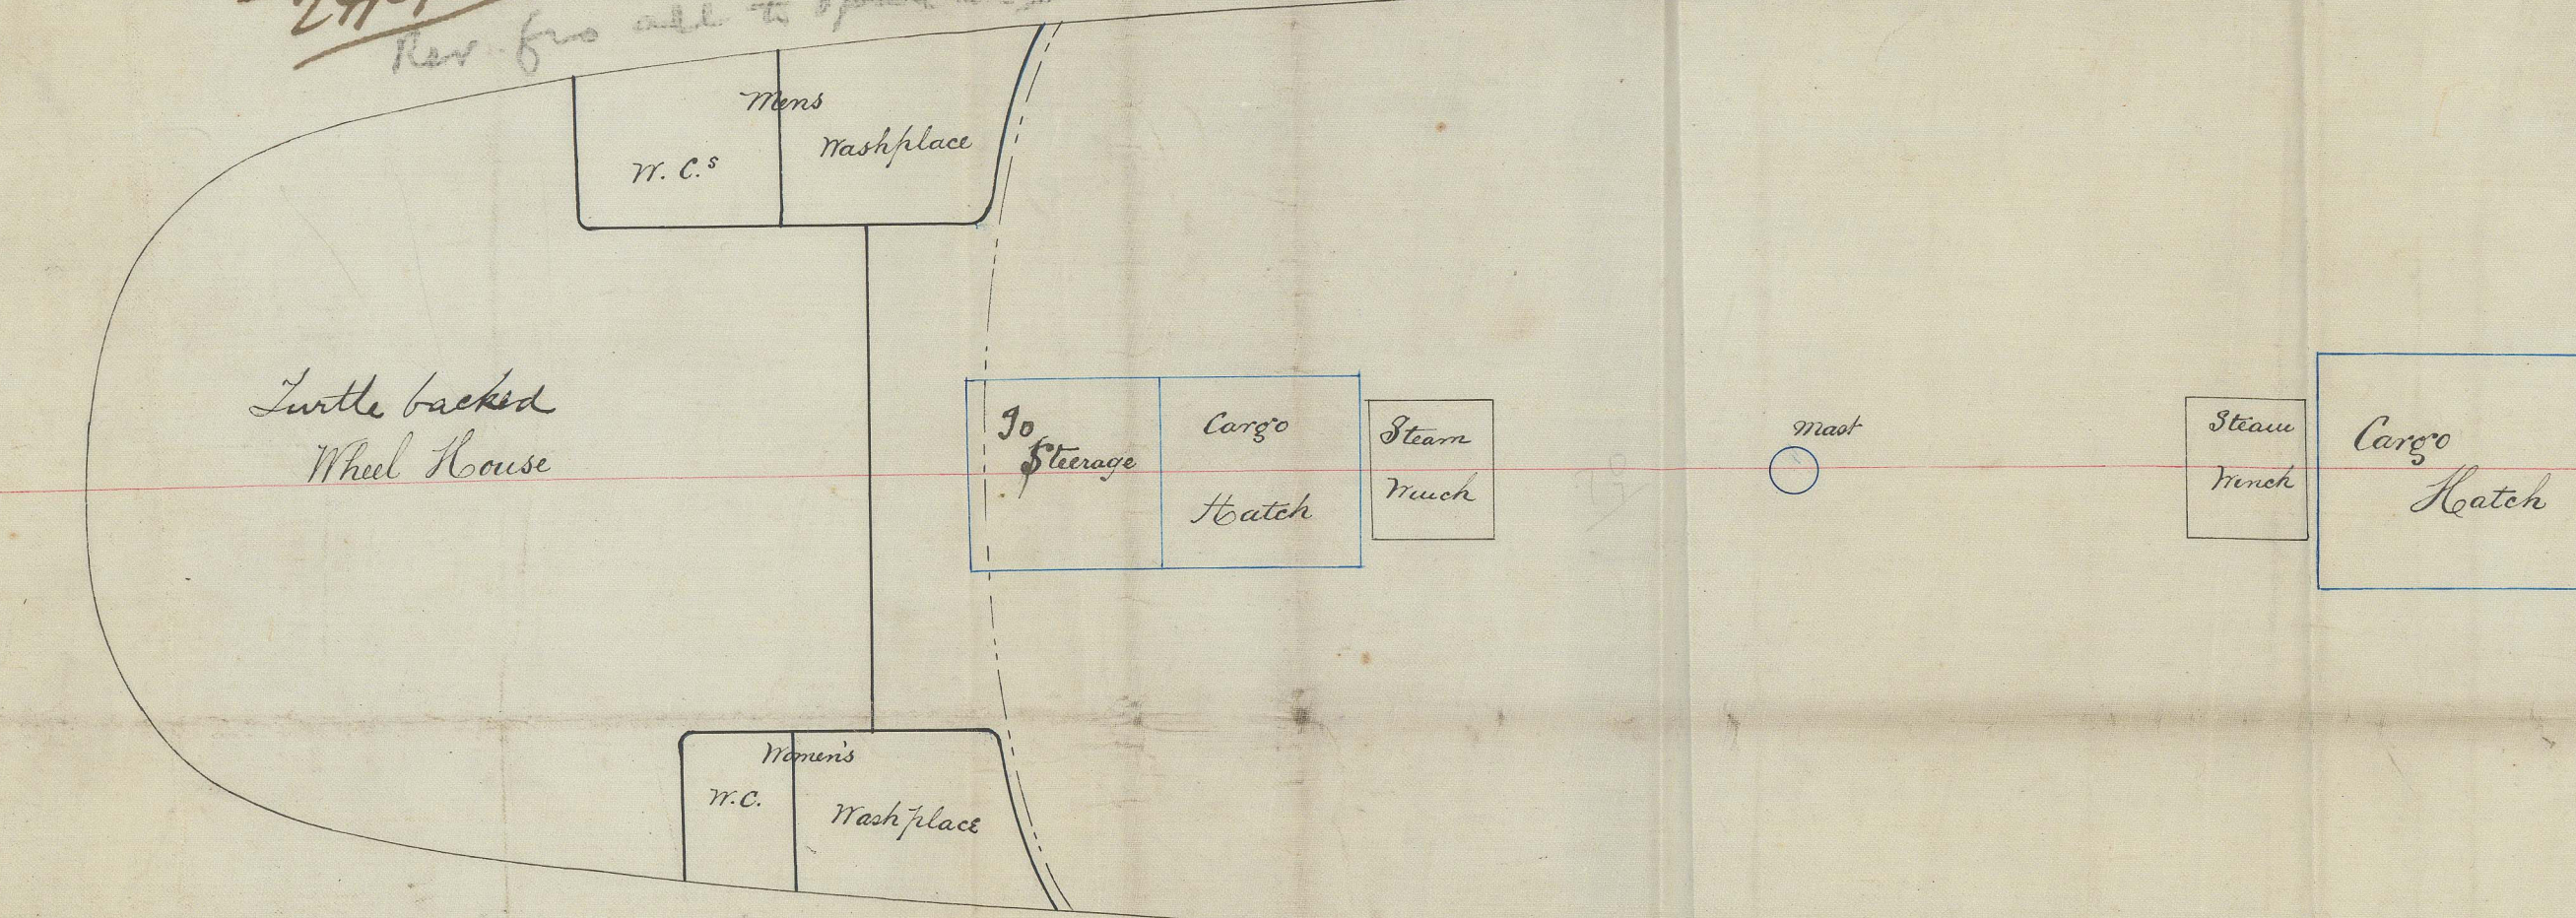

JOHN ELDER & CO.,
Shipbuilders and Engineers
GLASGOW.

← Reverse frames all to open sk.

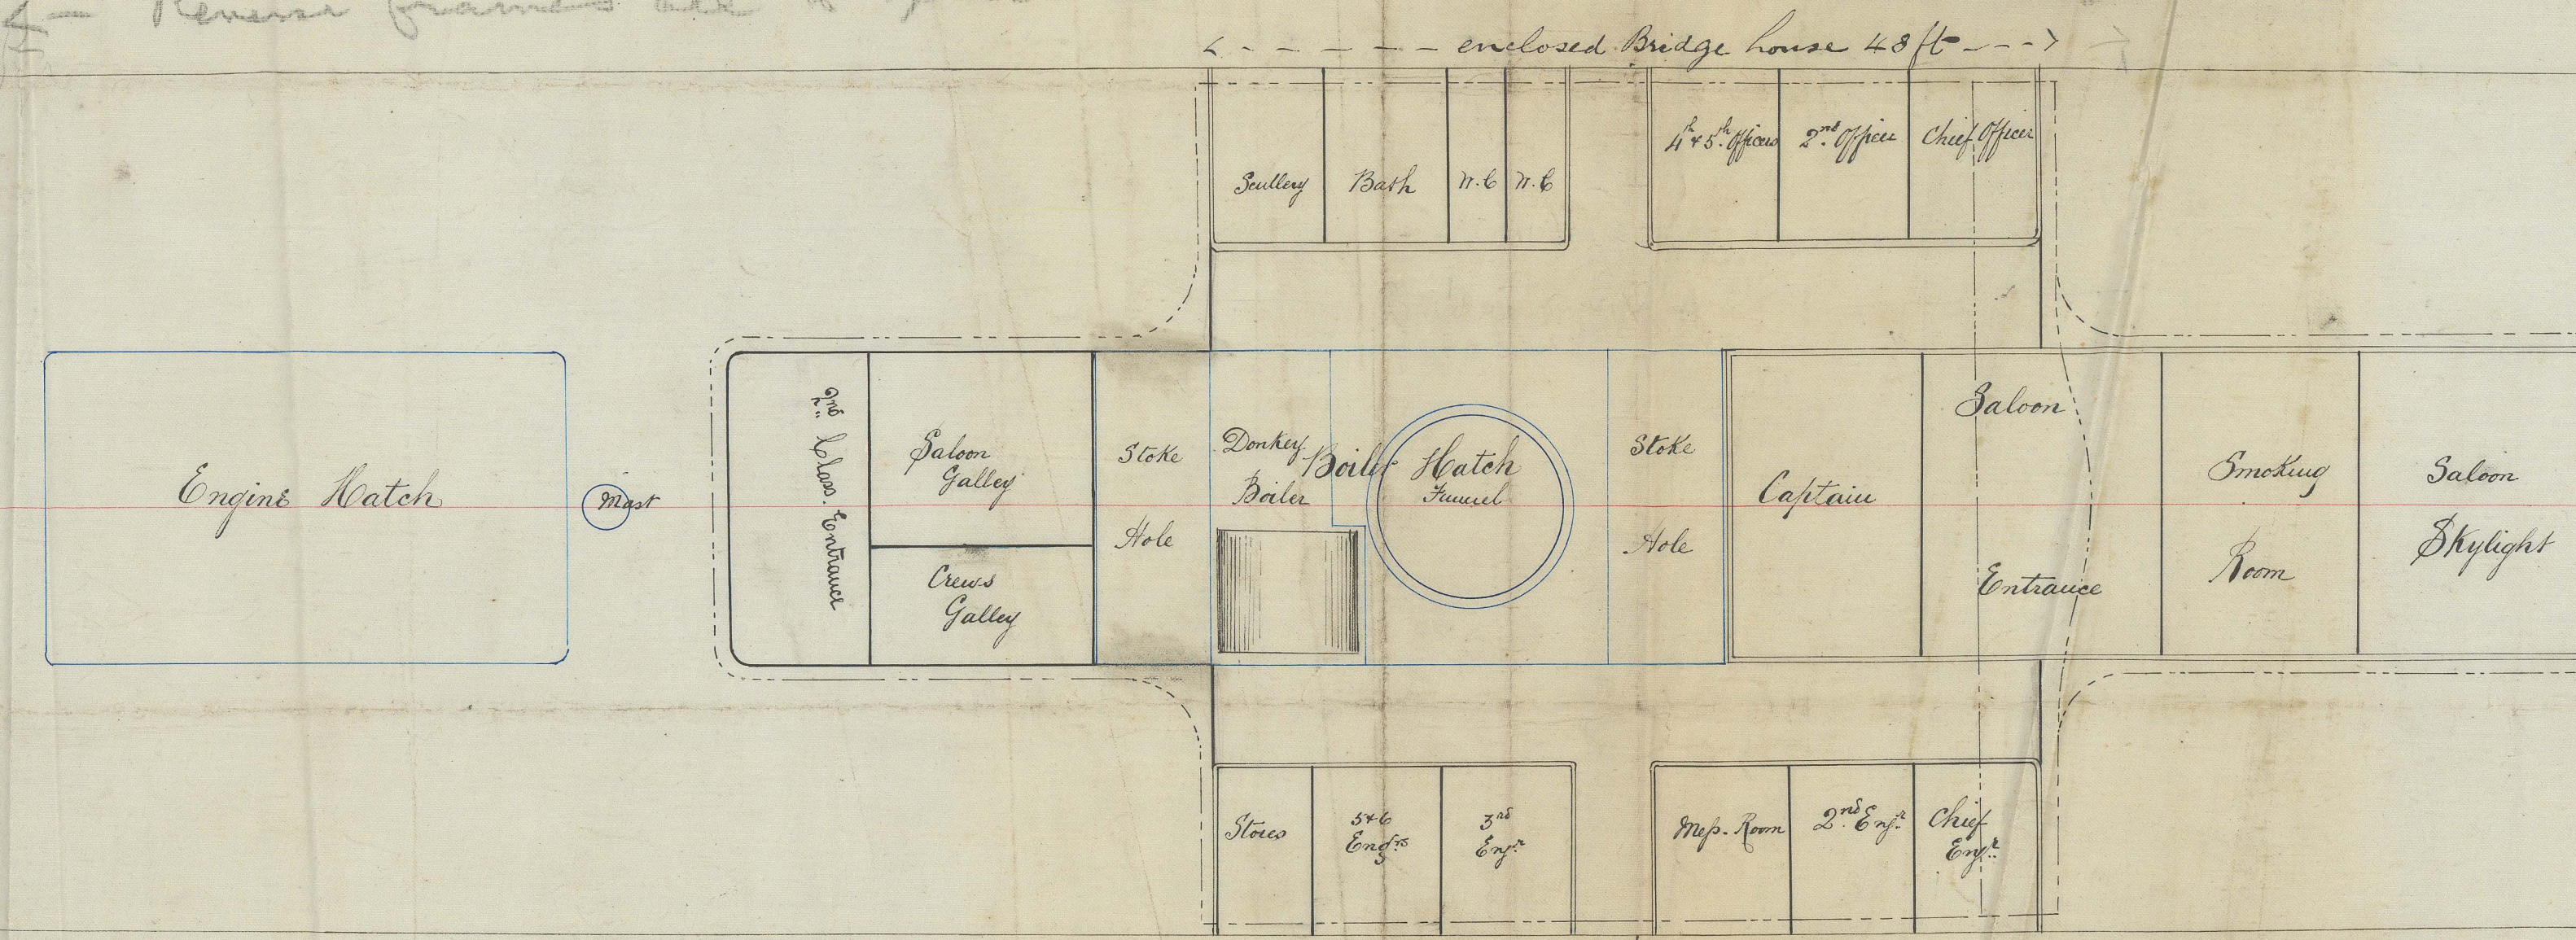


Plating to hatch.

S.S. "Tongariro" Glasgow Report No. 6291.
S.S. "Aorangi" do do 6329.
S.S. "Ruapehu" do do 6344.

SPAR DECK PLAN
SCALE 1/8 INCH-ONE FOOT.
No. 280 1 & 2

← Rev. frs. all to open sk.

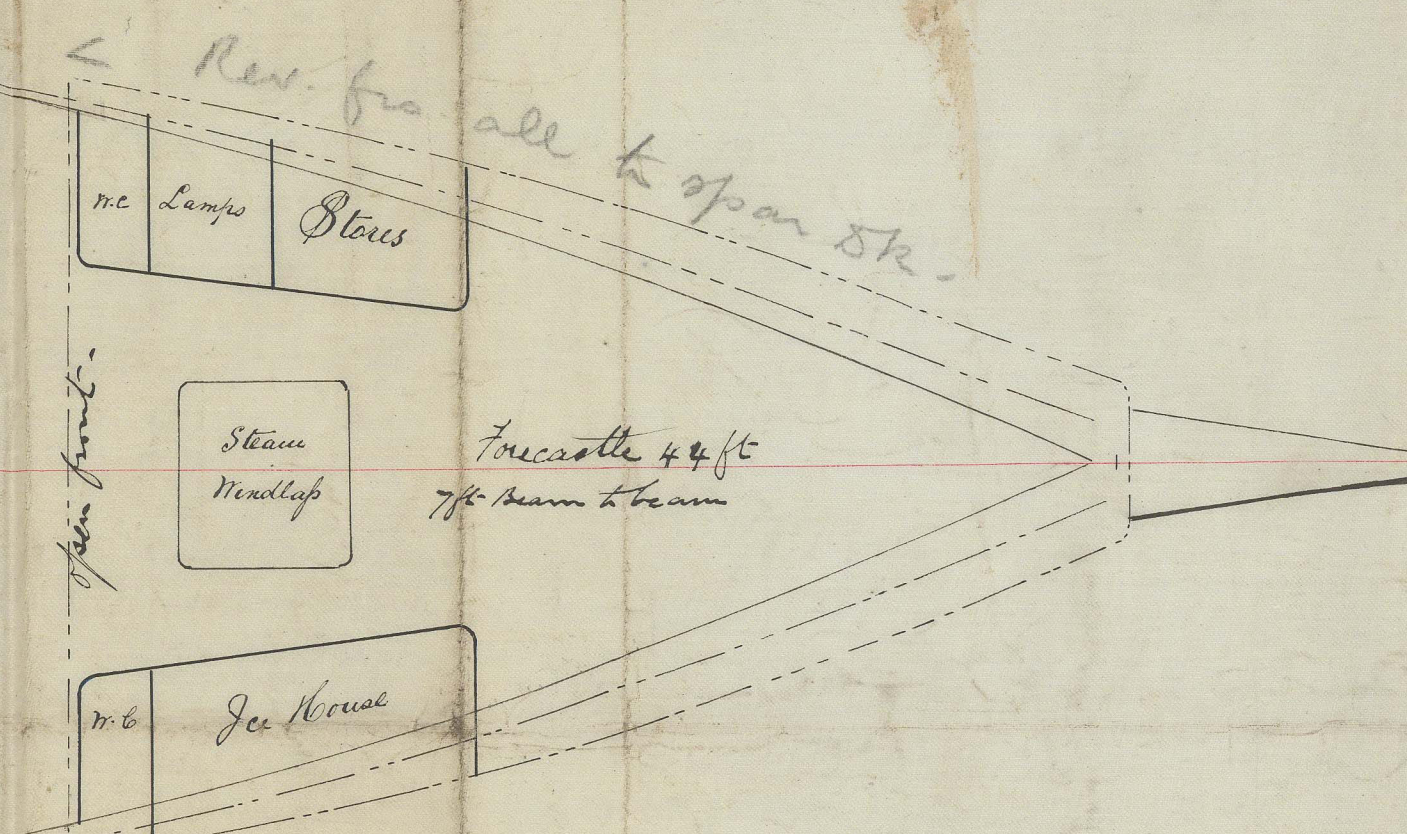

6/12/82

