

[illegible]

Dr. & Ges:
1/5/82



2/5/92

Ship No. 176- S. S. "Moravia"
BOILERS No 372 Glasgow Report
ENGINES No 265 No 6295

WORKING-PRESSURE=85 LB_S/IN²

Steel plates

SCALE OF 1 INCH TO 1 FOOT

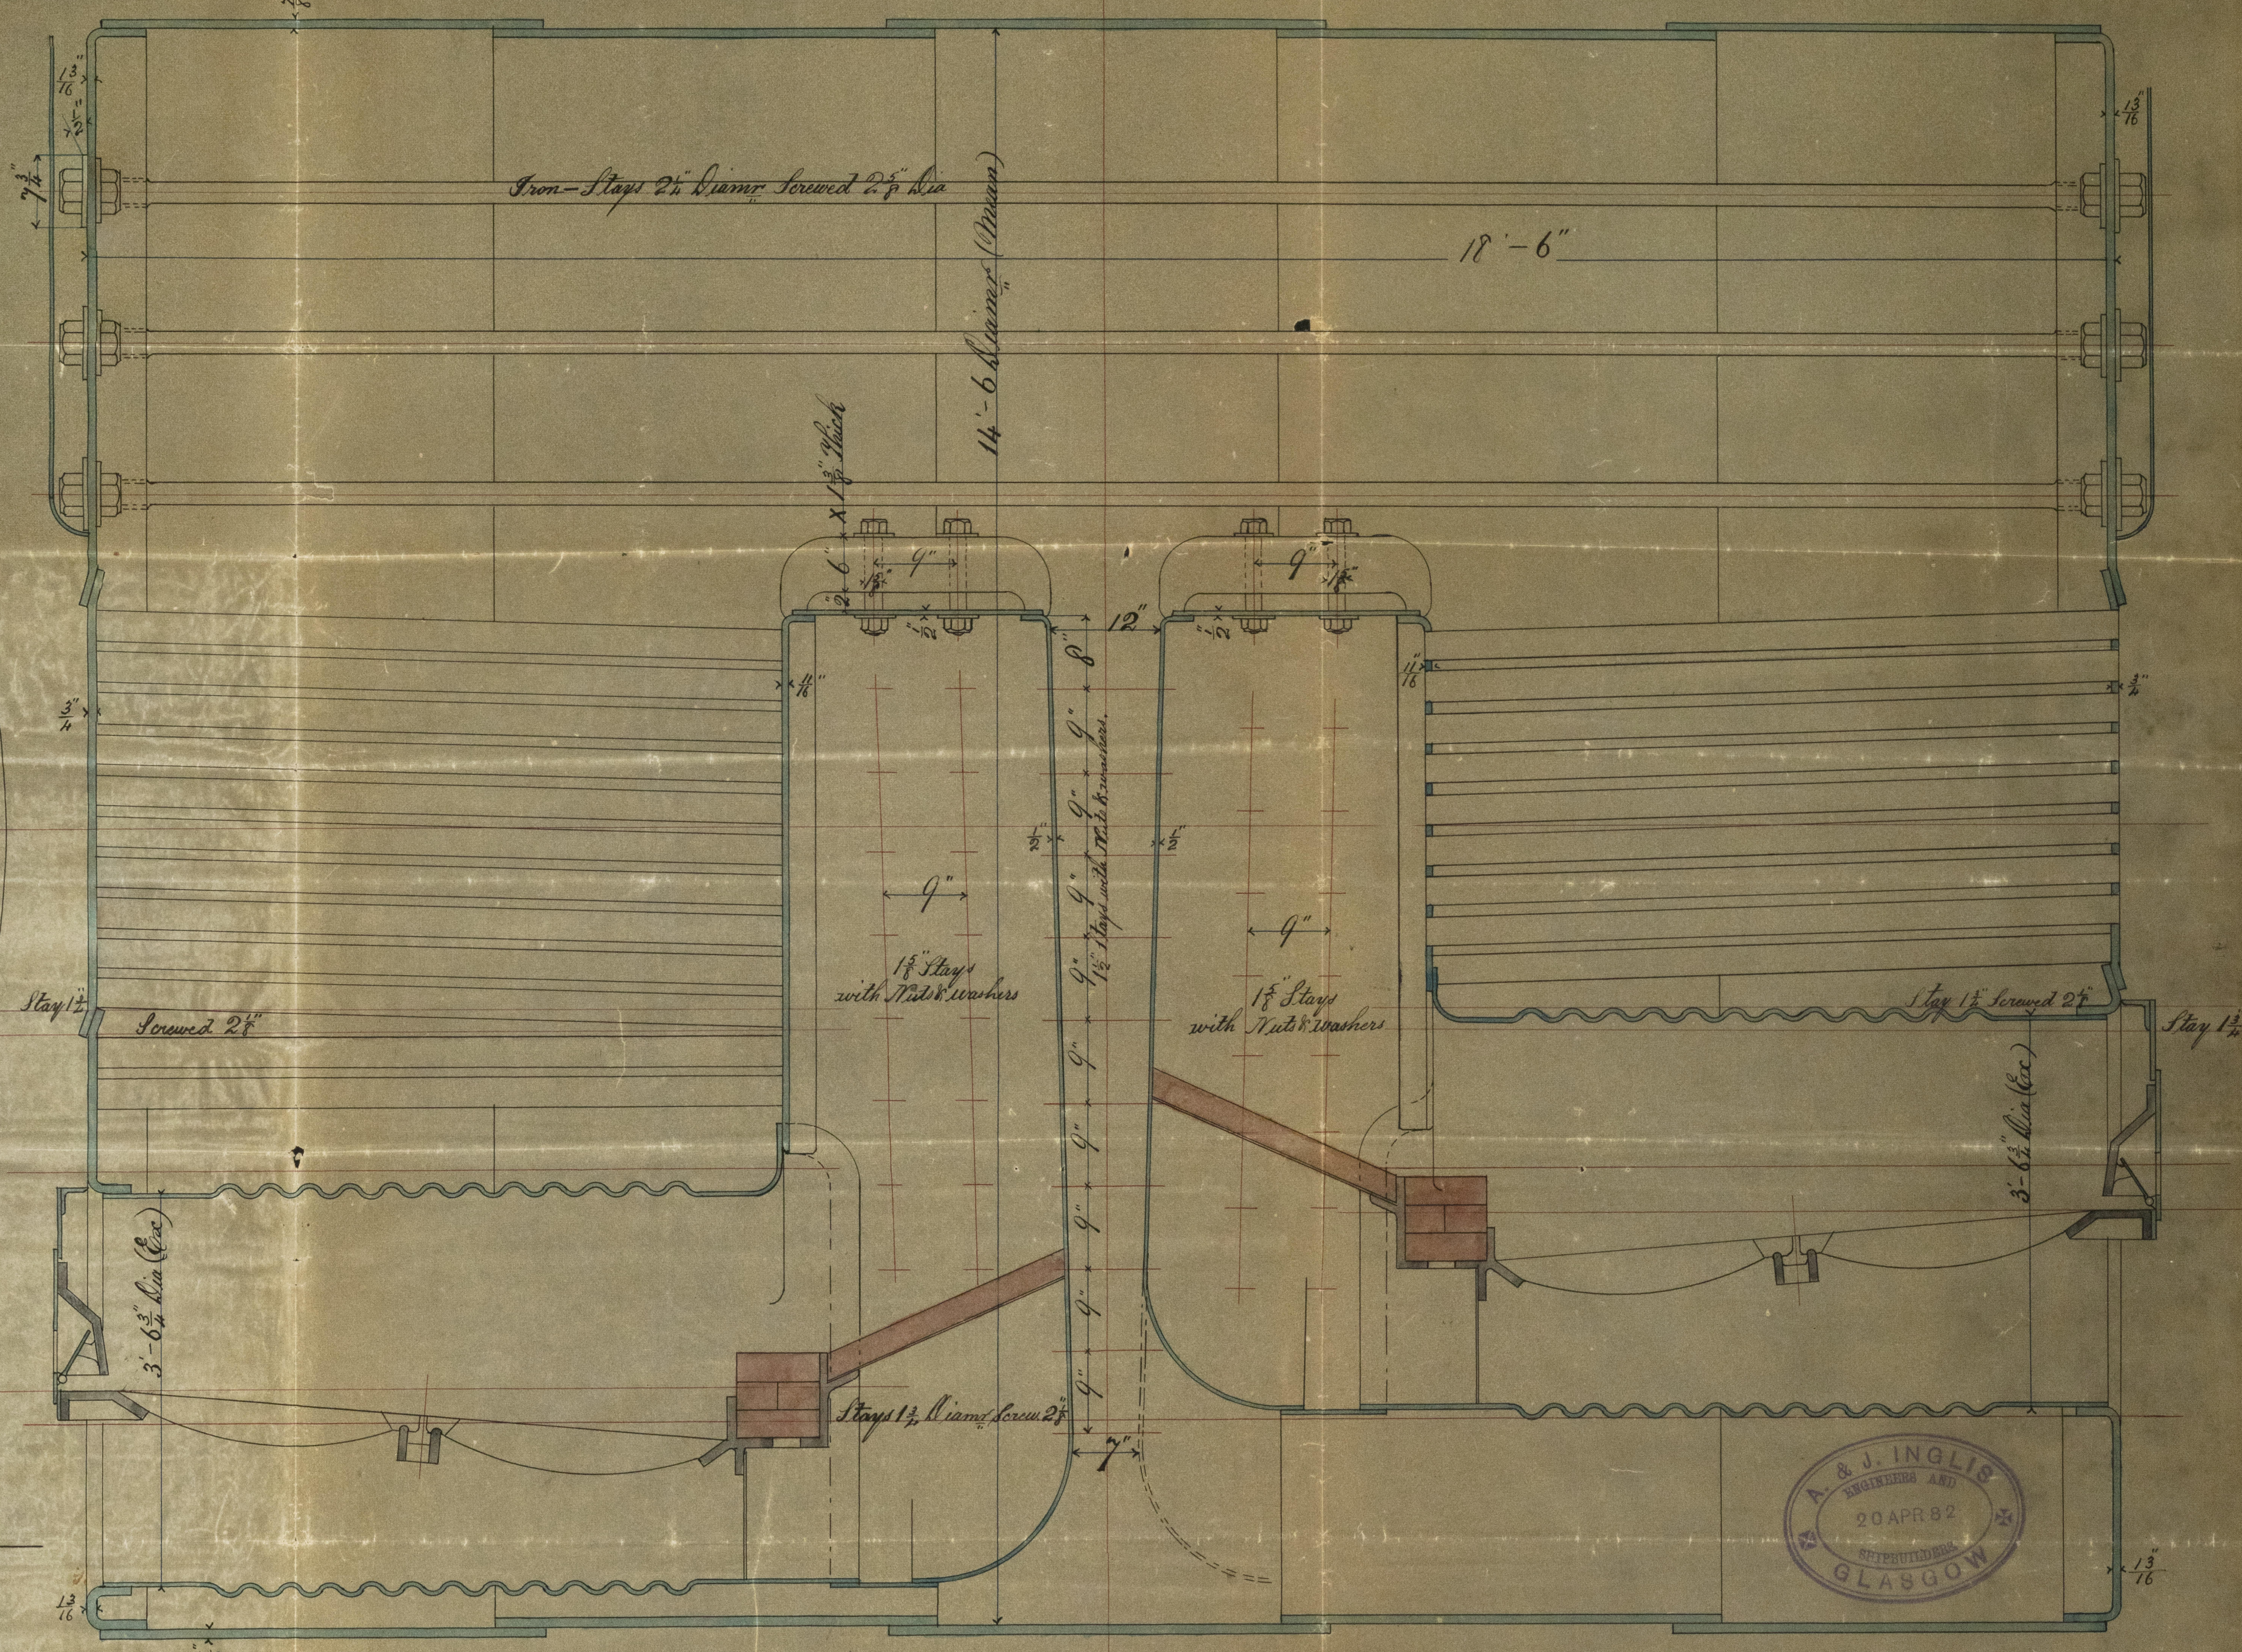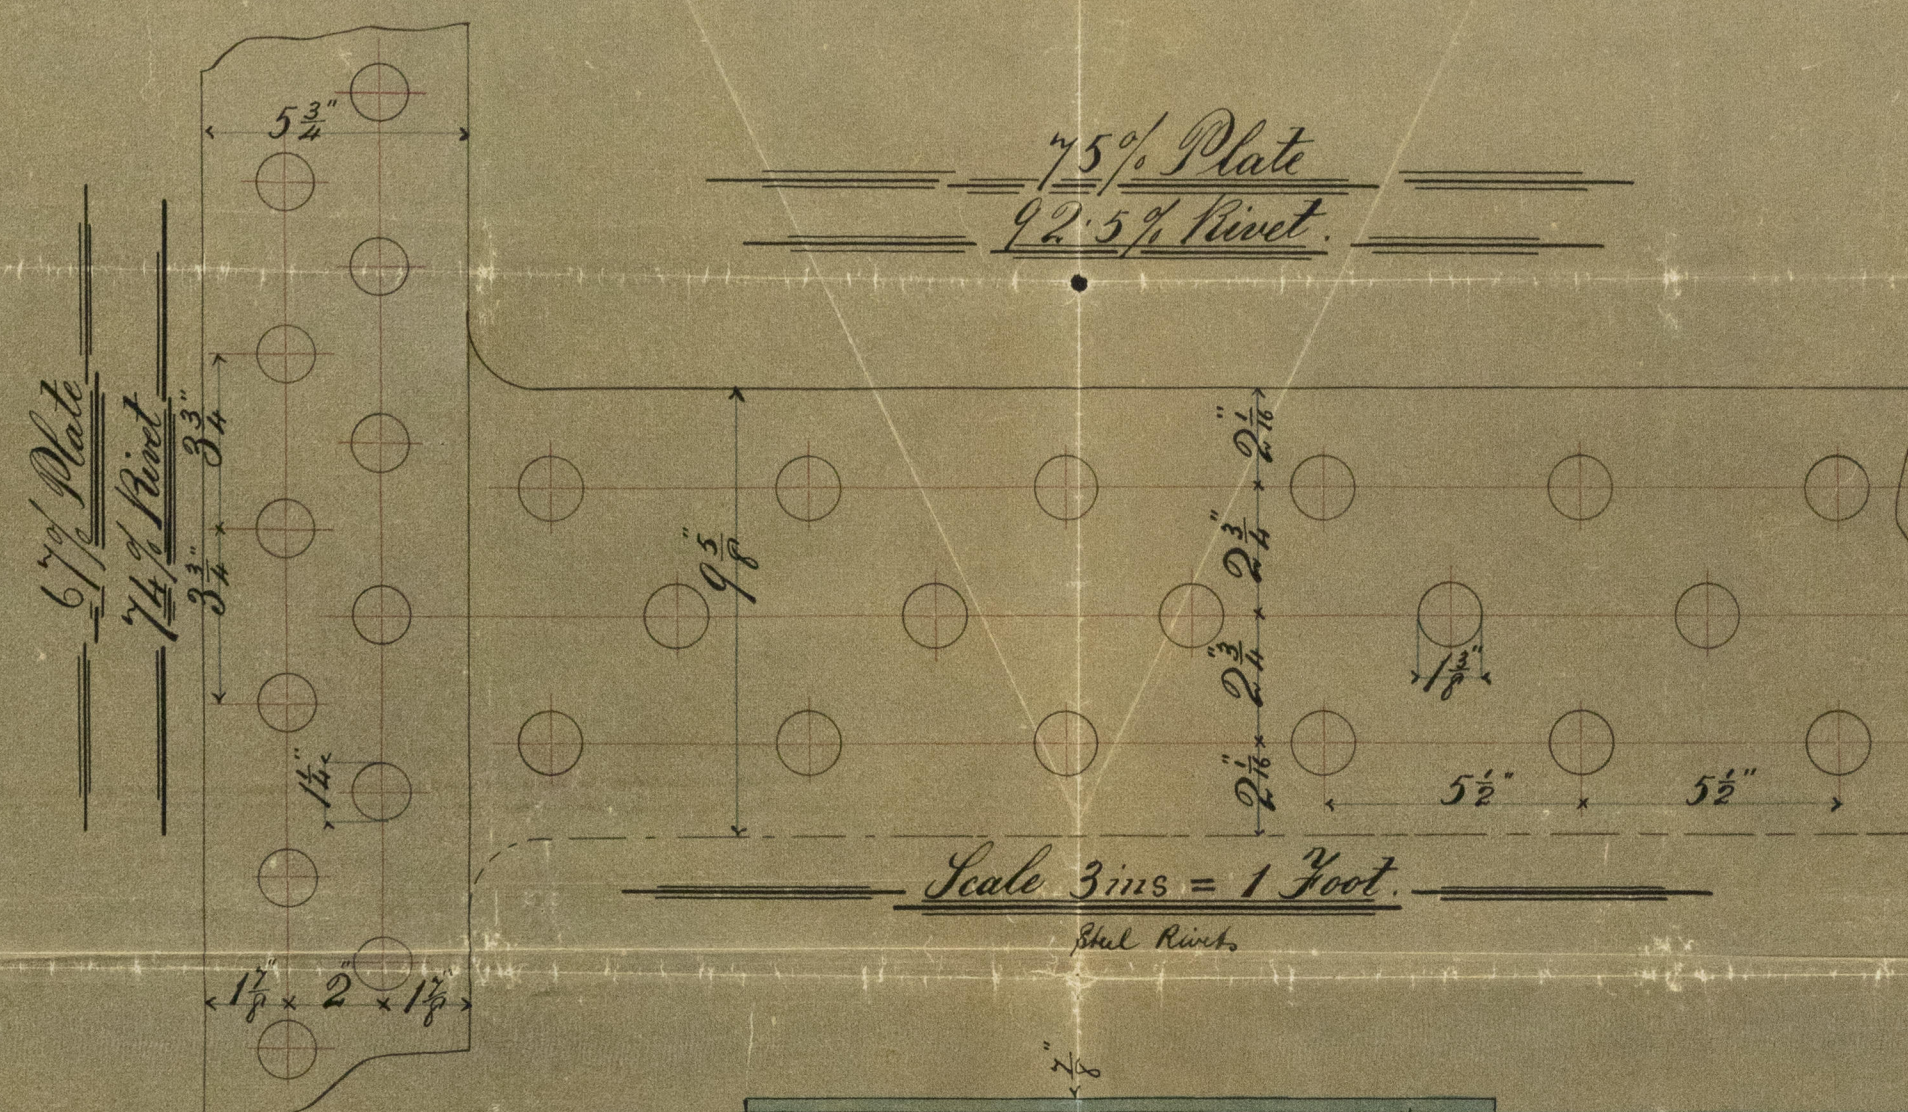


All Steel.

Amey.
1/5/82 Clyde District

At Syles S.S No. 176

Steel main process No 372

Cymei No 265 May 1st 1882

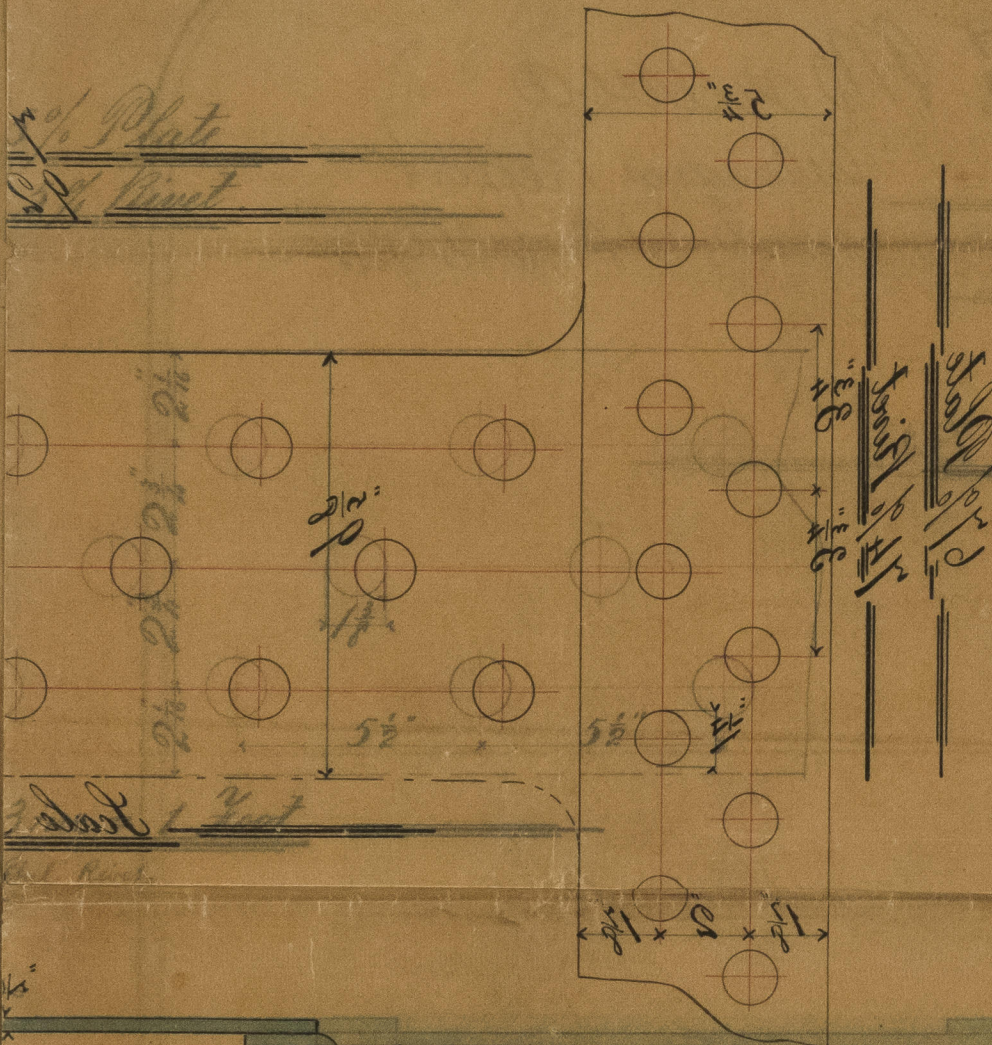

GLS196-0061

