


Ans: S. G.
23/3/83.

Longitudinal Section & Upper deck plan. No 176 S.S. "Moravia" Glasgow Report No 6295.
Scale 3/8 inch = one foot.

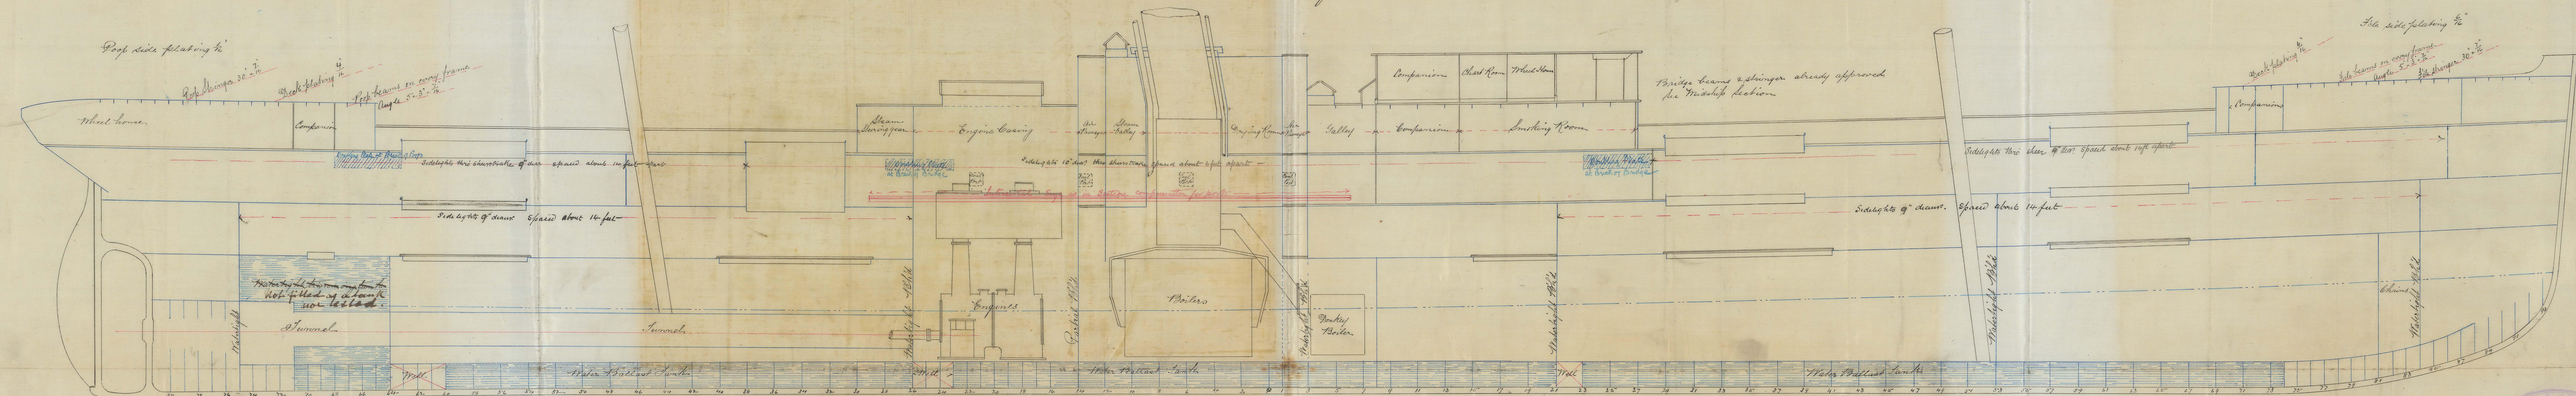

A. & J. INGLIS
ENGINEERS AND
MAR 17 83
GLASGOW

