

P.

No. ✓

REPORT ON SHIP FORGINGS.

Sir,

I beg leave to report that the undermentioned Forgings, manufactured by The Kelvin Forge Co of Glasgow for the Vessel No. 176, being built by Messrs A & J. Inglis of Glasgow have been inspected by me, in course of being forged and smithed, and found to be, so far as can be seen, sound and satisfactory.

Mark on Forging.

Lloyd's  
No. ✓  
G. N

I am, Sir,


Your Obedient Servant,

George Newcomb  
Glasgow

The Secretary,  
London.

|                        | STERN FRAMES. | RUDDER FRAMES.                 | STEMS. |
|------------------------|---------------|--------------------------------|--------|
| Material*              | /             | Scrap iron<br>Forged.          | /      |
| How made               | /             |                                | /      |
| Dimensions             | /             | 9 1/2 x 4 3/4 to 9 1/4 x 5 1/2 | /      |
| Progress on Inspection | /             | Forged and smithed             | /      |
| Dates when Inspected   | /             | 8.16.29/3/83. 6.11.18.19/4/83. | /      |

SKETCHES OF FRAMES SHEWING POSITION AND DESCRIPTION OF WELDS.

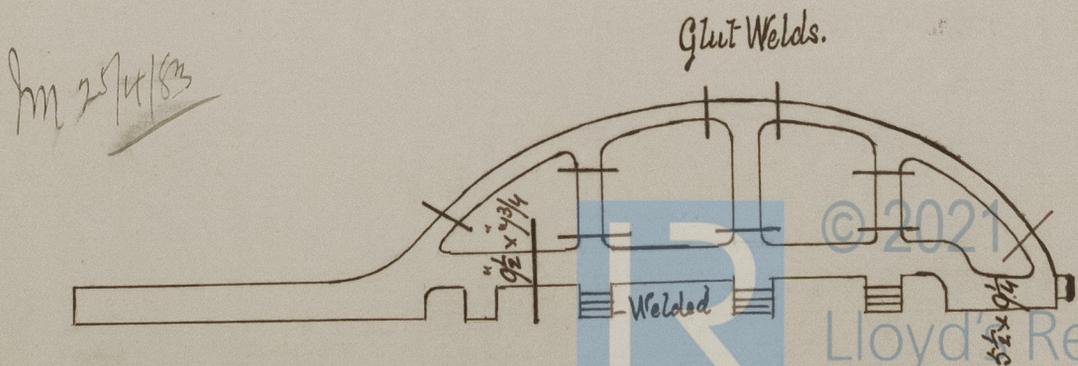

\* If of iron, state whether scrap or puddled iron.