

LLOYD'S REGISTER OF SHIPPING  
 JUL. 83  
 LONDON

1 JUN. 83  
 LONDON  
 2 JUN. 83  
 LONDON  
 Glasgow.  
 5710/82.

19/2/83  
21/6/83  
27/6/83  
12/7/83


Midship Section

S. S. N<sup>o</sup> 258.

Scale  $\frac{1}{2}$ " Inch = 1 Foot.

*Builders Dimensions.*  
 24'9" x 33' x 25'-4" hold 14'-6" to Main Deck.  
 To Class 100A Awning Deck.

S. S. Adelaide  
Glasgow Report No. 6309.

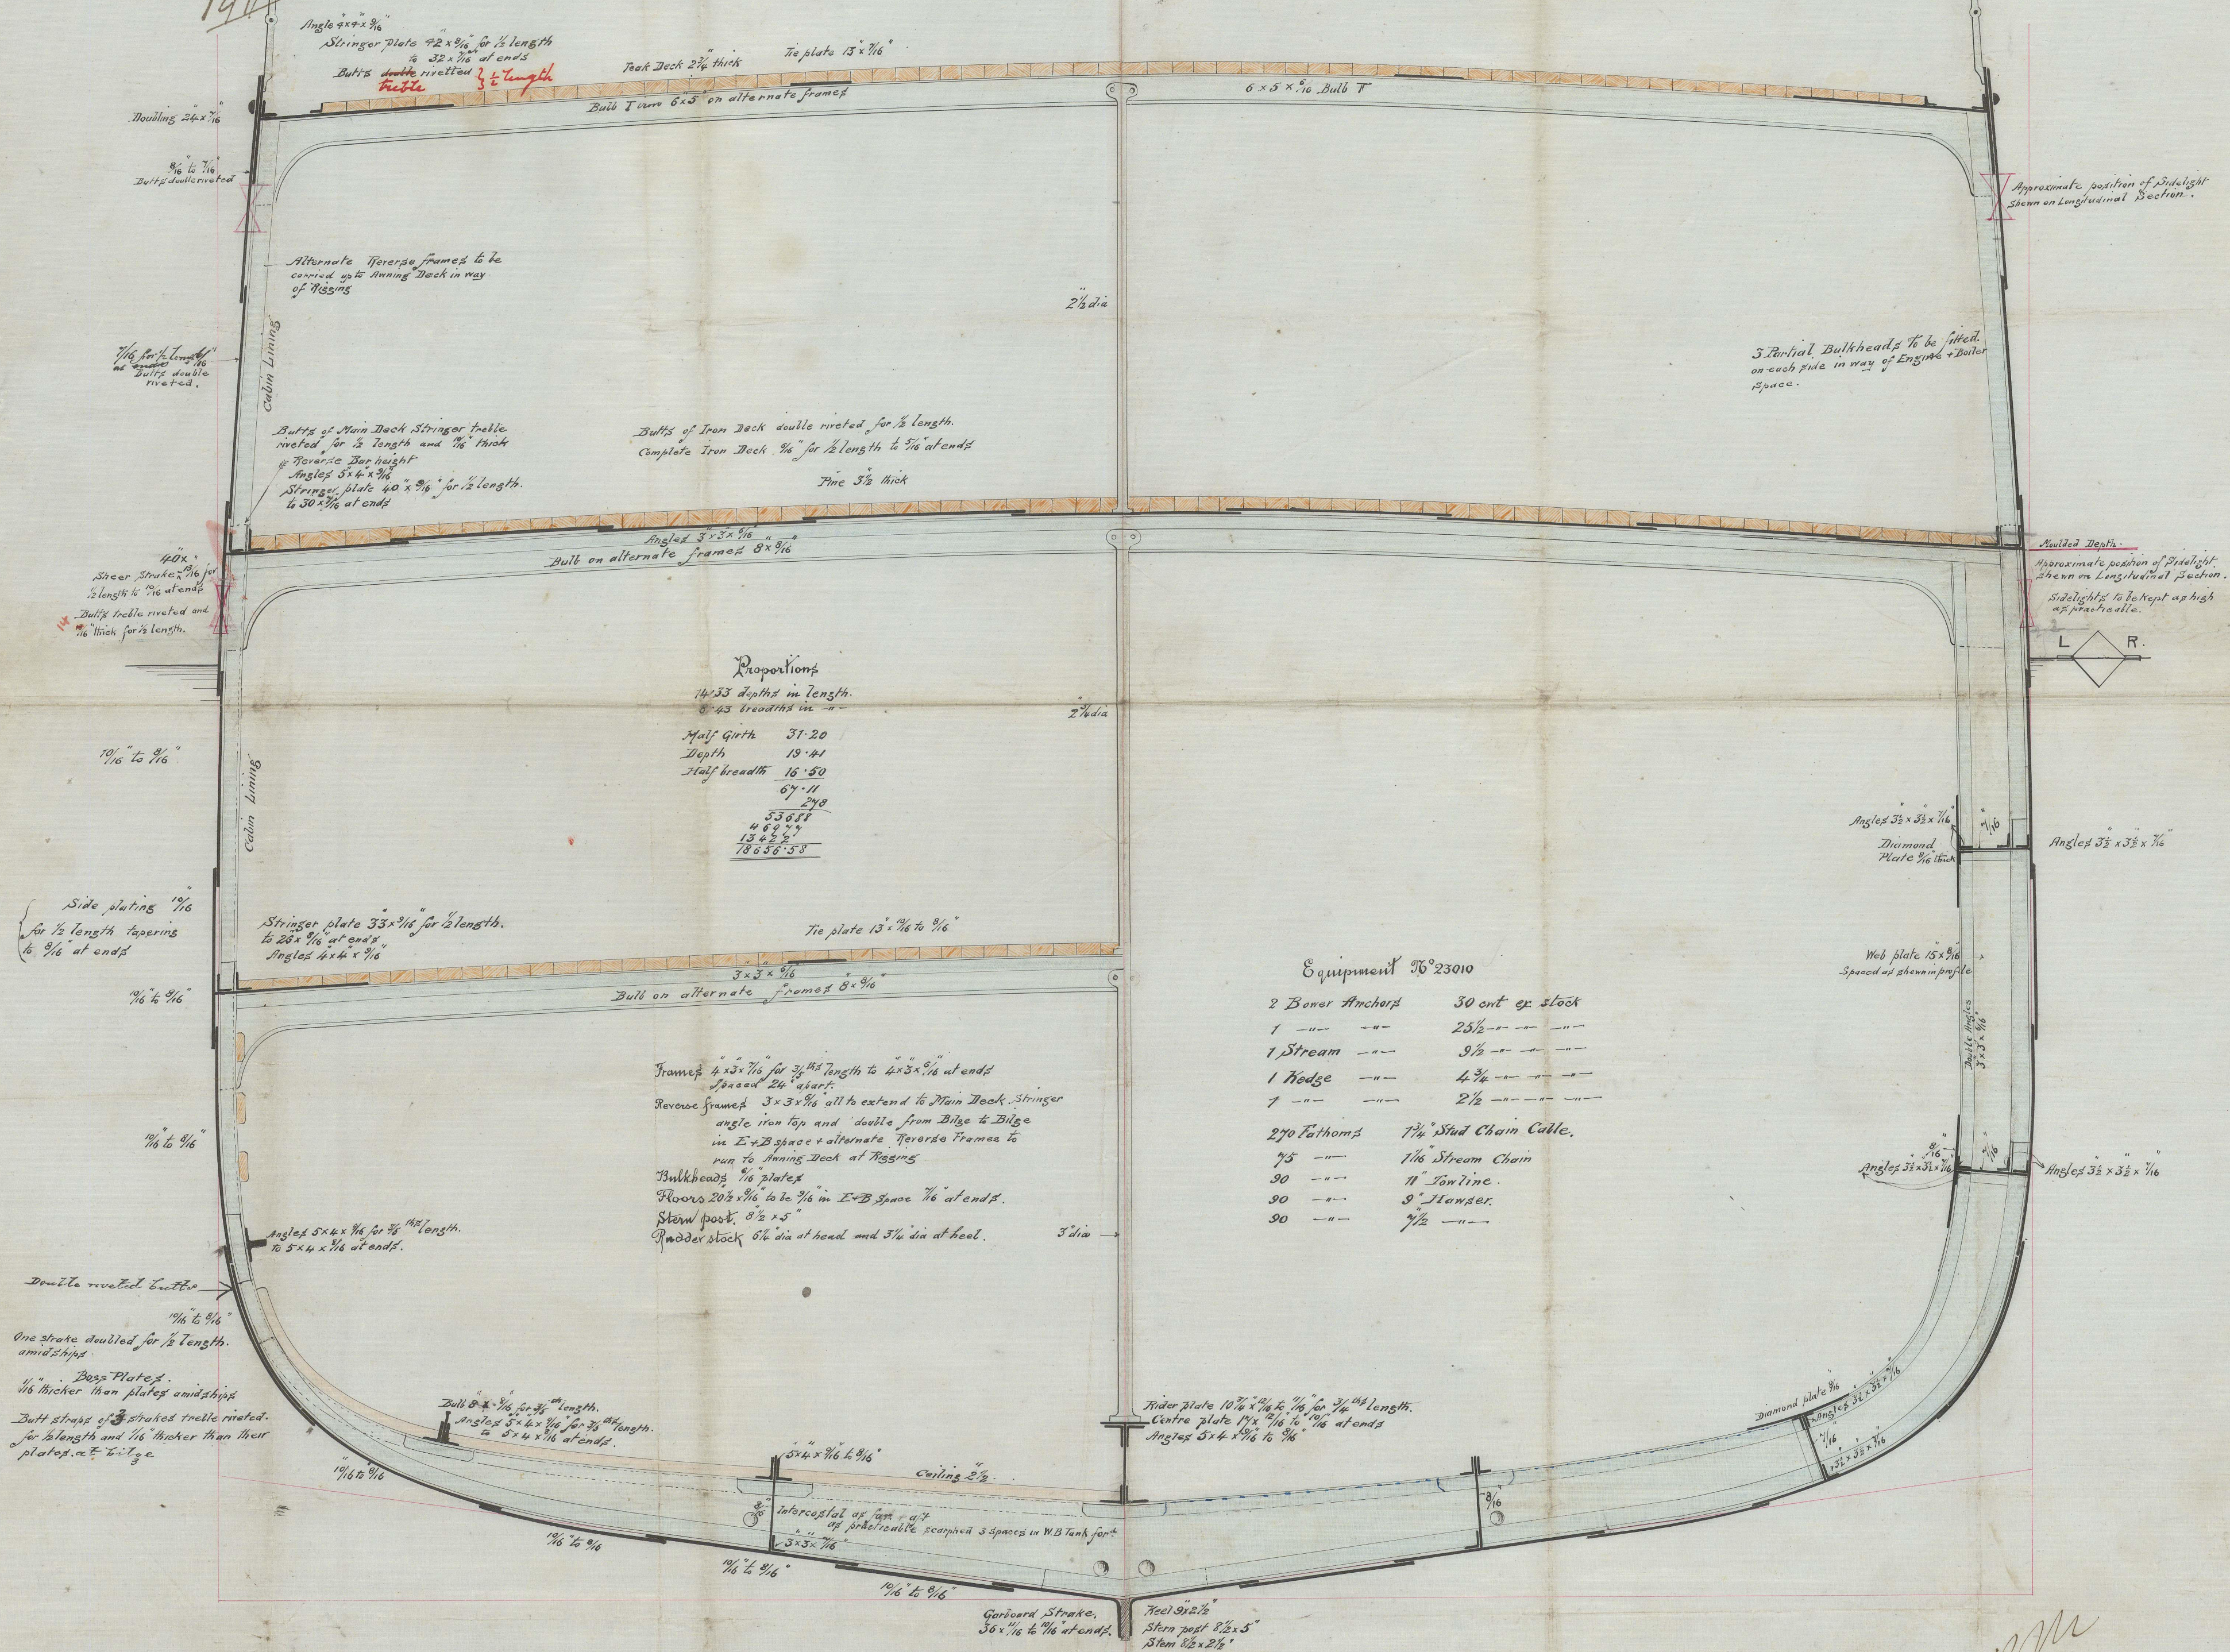

18. M  
57, 10782