


Amended arrangements.
S.S. Adelaide
 Glasgow Report No. 6309.

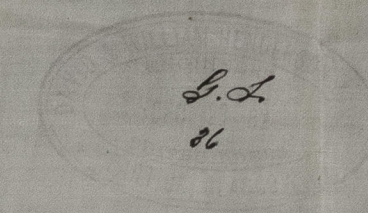

Lower Deck
 S.S. No. 258
 SCALE $\frac{1}{4}$ " = ONE FOOT

