


*Lt. Gibson
6/10/82.*

S.S. "Adelaide" Glasgow Report No. 6309.


Armour Deck

See Amended sketch 28.12.82.

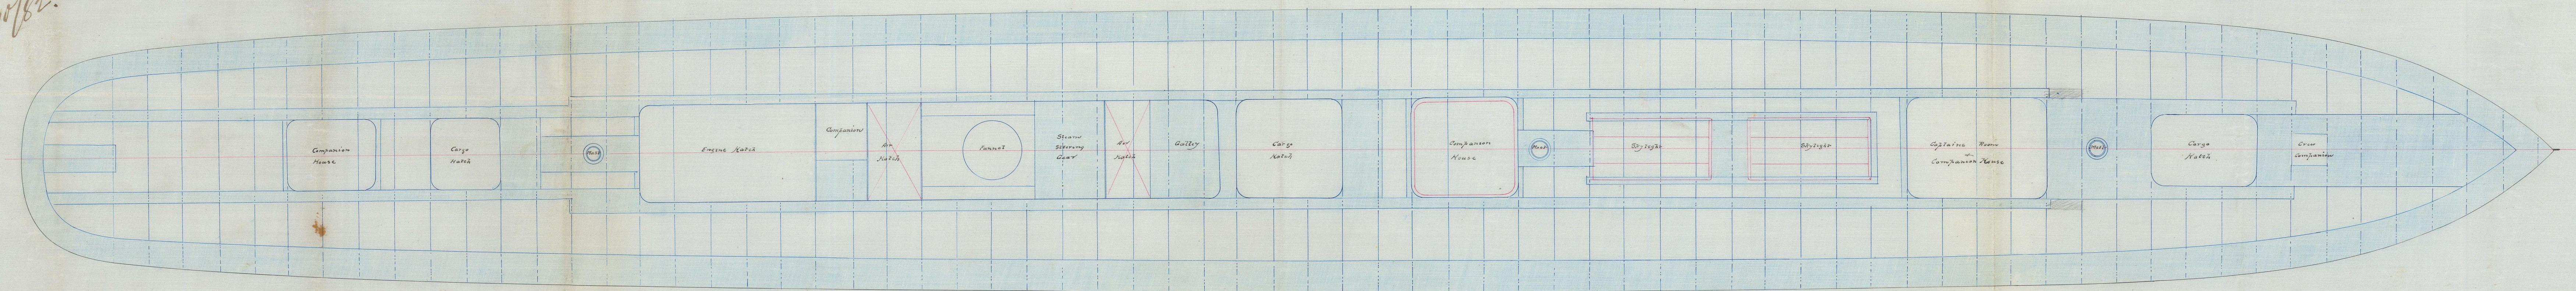


Main Deck

*Iron Deck Plans
— S S No 258 —
Scale 1/8 Inch = One Foot*

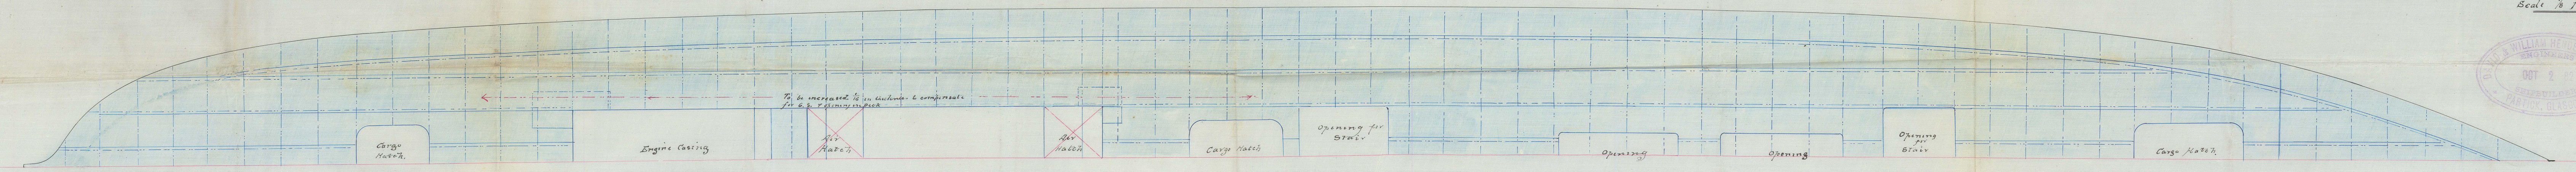

Lower Deck

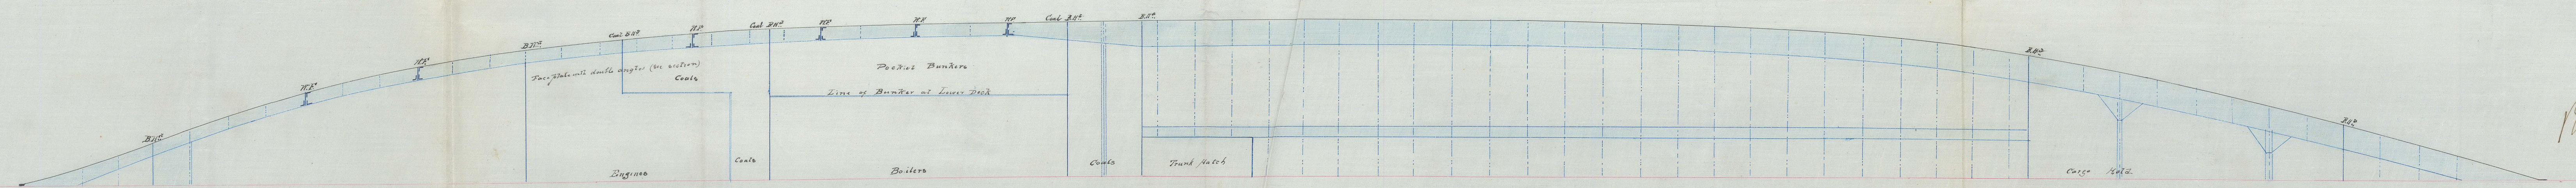

*1882
6/10/82*