

Dr. S. S. Adelaide

2/6/83.

102

27/6/83. G. J.

12/7/83.


Section Shewing Permanent Awning

S. S. No 258.

S. S. Adelaide

Glasgow Report No 6309.

Scale $\frac{1}{2}$ " = one foot.

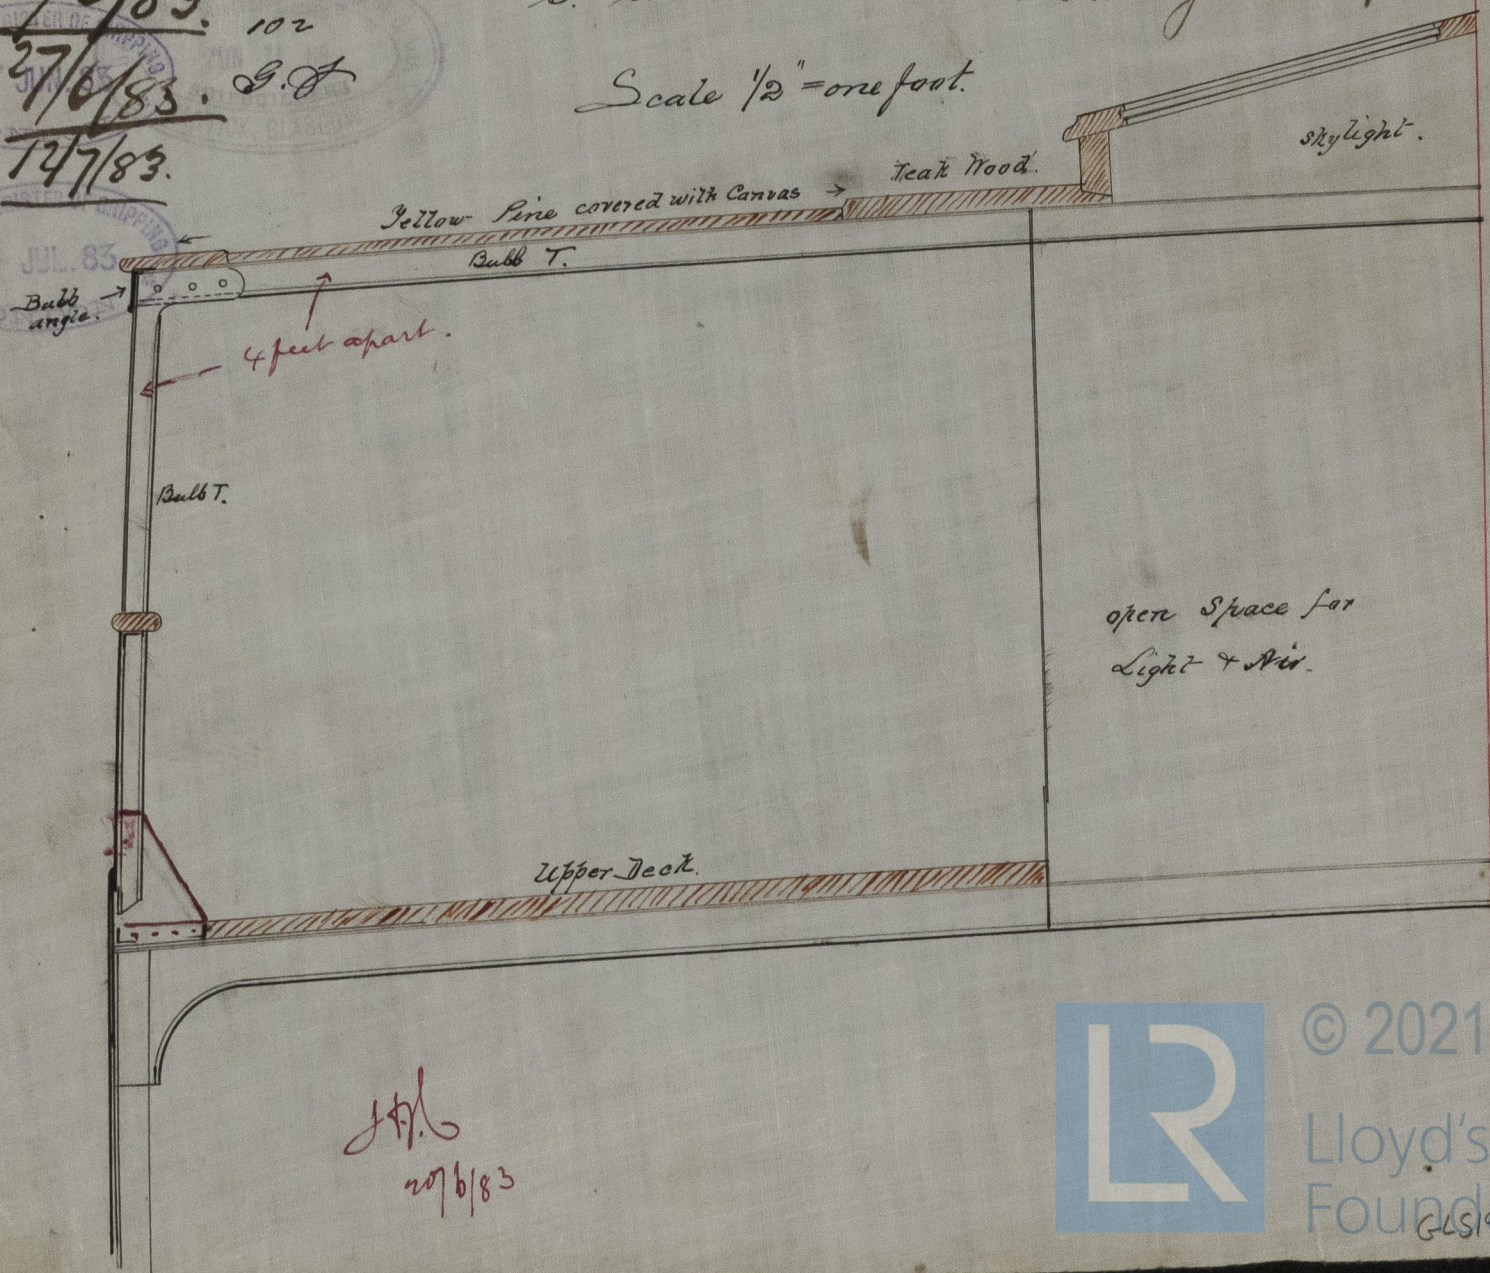

© 2021

Lloyd's Register
Foundation

GLS 96-0110