
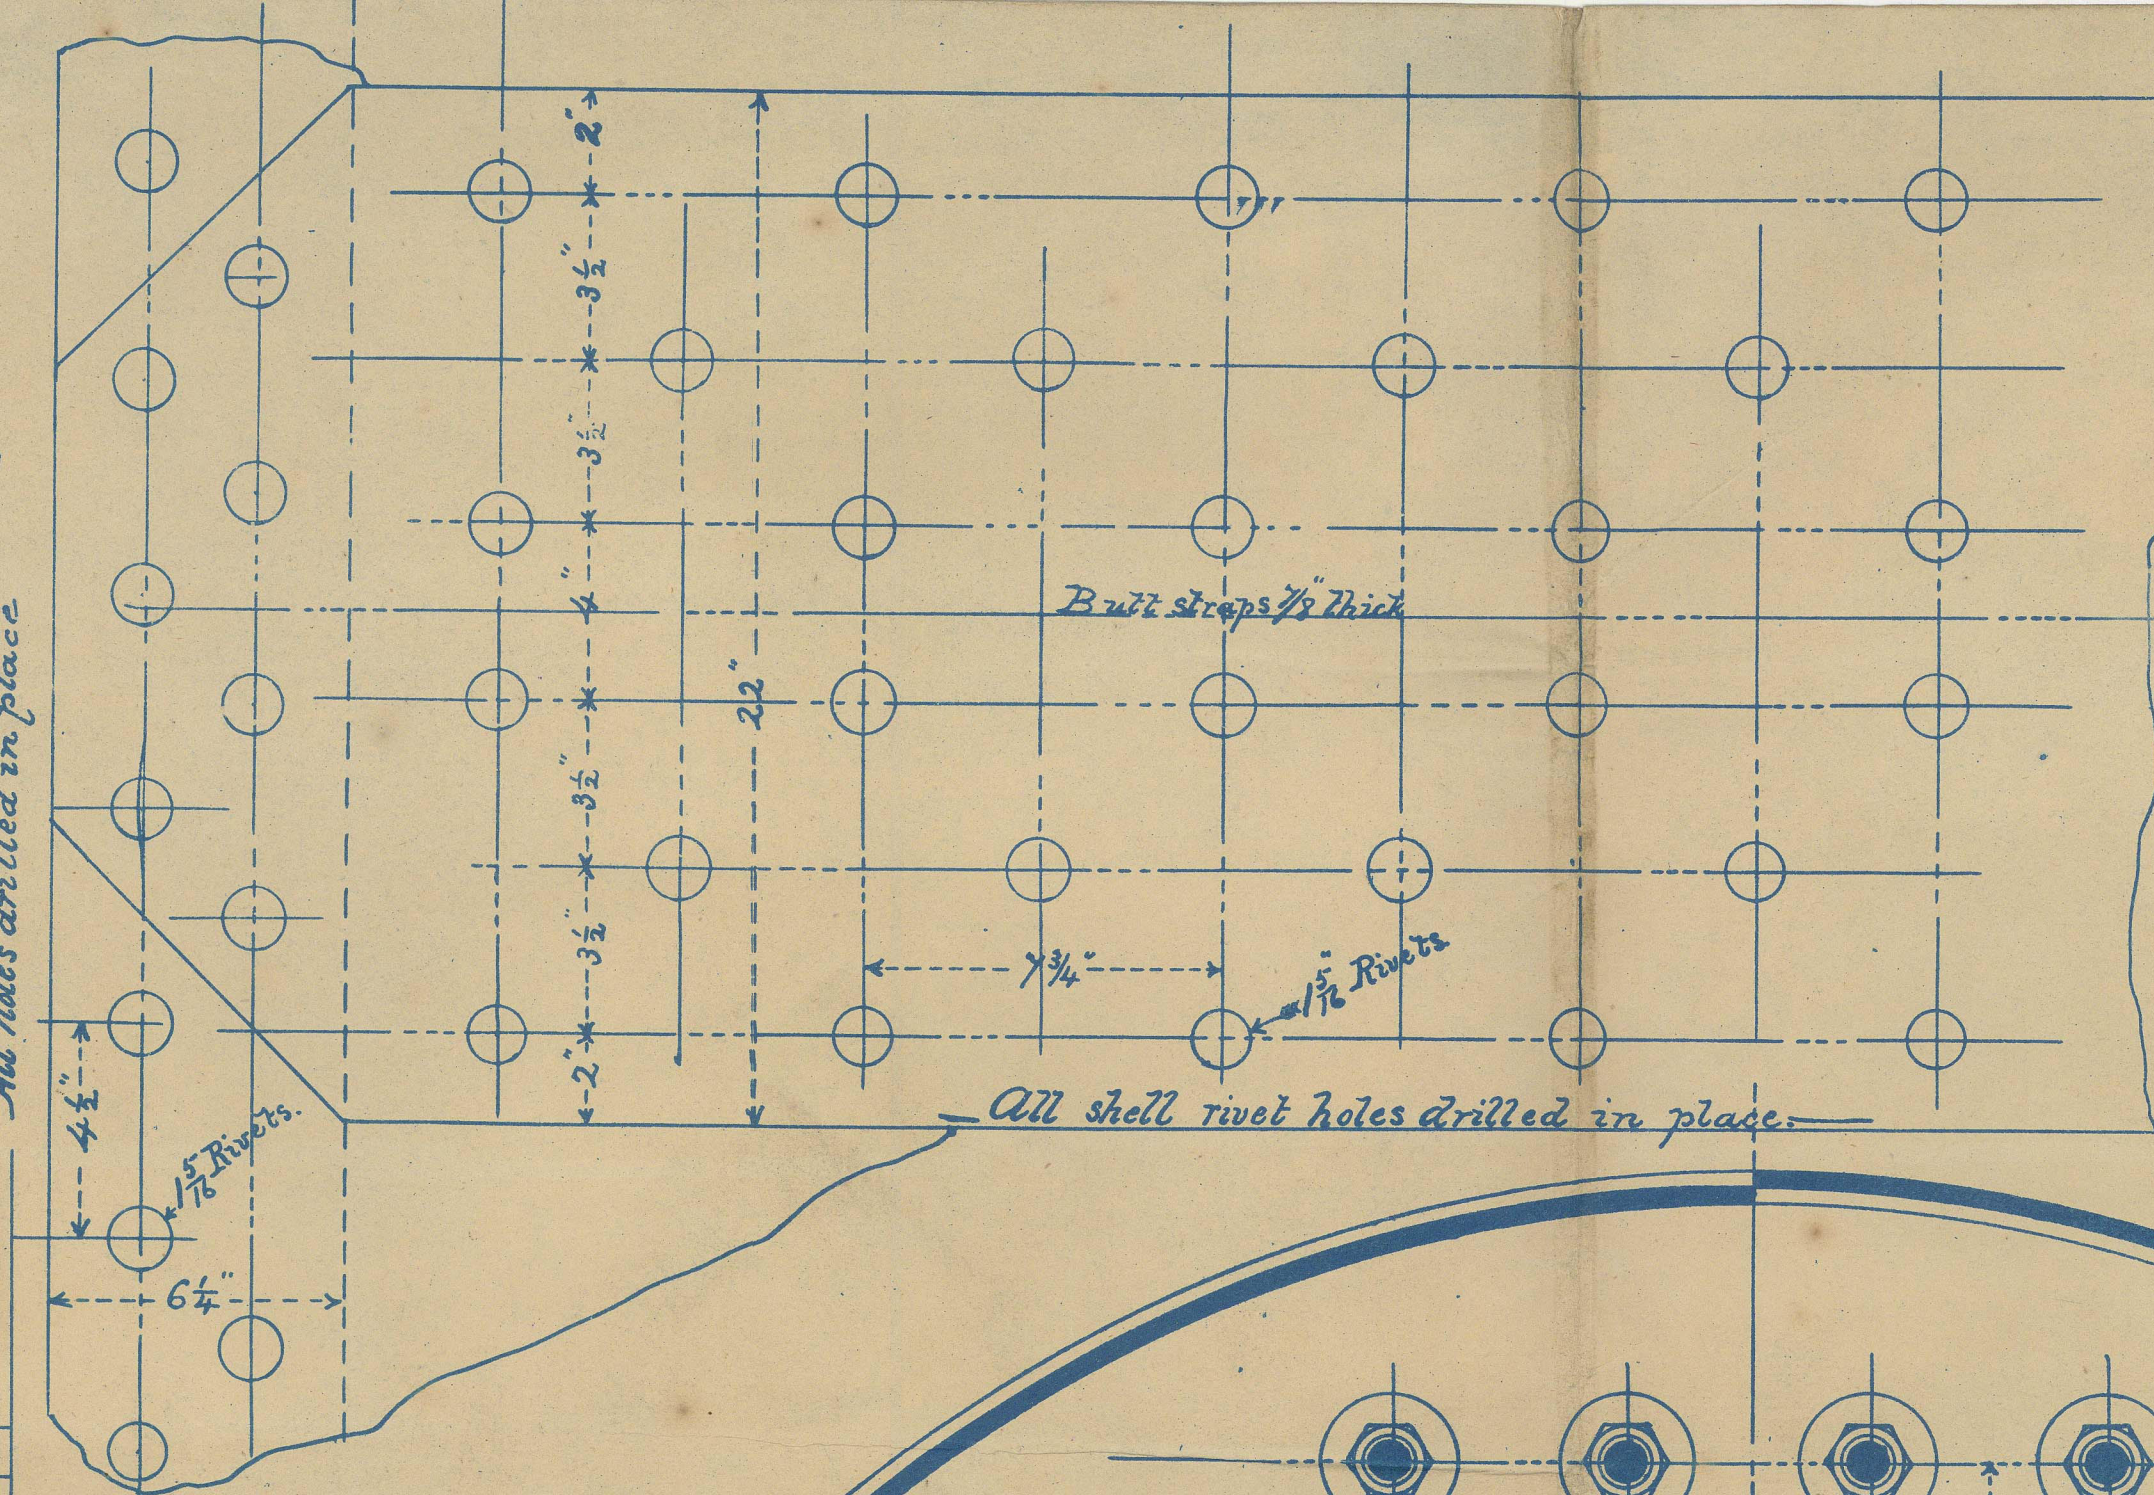



21.666.
2/3/83

Board of Trade	
Plate	= 83.06
Rivet	= 88.8
Lloyds	
Plate	= 83.06
Rivet	= 75.5

S. S. "Adelaide"
Glasgow Report
A 6309.

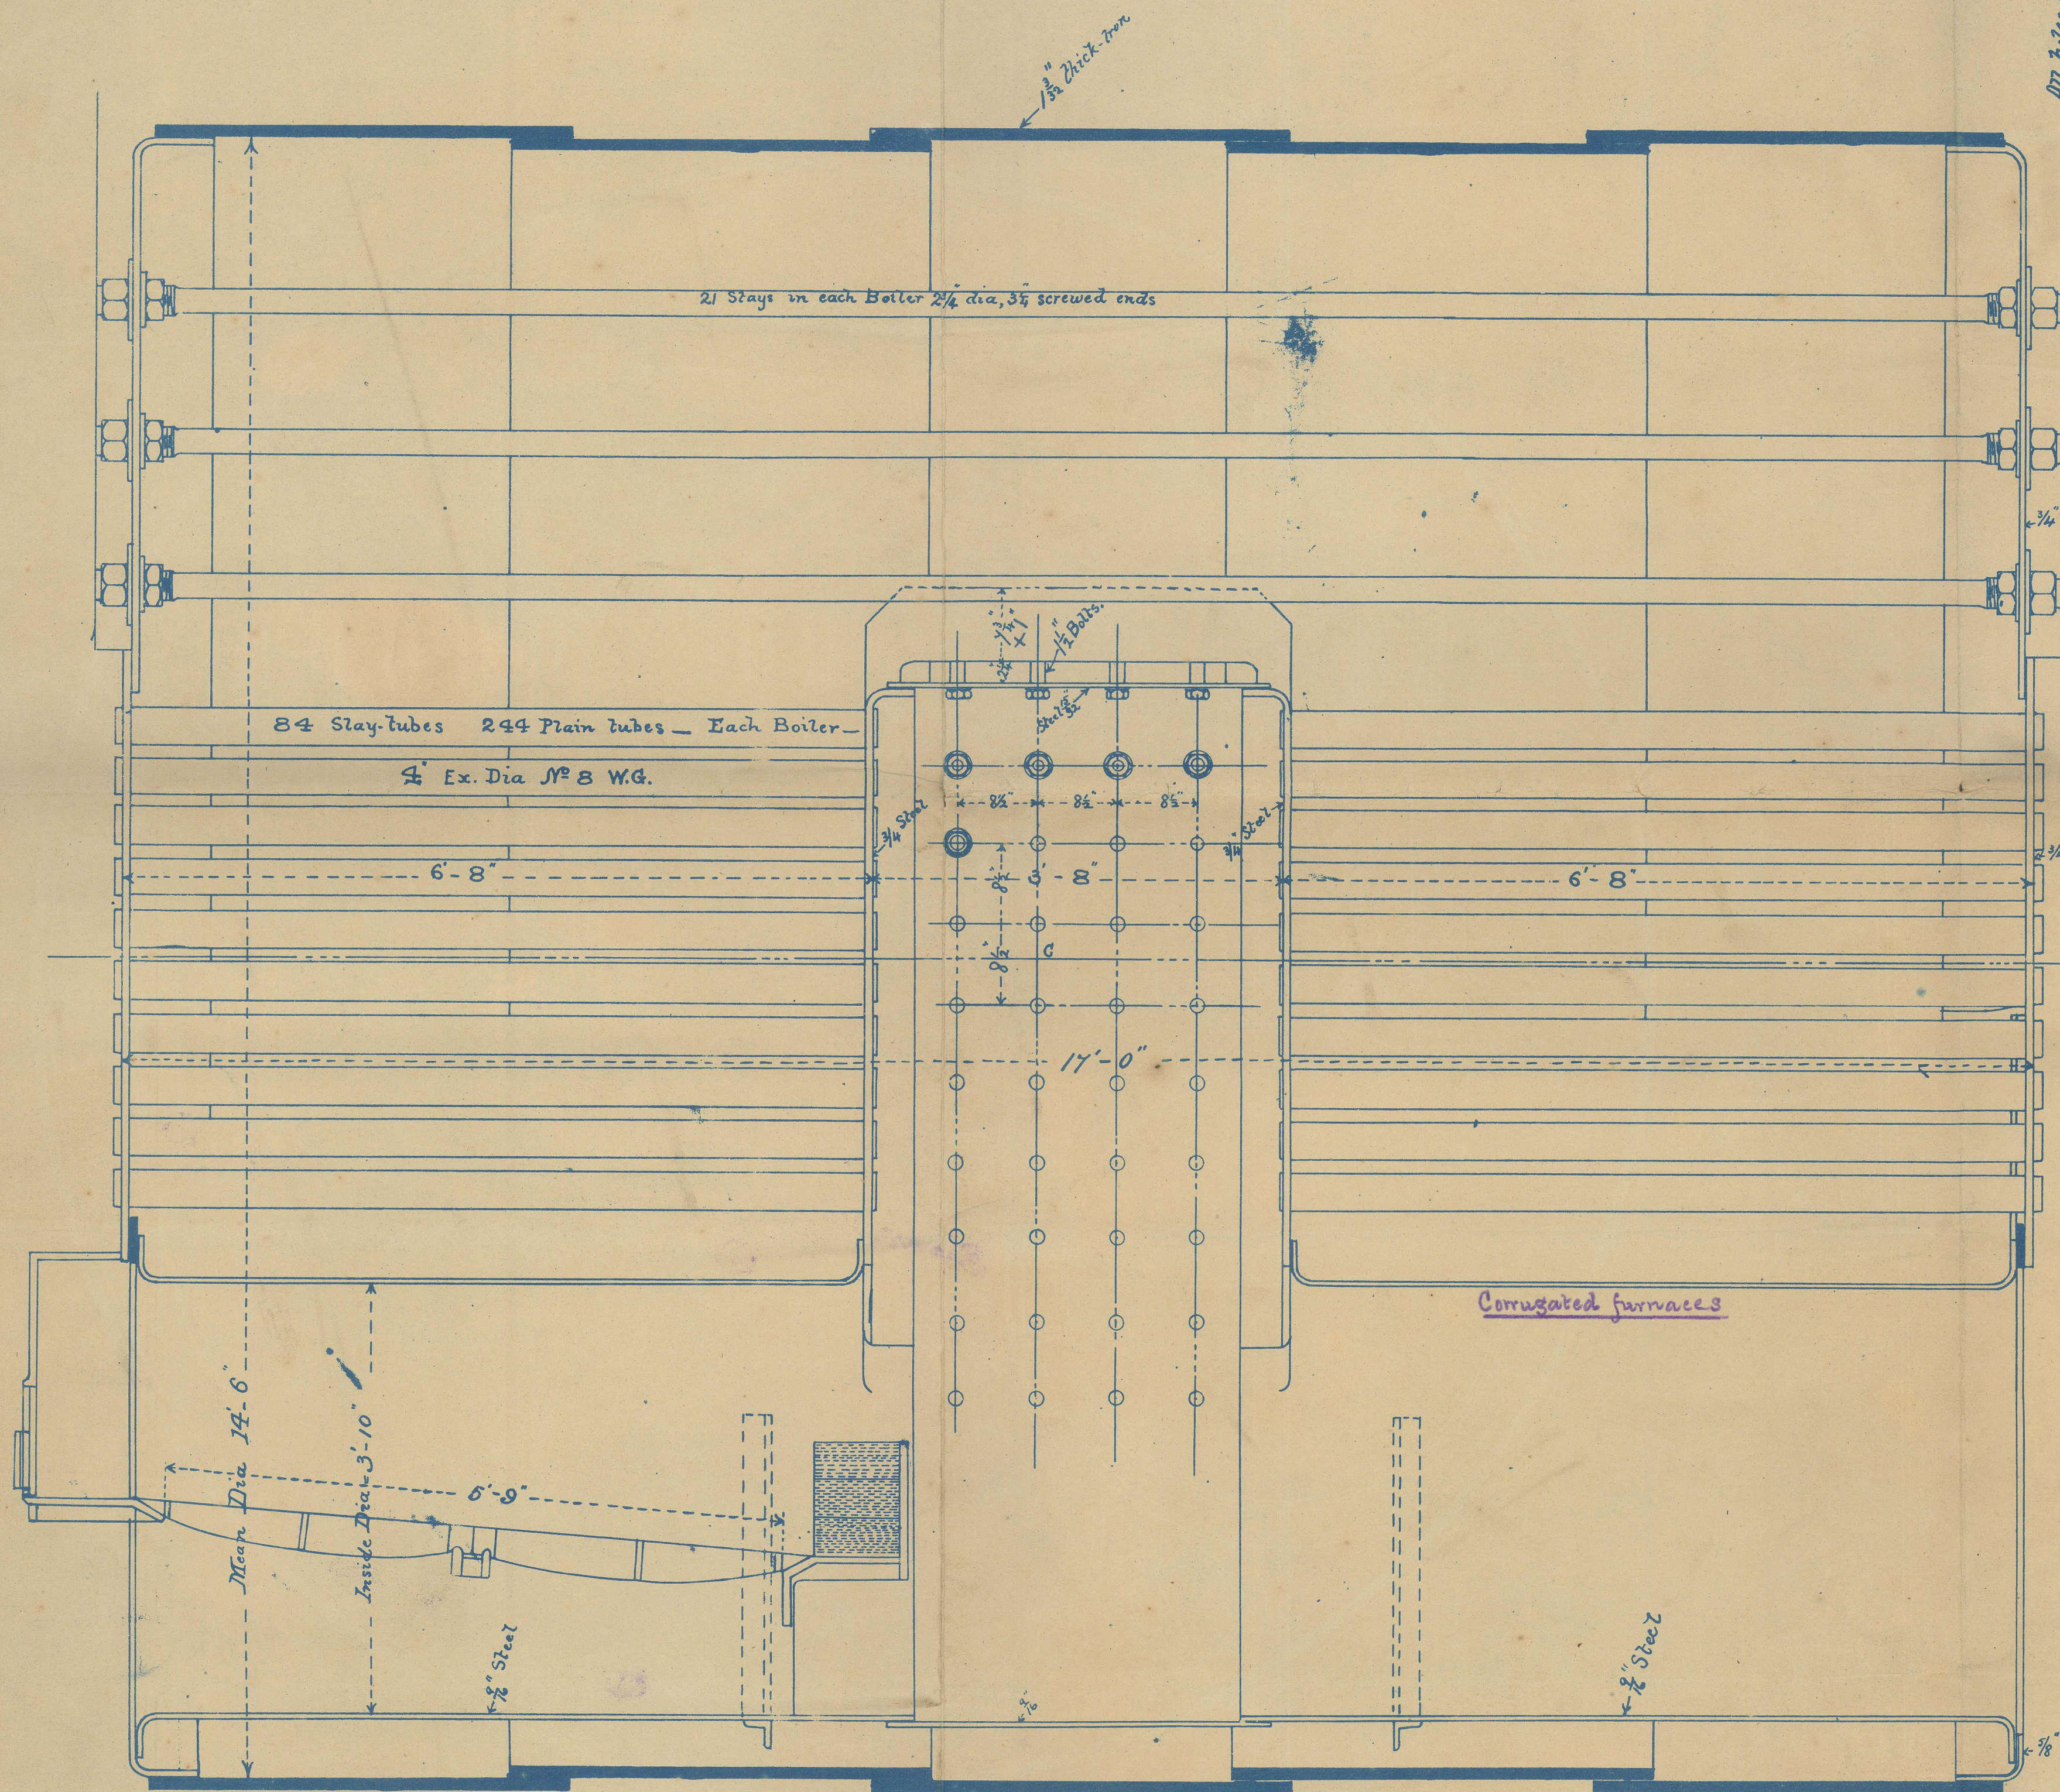

[2 off]

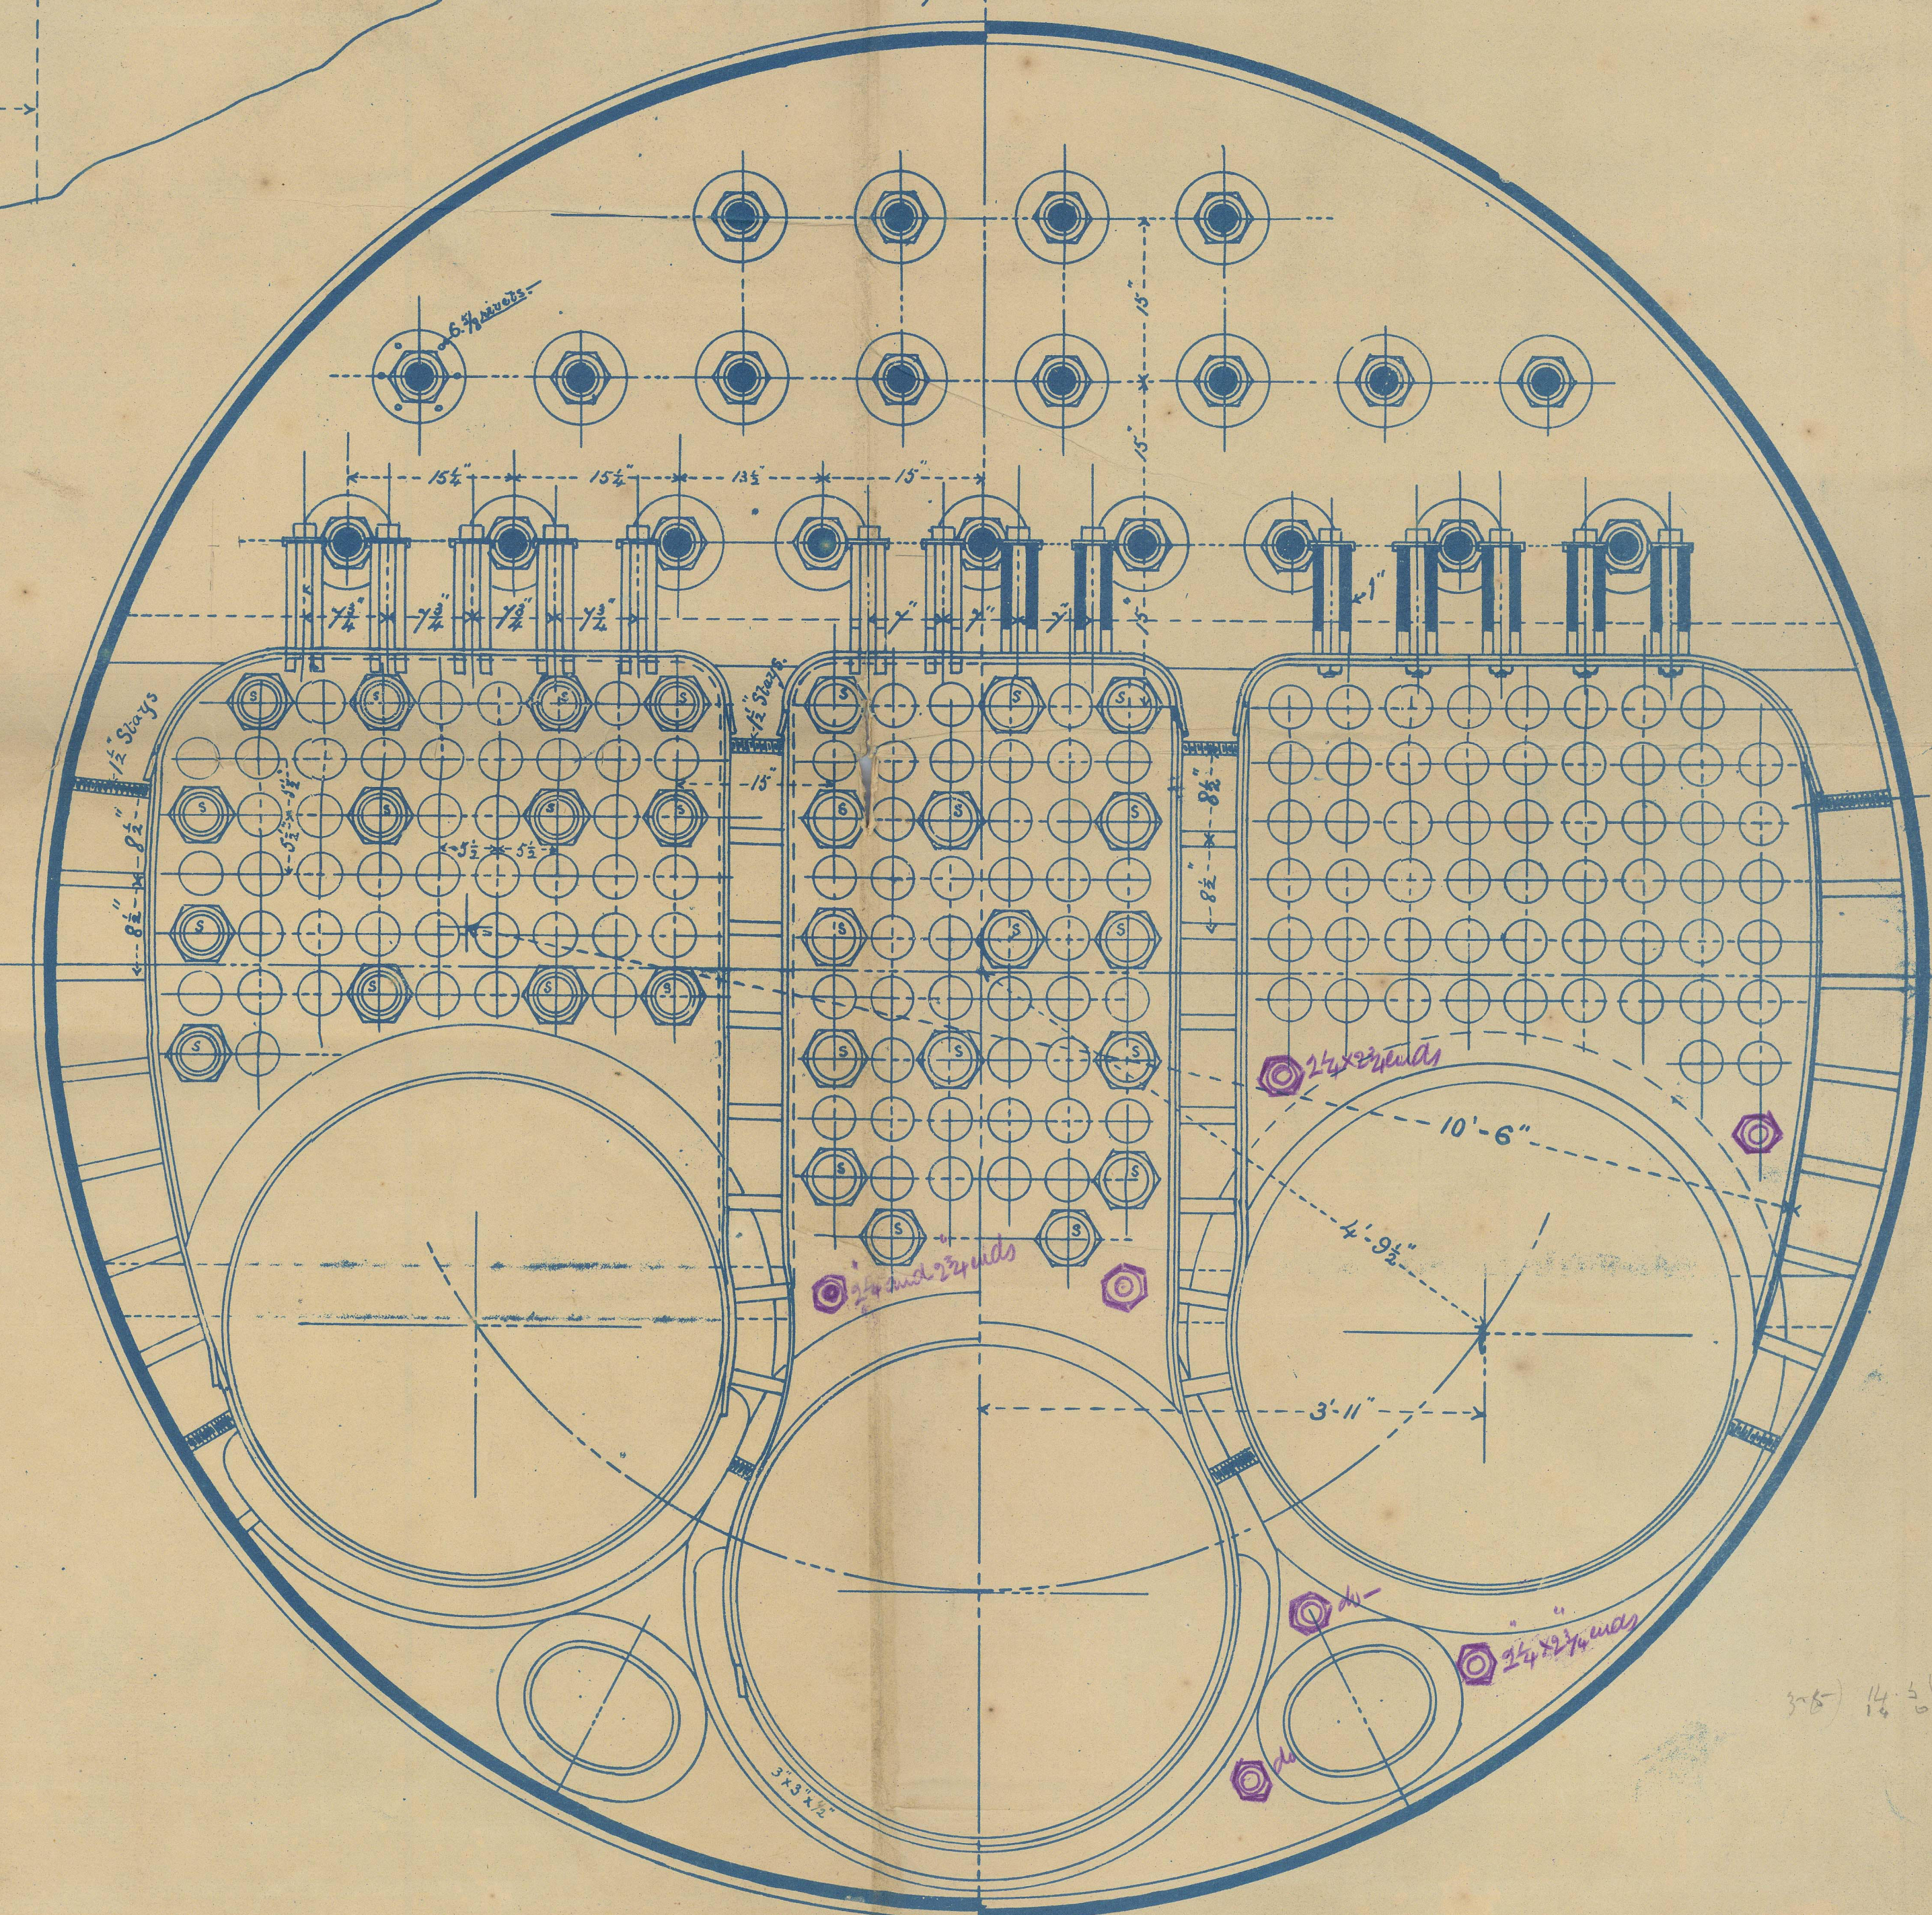

N° 258

M. BOILERS

Scale = 1" = 1 foot

WORKING PRESSURE 90 lbs.

D.F.
2/3/83

S. 23/2/83
Glasgow.

M. Boile
Henderfon N^o 258
~~258~~



© 2021

Lloyd's Register
Foundation

GLS196-0112