

RECEIVED 44 OCT. 82



Mr. W. Glasgow  
5/10/82

Sections shewing arrangement of Stringers at ends of vessel,

S.S. "Adelaide"  
Glasgow Report No. 6309.

Section at  $\frac{3}{4}$  Length



Section at  $\frac{1}{2}$  Length

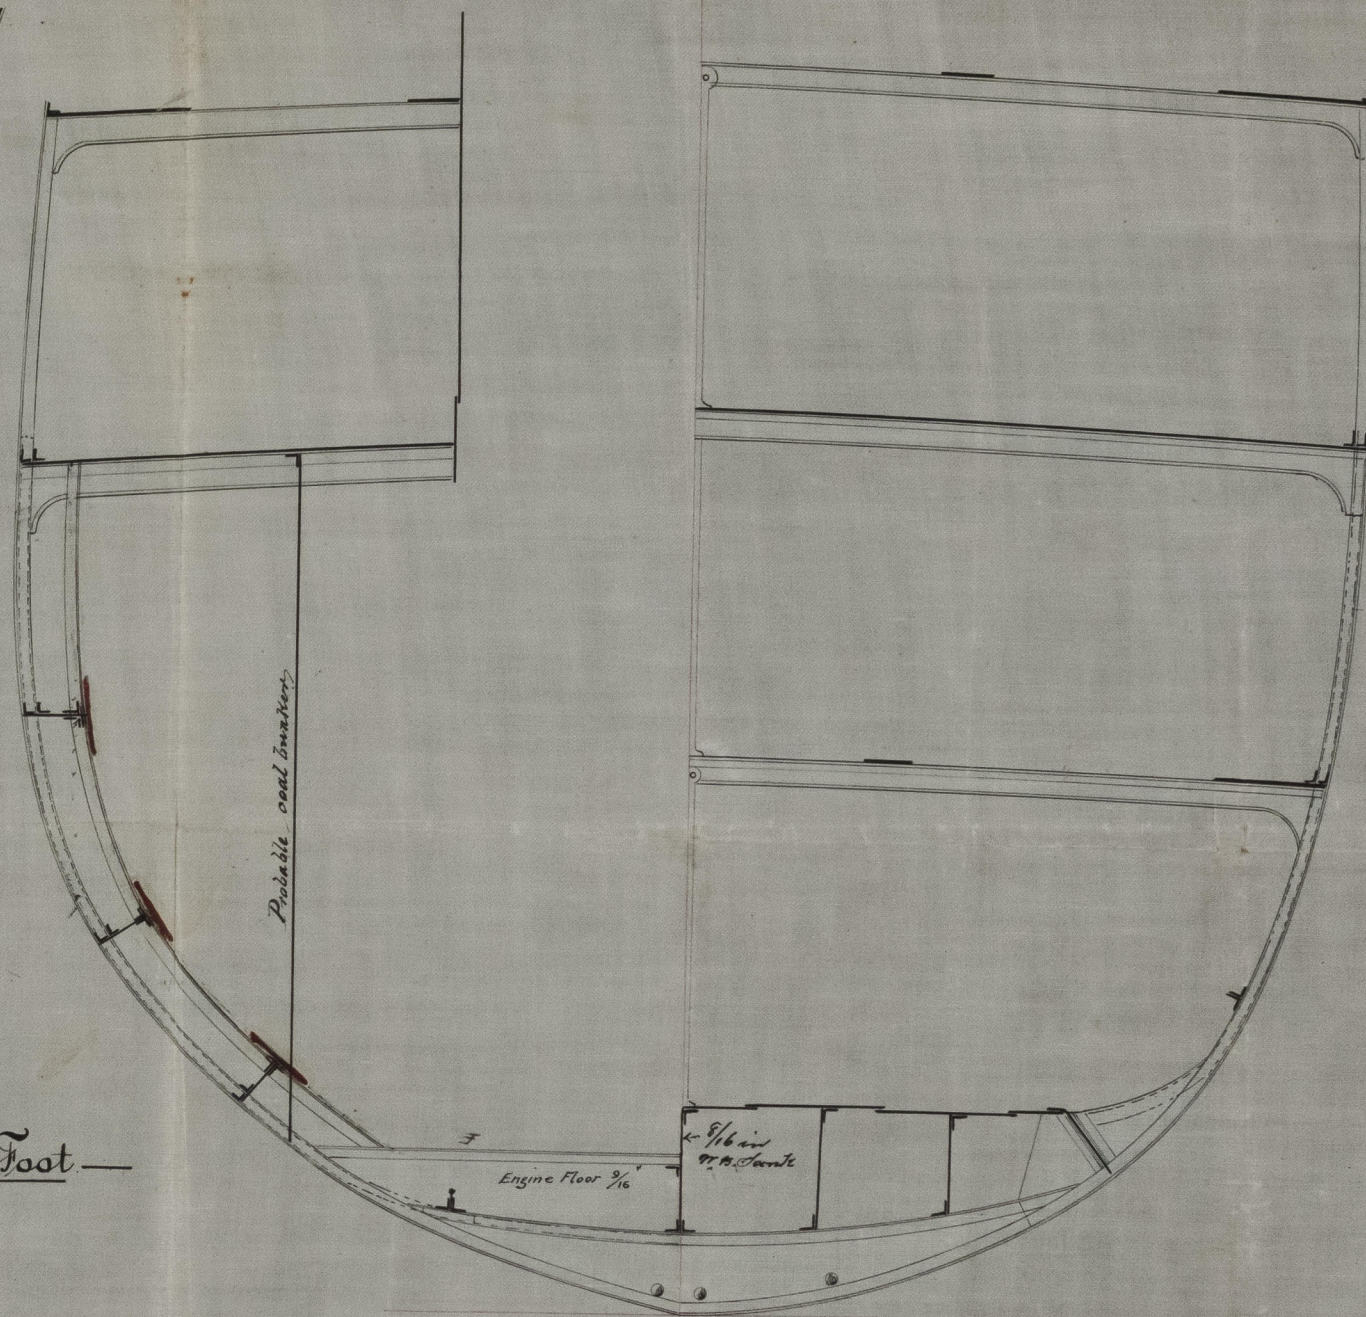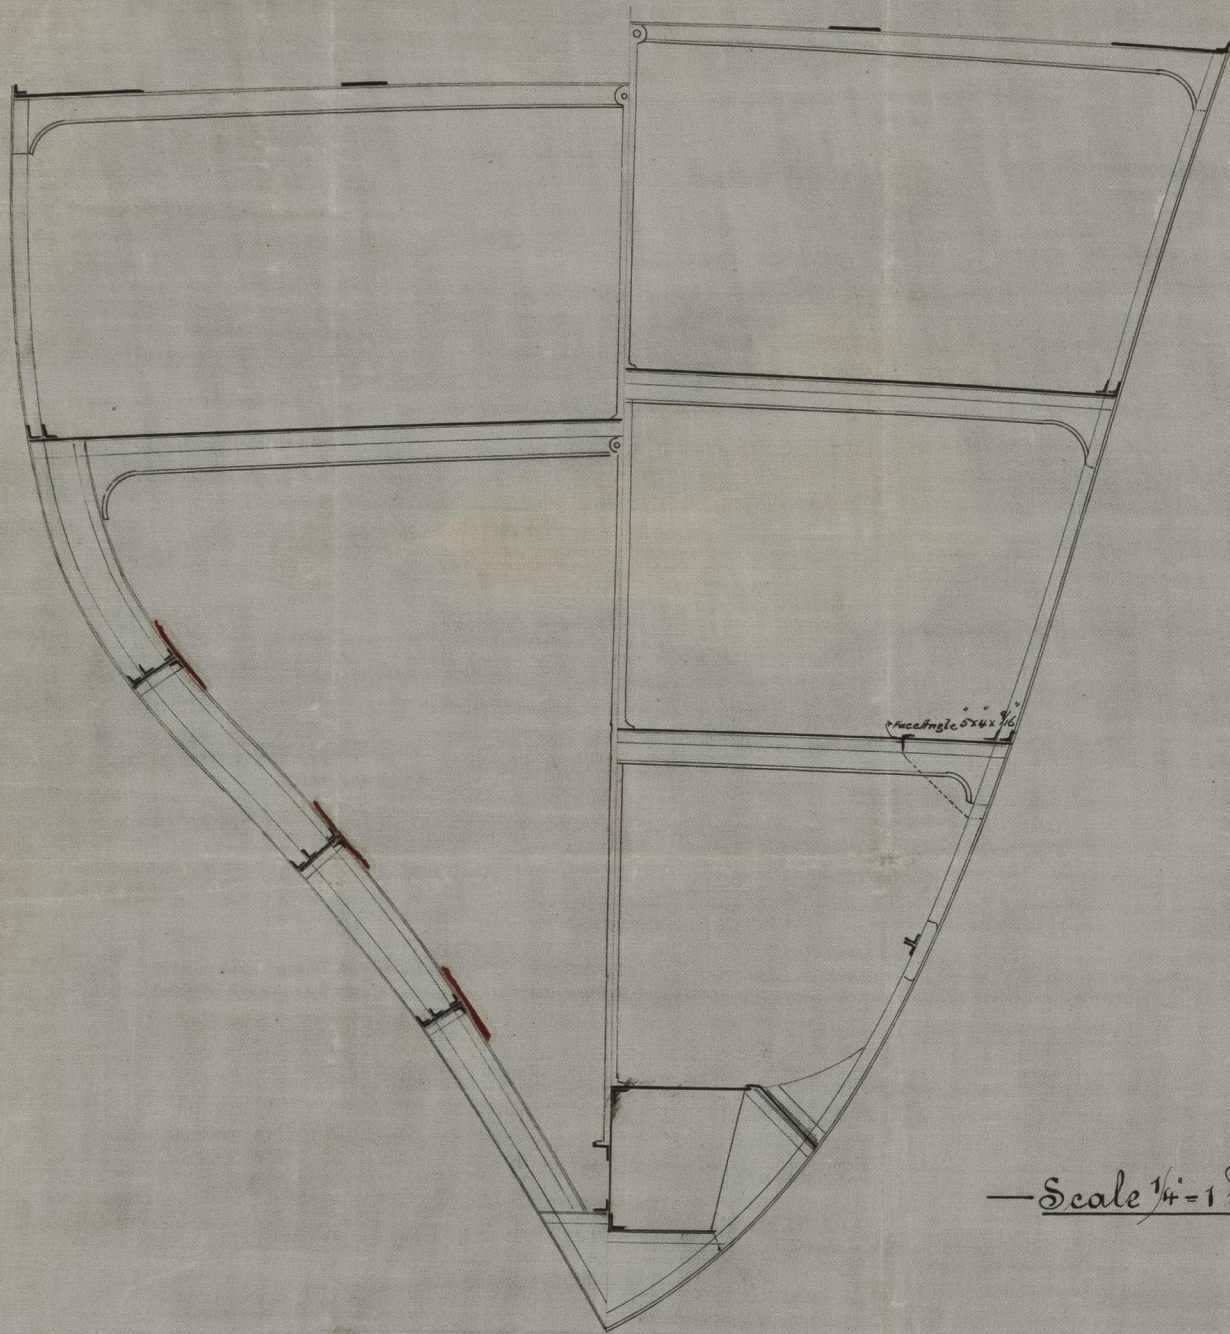


Scale  $\frac{1}{4}$ " = 1 Foot

S. S. No. 258

Section of W.B. Tank

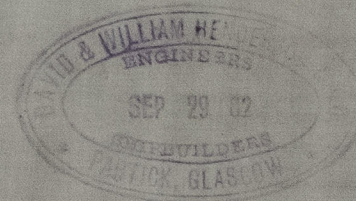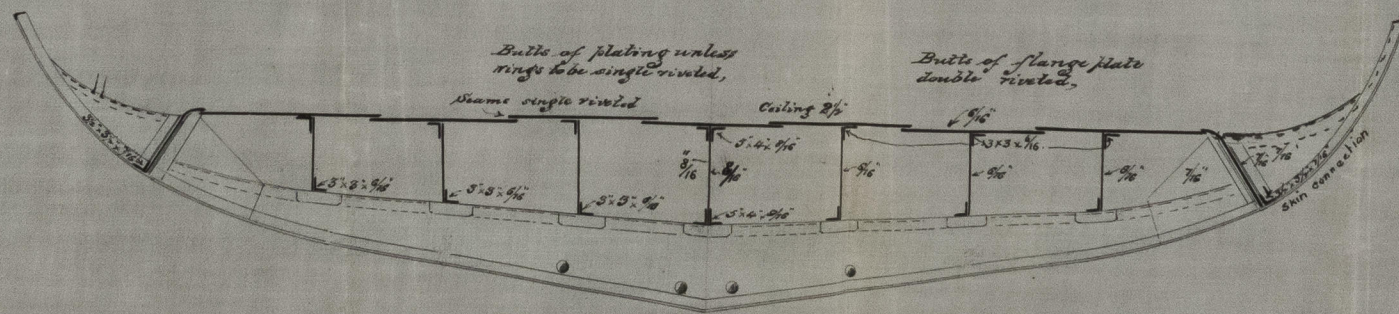

18M  
5/10/82

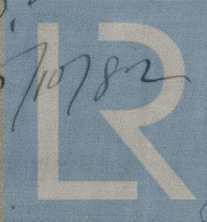

© 2021

Lloyd's Register  
Foundation