
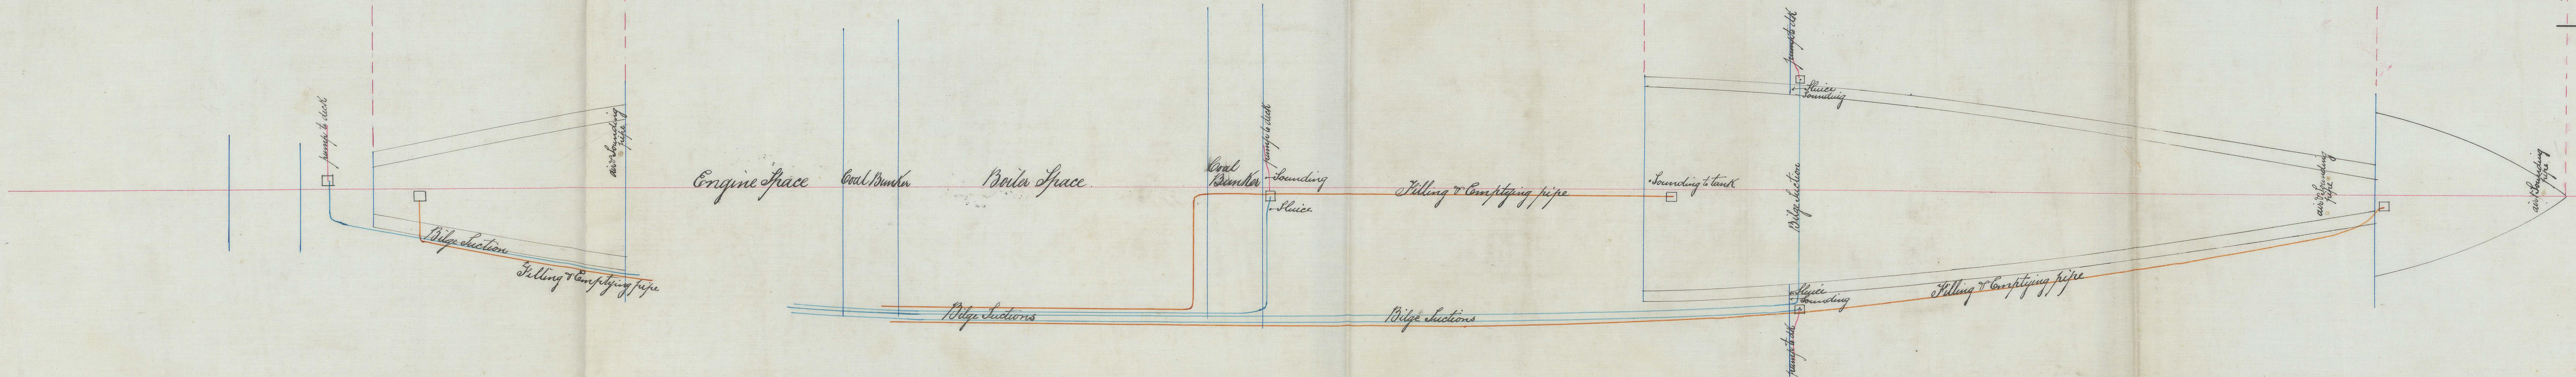


2 1/2 lbs.  
27/8/83

PM  
28/8/83

S. S. Adelaide  
Glasgow Report No. 6309.

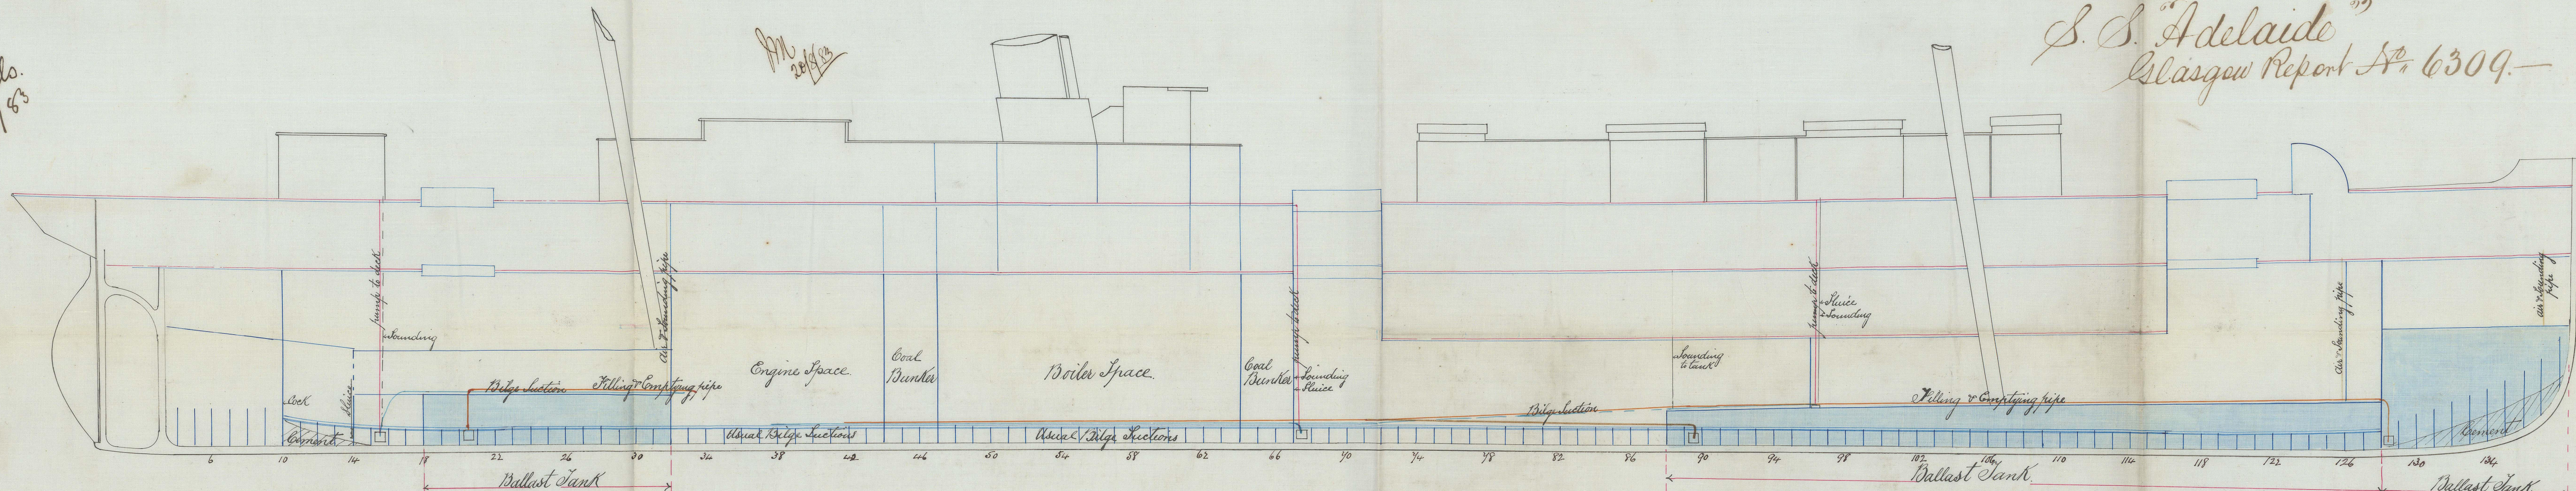

— PIPING PLAN —  
**S.S. N°258**  
SCALE 3/4" = 1 FOOT

