



Dr. to Gls.
19/2/83

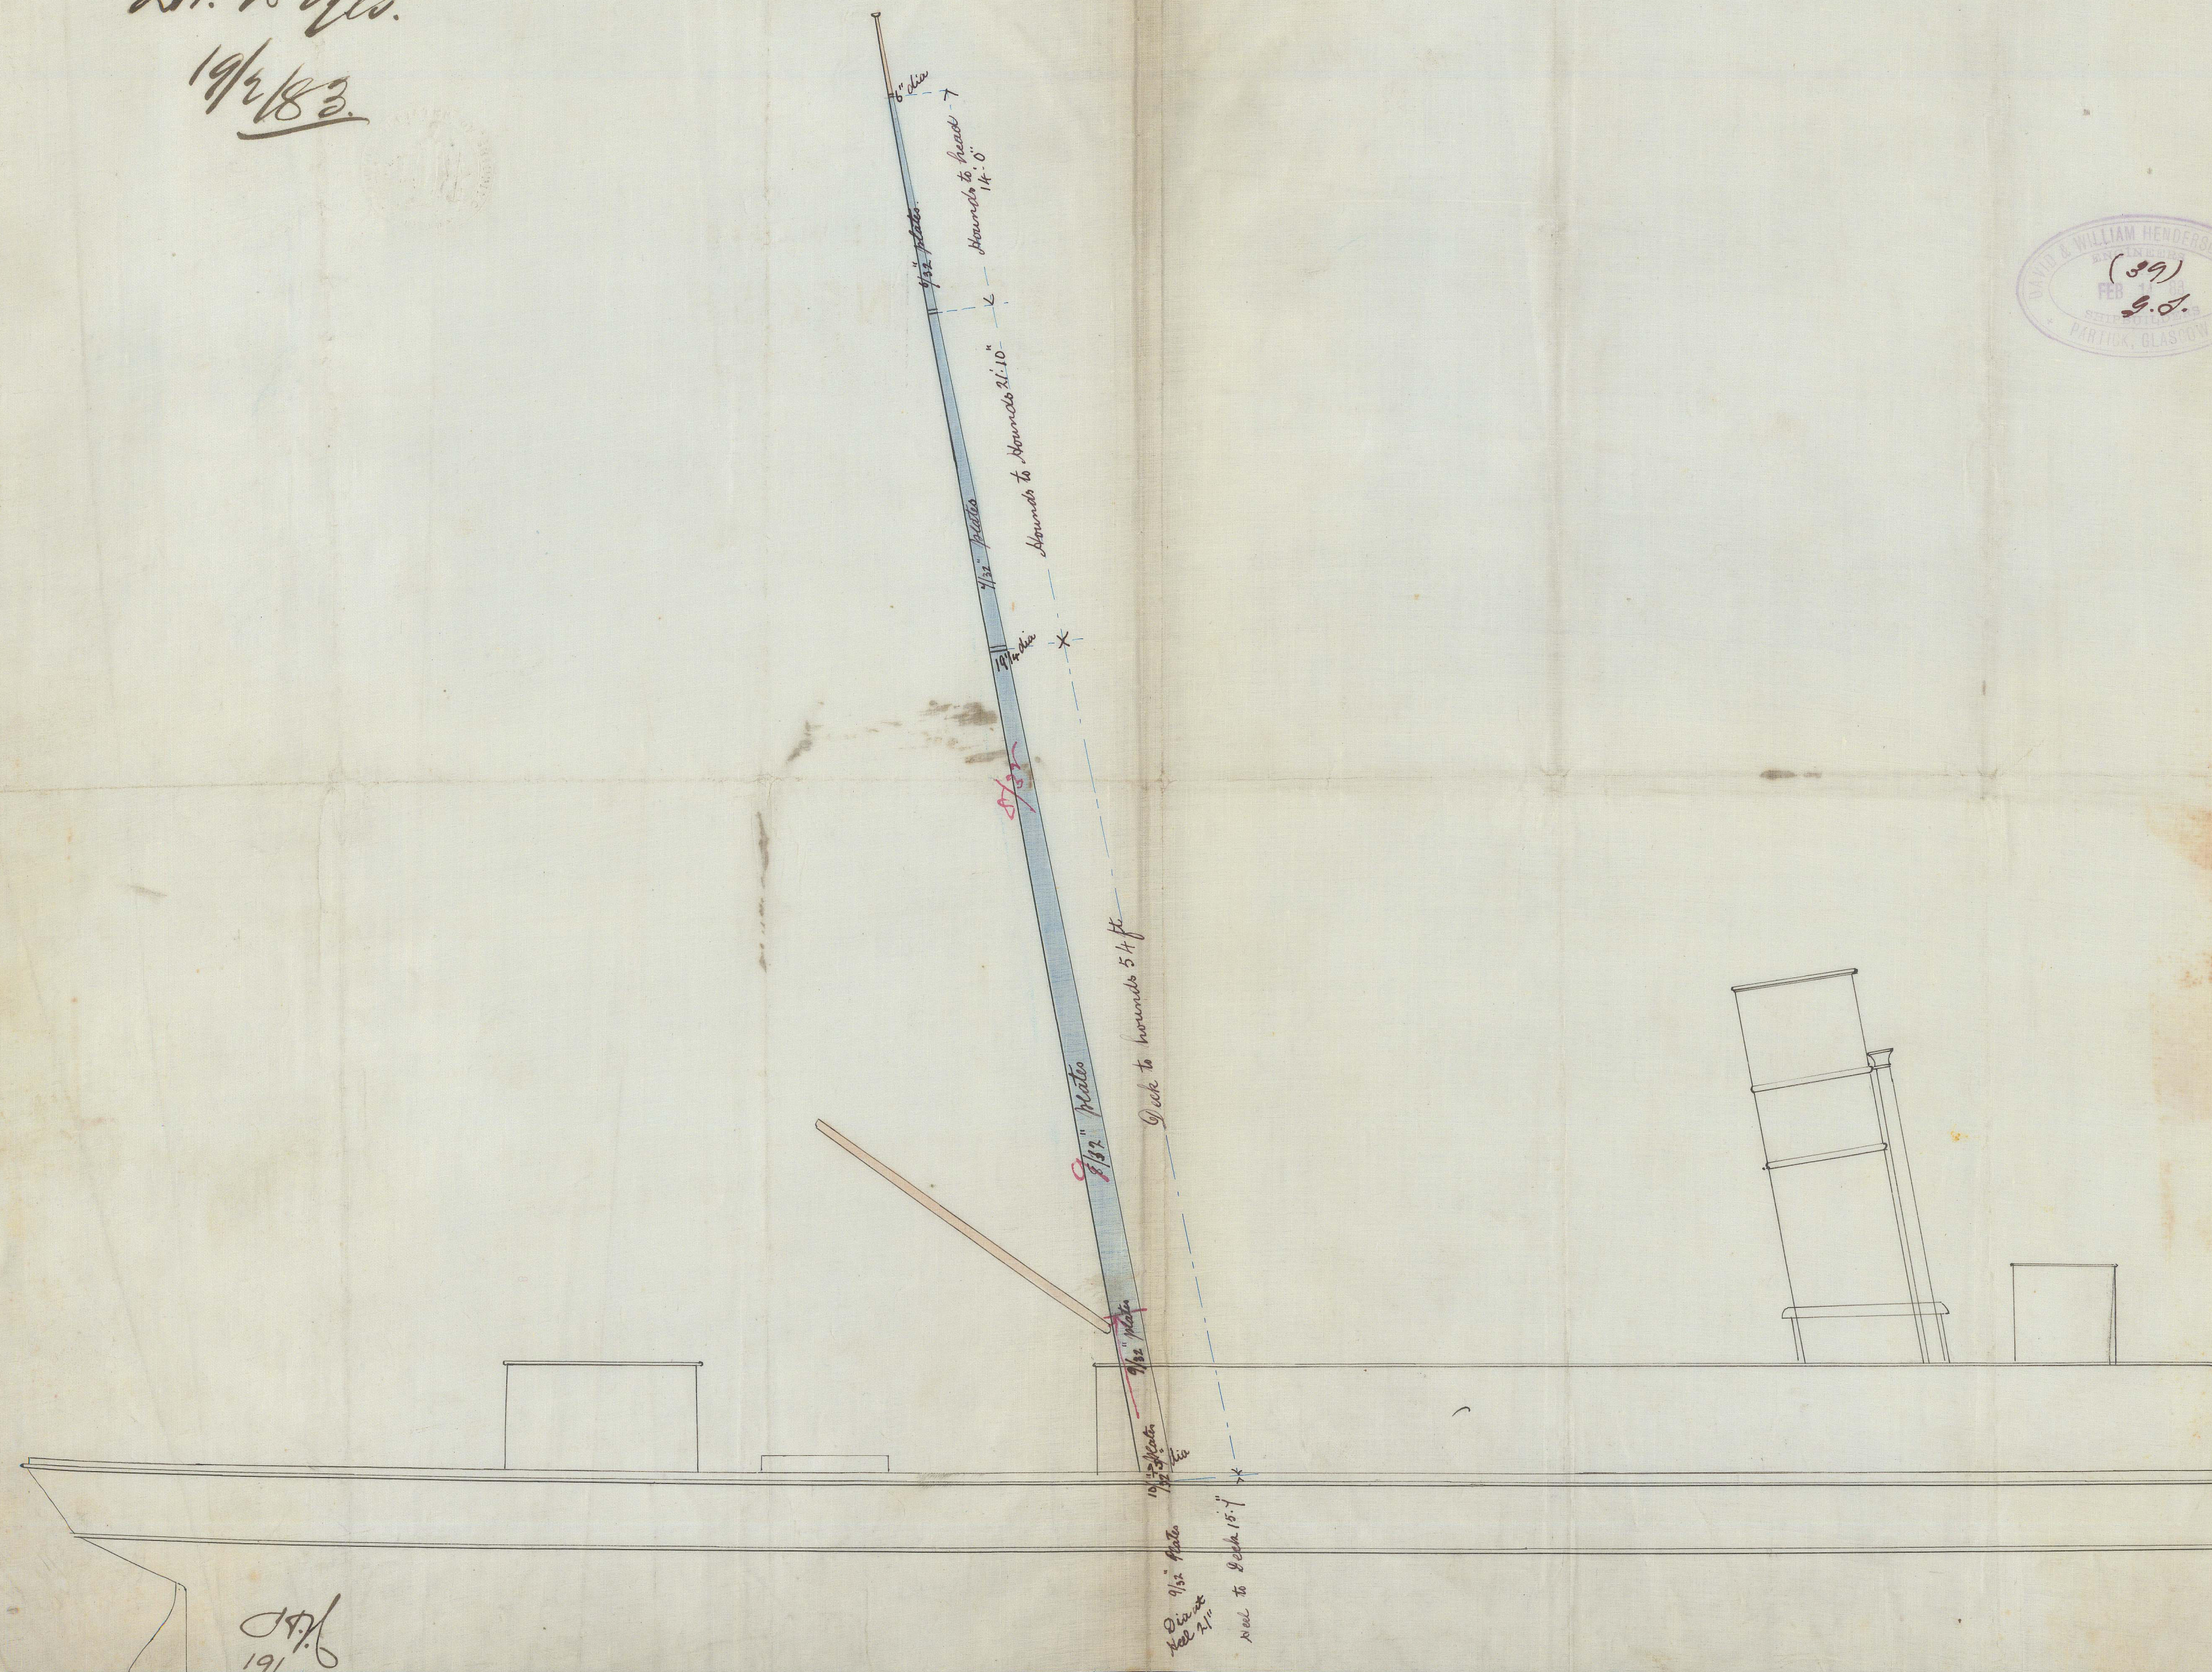

S.S. Adelaide
Glasgow Report No. 6309.

STEEL MASTS
SS. N^o 258.
SCALE 1/4" = 1 FOOT.

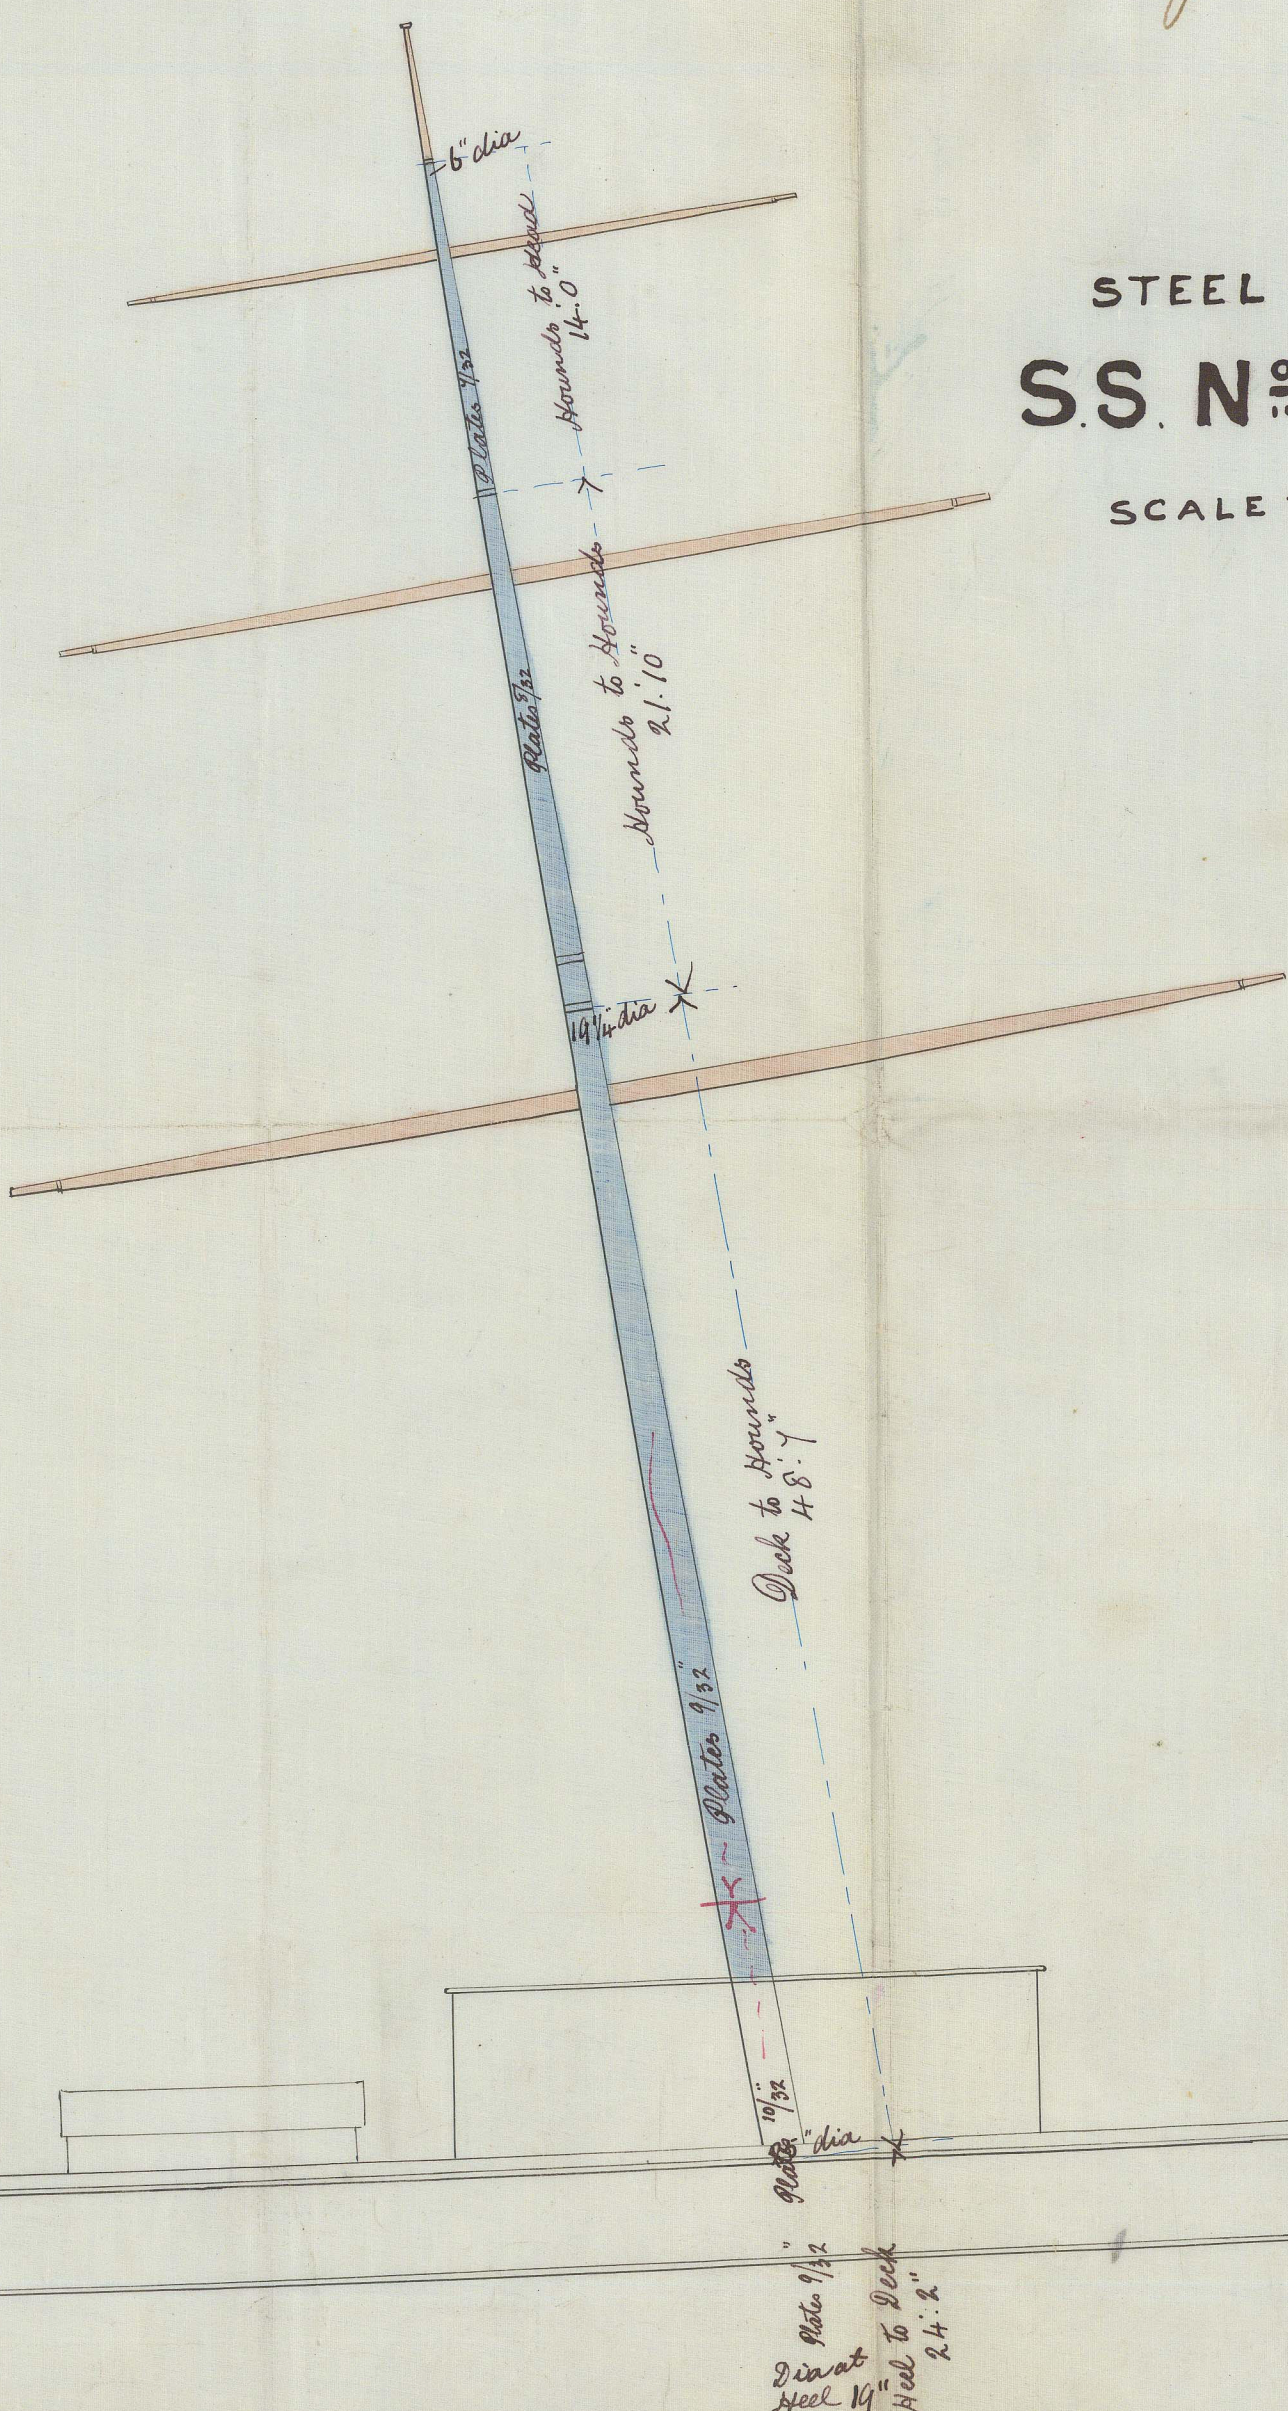

Note: Masts of Steel 3 plates in the round,
Landings 3 3/4" double riveted to hounds,
2 1/2" single " above "
Rivets 7/8" throughout, spaced 5 diameters apart,
Plates double riveted below deck, treble above,
Doubling plates at deck & hounds.

Dr. to Gls.
19/2/83