


RECEIVED 14th OCT. 82.
L.H. Cresson
L.H. Cresson
5/10/82.
21/8/83

—S. S. "N^o 258"—

20.12.02 Side lights are only approximate & go between frames

Glasgow Report No. 6309.

³² It is possible the after Engine, B.H.^d may be shifted from 6 to 8 feet ^{from} of this, midship thickness of shell plating to be shifted forward in same relation to B.H.^e

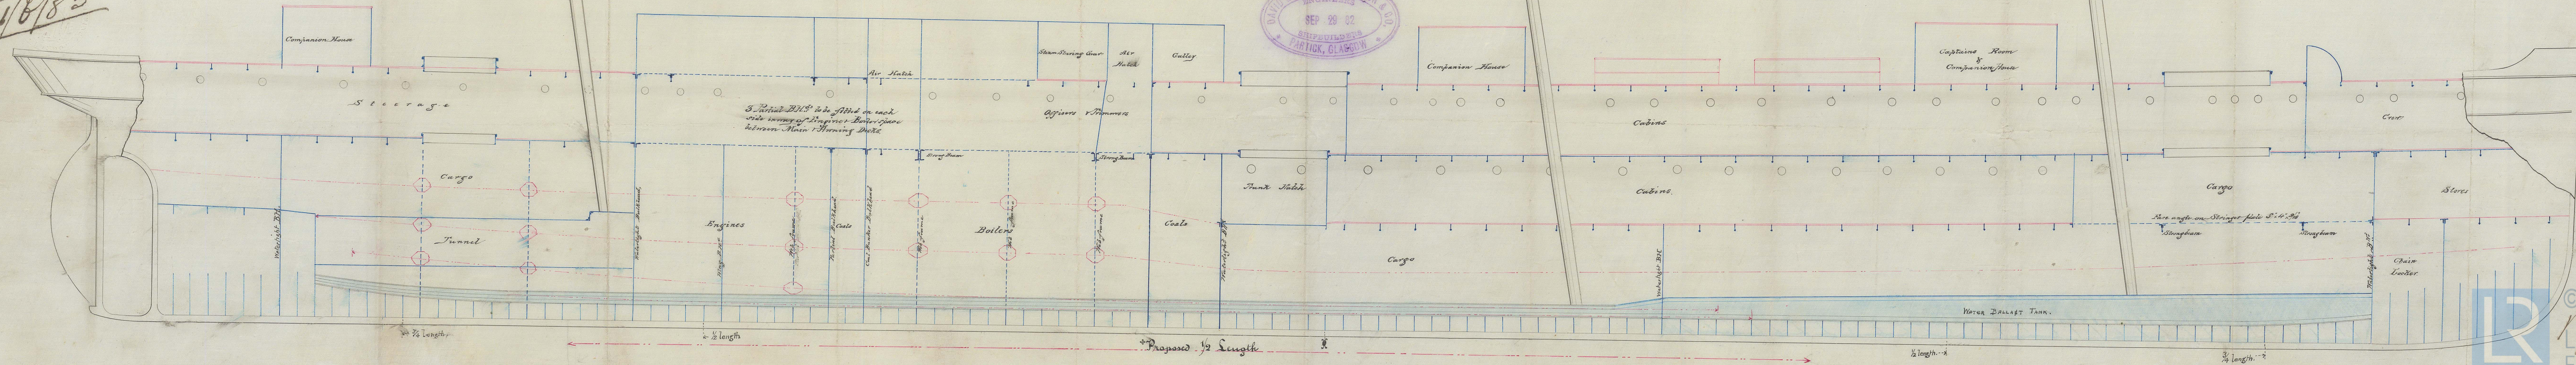

GLS196-0121