
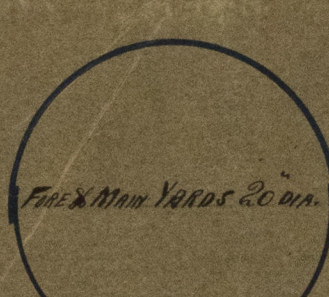
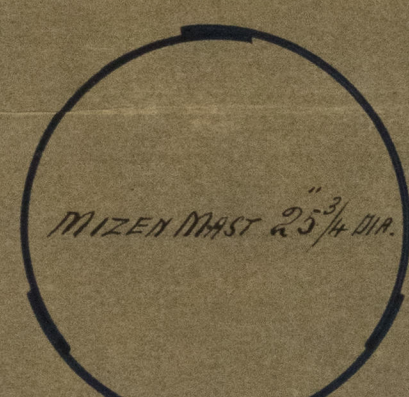
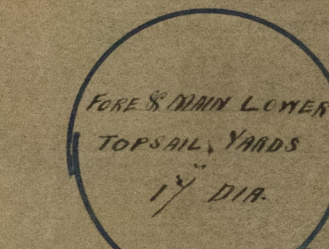
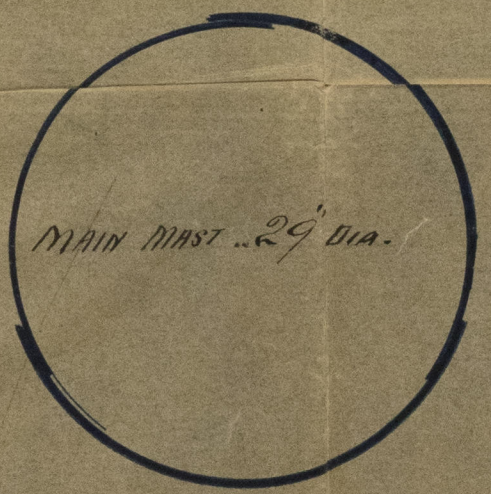
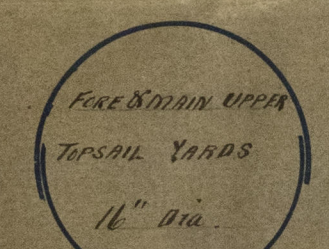
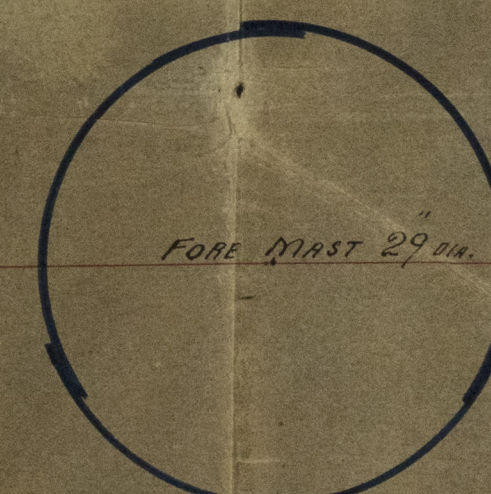
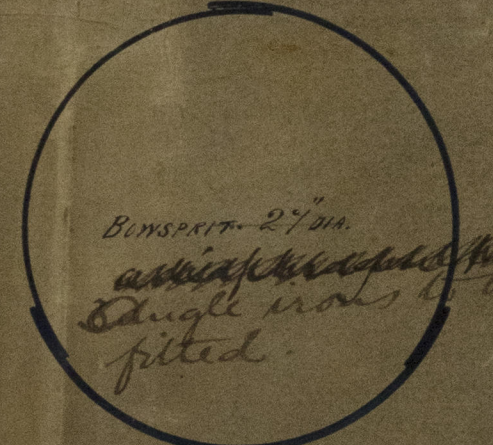


S. S. "Derry Castle"
Glasgow Report
No. 6310

Dr. A. Glasgow
8/1/83
24/6/83

Mr. J. P. [illegible]
[illegible]
[illegible]

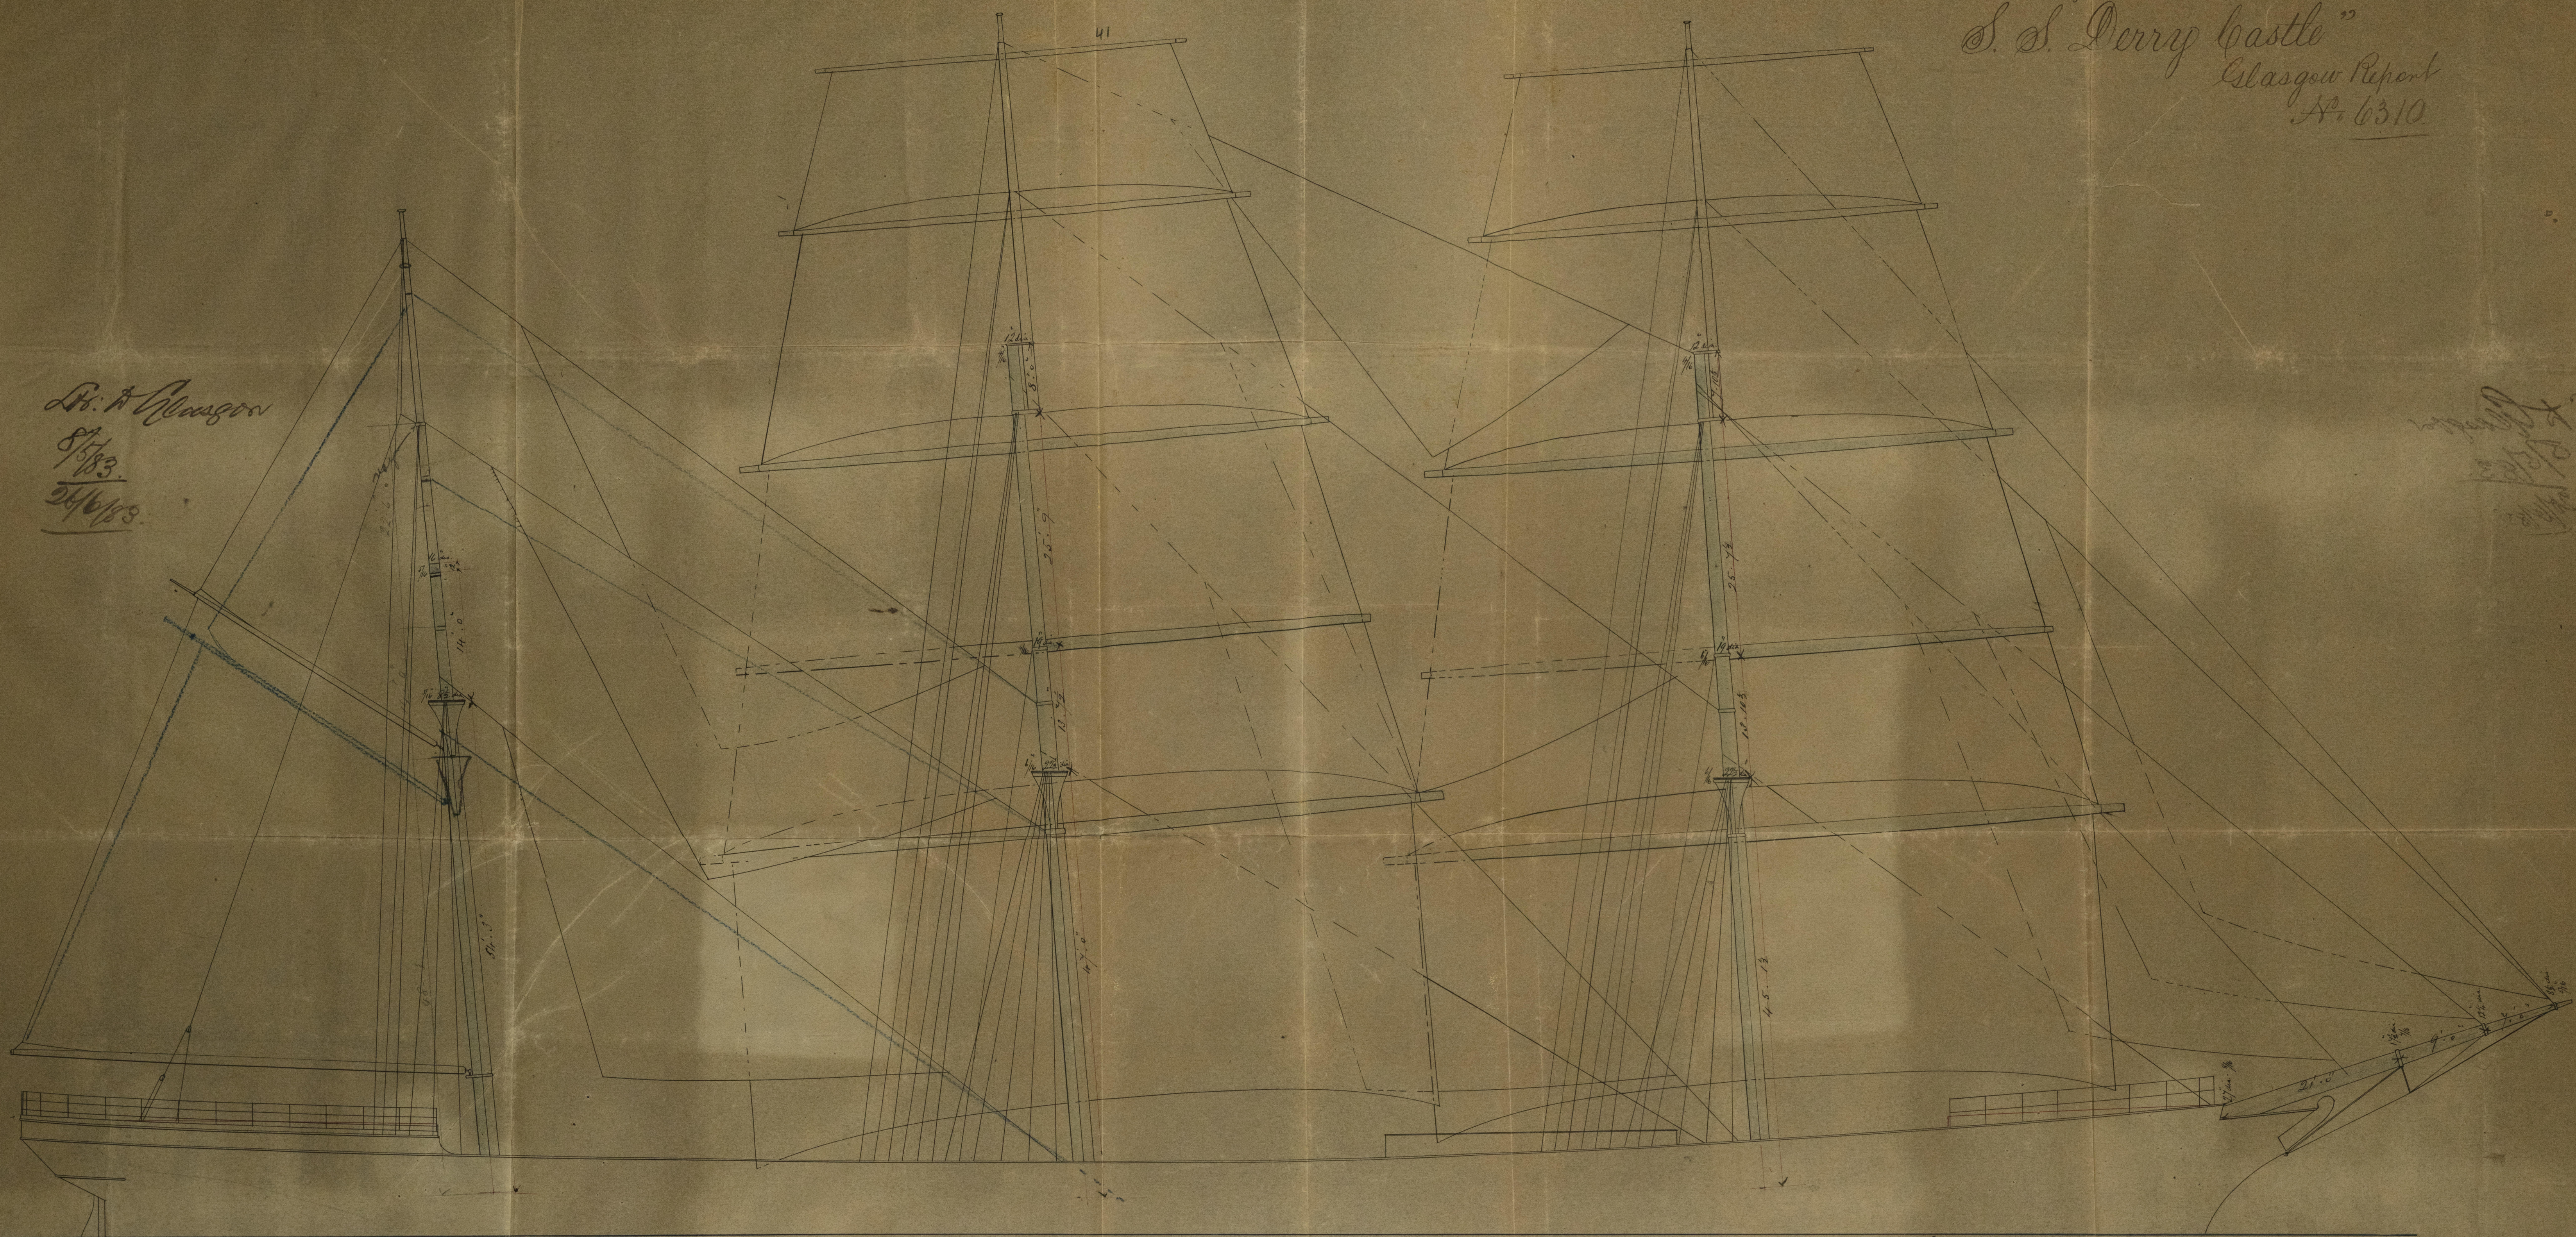



No. 6310

Hi to Glasgow
8/5/83.
20/6/83



© 2021

GLS196-0122

Lloyd's Register
Foundation