RECEIVED 9th MAR. 83.
RECEIVED 7th MAY, 83.
REC[illegible] Y, 83.
LLOYD'S REGISTER OF SHIPPING 25 JUN. 83 LONDON COPY DRAWING No 988

Lth: & Glo.
15/8/83
8/5/83.
26/6/83.

Half Midship Section of Iron Sailing Vessel "Derry Castle"

To Class 100 A1 at Lloyds

Lloyds Dimensions 230·00 × 35·78 × 23·40

Register " 240·00 × 36·00 × 21·5

Glasgow Report
No. 6310

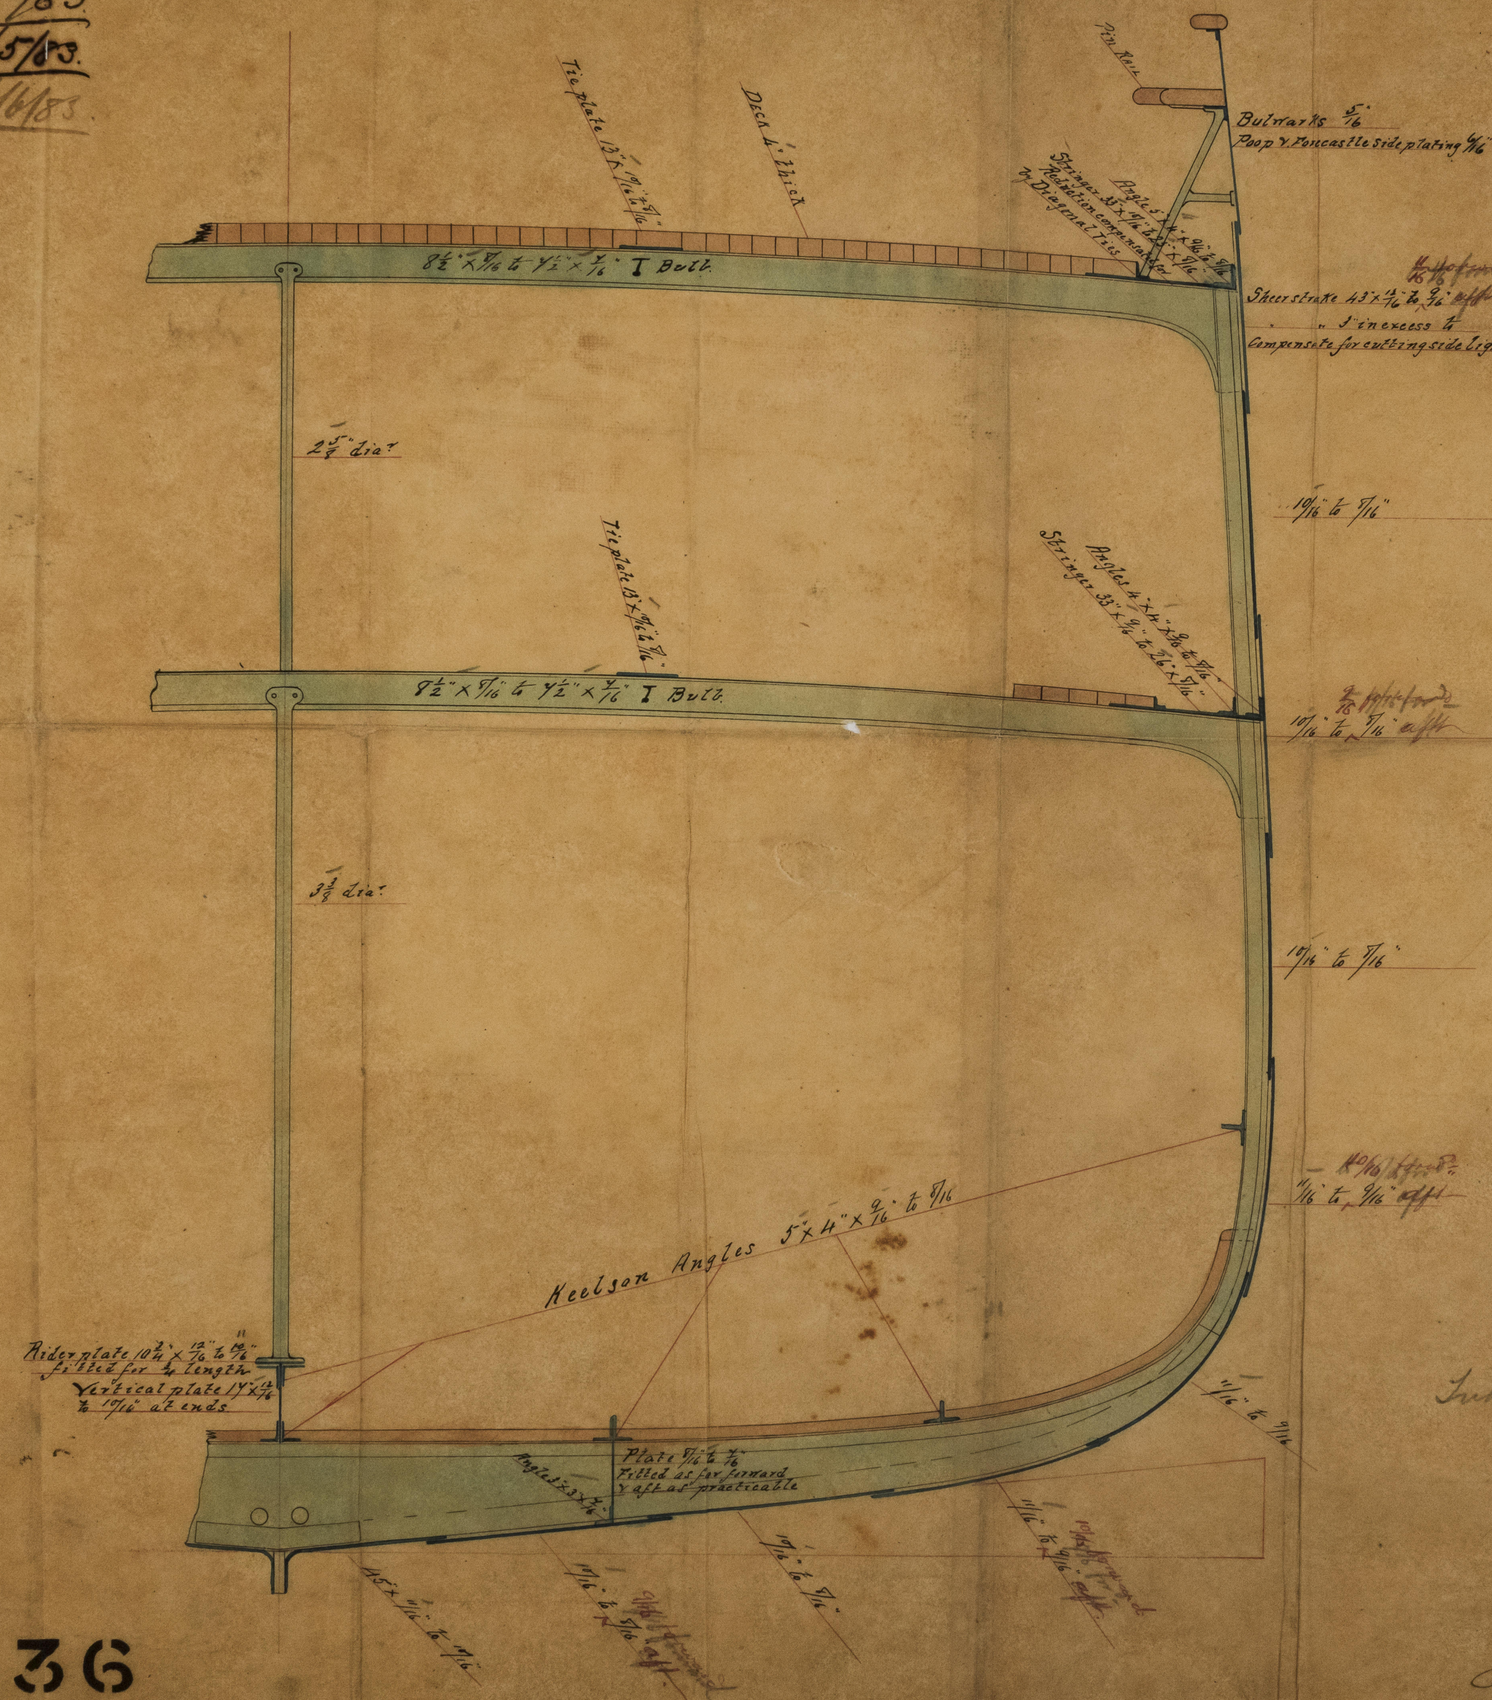

SCALE ½ INCH = 1 FT

Proportions

Depths	9·7
Breadths	6·4

Numerals

½ Girth	34·20
½ Breadth	14·89
Depth	23·40
	78·79
	230
	2363·40
	1575·5
	1812·140
+ 1/15	120·8
	1932·940

Scantlings

Keel	9" × 2½"
Stern Post	8½" × 2½"
Stem	8½" × 2½"
Rudder	6" dia at head 5" dia at heel.
Frames	5" × 3" × 9/16" to 5" × 3" × 7/16"
Reverse Frames	3½" × 3" × 7/16" All extending to Gunwale and as alternate frames to the Forecastle & the deck
Floors	24" × 9/16" to 7/16"
Bulkhead Plating	7/16" to 6/16"
" Angles	3½" × 3" × 9/16"
Forecastle Beams	6½" × 9/16" T Butt
Stringer	22" × 6/16" Tie Plate 10" × 6/16
Poop Beams	6½" × 3" × 8/16 Angle
" Stringer	22" × 6/16"
Ceiling	2½" thick

The Butt straps of Main Deck Stringer Plate Sheer Strake, & 4 strakes of plating round bilges to be 1/16" thicker than the plates they connect & to be riveted for ½ vessels length amidships.

1⅛" Rivets in Keel
⅞" " throughout in Sheer
⅝" " for Poop, Forecastle & Bulwarks

Equipment

2 Bower Anchors	32 cwt ex Stock
1 "	27¼ " " "
1 Stream "	10½ " " "
1 Kedge "	5½ " " "
1 " "	2½ " " "
270 Fathoms	1 1/16 Stud Chain Cable
75 "	1 Stream Chain
90 "	3½ Steel Towline
90 "	9½ Hawser
90 "	6" Warp

Bulkheads of strokes securely knees

DOBIE & CO.
SHIPBUILDERS
GLASGOW

14/3/83

7/5/83
M.D.

No 136

© 2021 Lloyd's Register Foundation
GLS196-0123