


RECEIVED 2nd JAN. 83.
RECEIVED CHAPL. 83.

*Mr. D. Gles.
3/1/83.*

PROFILE S.S. N° 280.

S.S. "Cuterpe" Glasgow Report N° 6314.

*m
9.4.83*

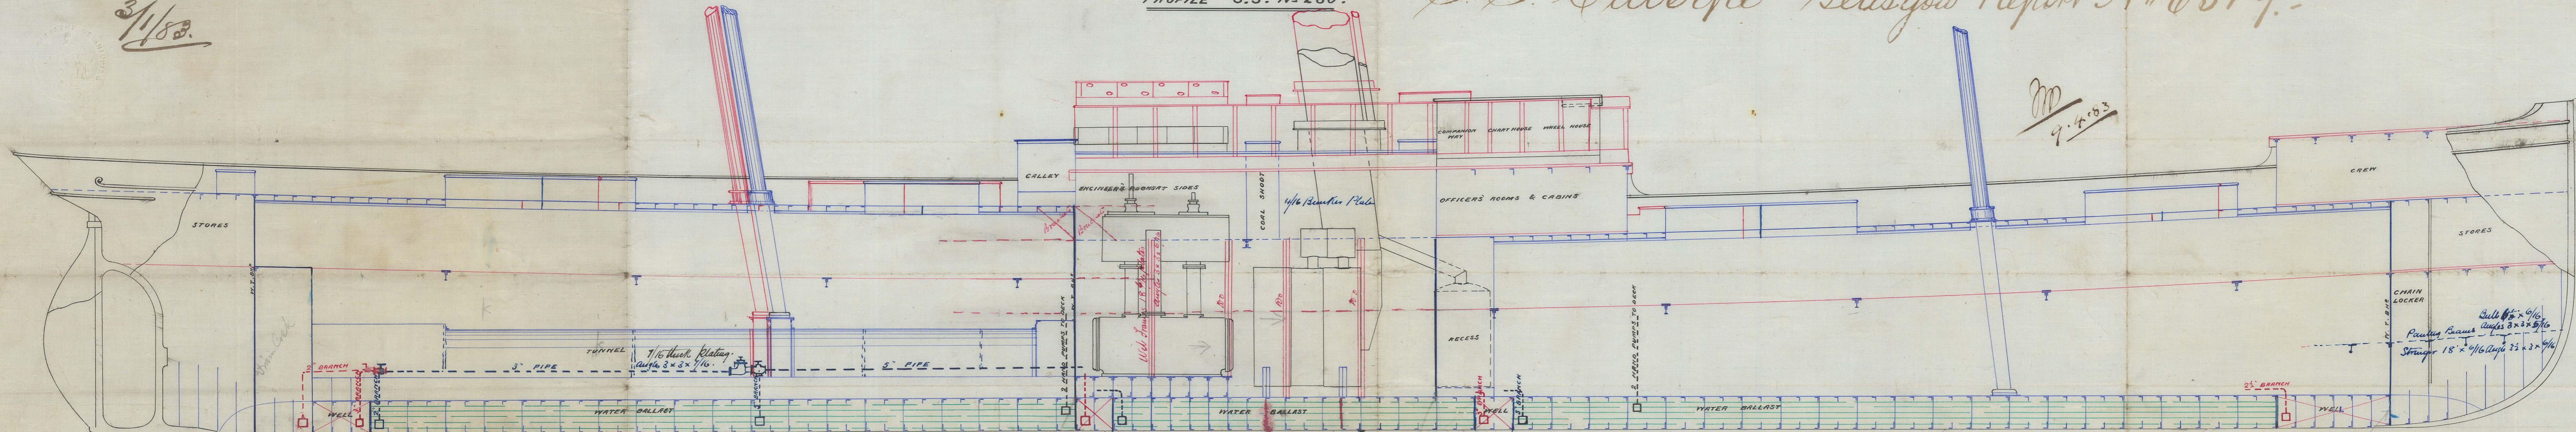

DRAWING N° 2863
SCALE 1/8" INCH TO A FOOT
*29/12/82
m*

PUMPING ARRANGEMENT
PUMPS SHOWN IN BLACK ARE HAND PUMPS TO DECK 5" CHAMBERS PIPES 2 1/2" DIA.
DO DO DO BLUE DO WATER BALLAST SUCTIONS TO ENGINE DO DIA.
DO DO DO RED DO HOLD SUCTIONS TO ENGINE DO DIA.

*Strong Beams in E.B. Space as hereafter
may be changed to the Surveyors satisfaction.
Solid floor plates*

Alex. Stephen & Sons
SHIPBUILDERS & ENGINEERS
GLASGOW

2/1/83