


at 6 hrs
2/4/83
to 17/4/83

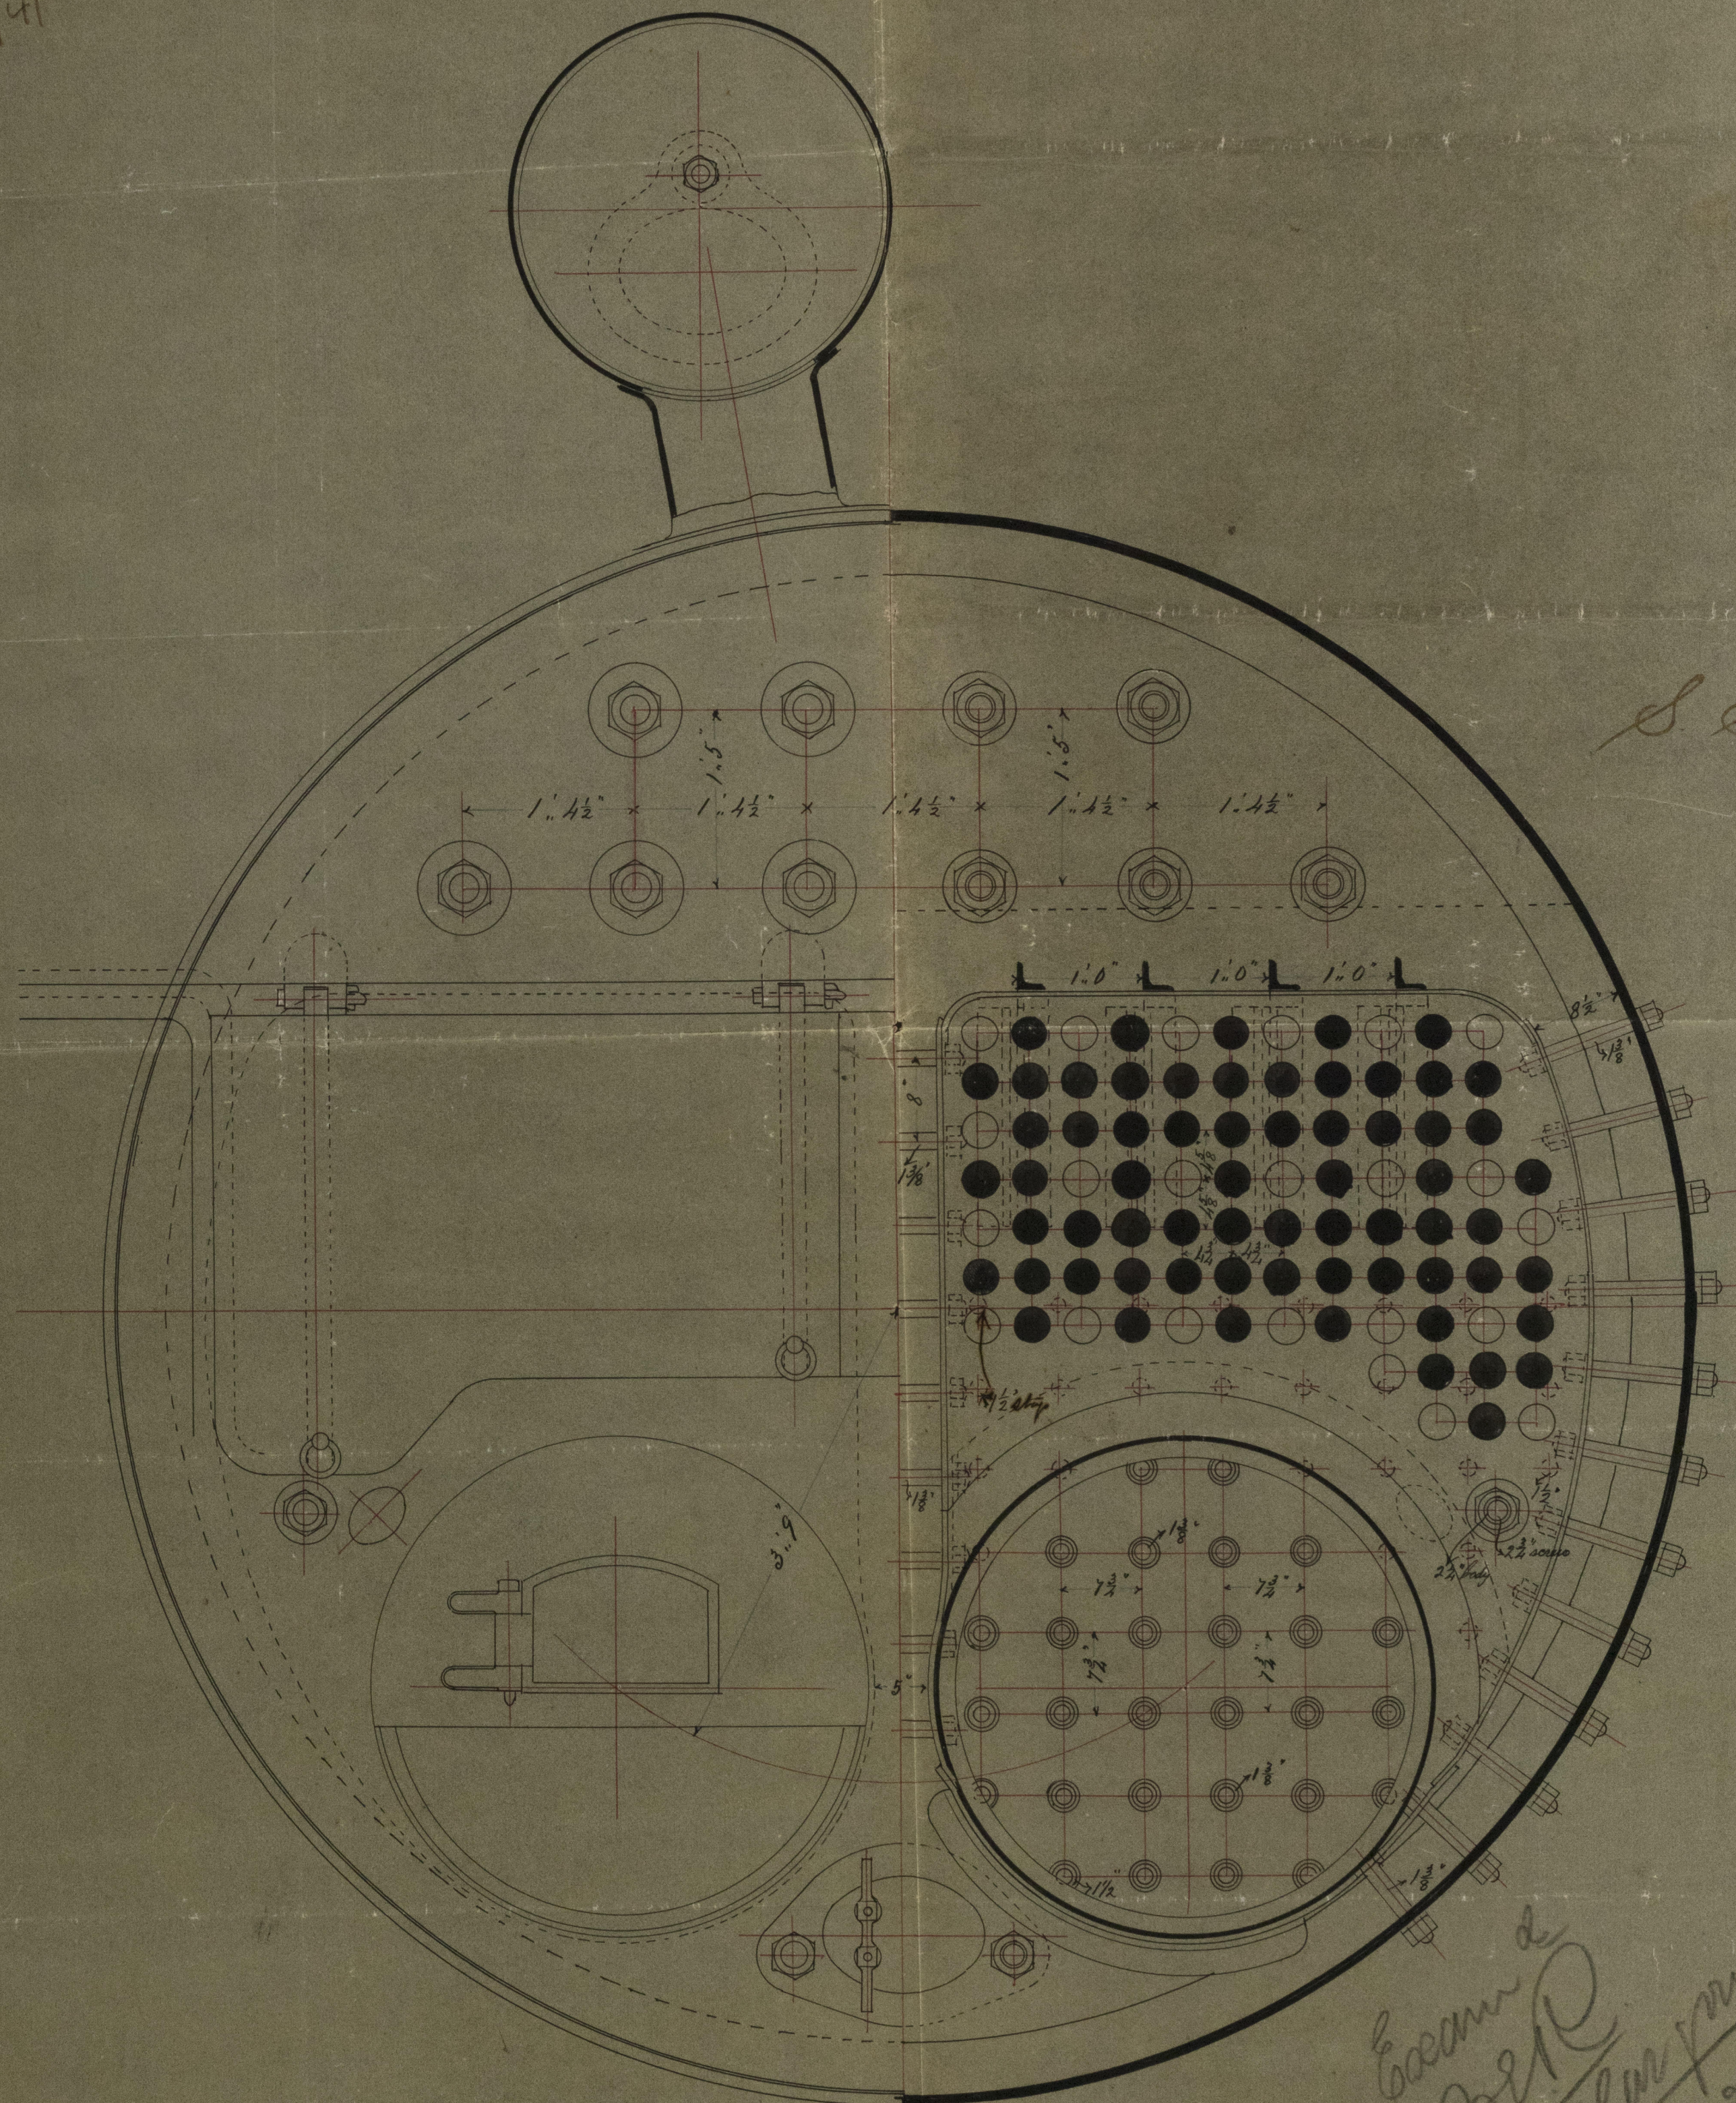


S.S. "Gutorpo"
Glasgow Report
No. 6314

No 280

SCALE 1 INCH TO A FOOT

Exam'd
2/4/83
2/4/83

Boiler 12'-6" dia x 11'-0" long
Working Pressure 80 lbs tested to 160 lbs
Circumferential seams double riveted
Longitudinal " " welded except two
in Middle Course which are double butt-
welded and double riveted
Studs 1 1/8 dia (when closed) 4/10 pitch

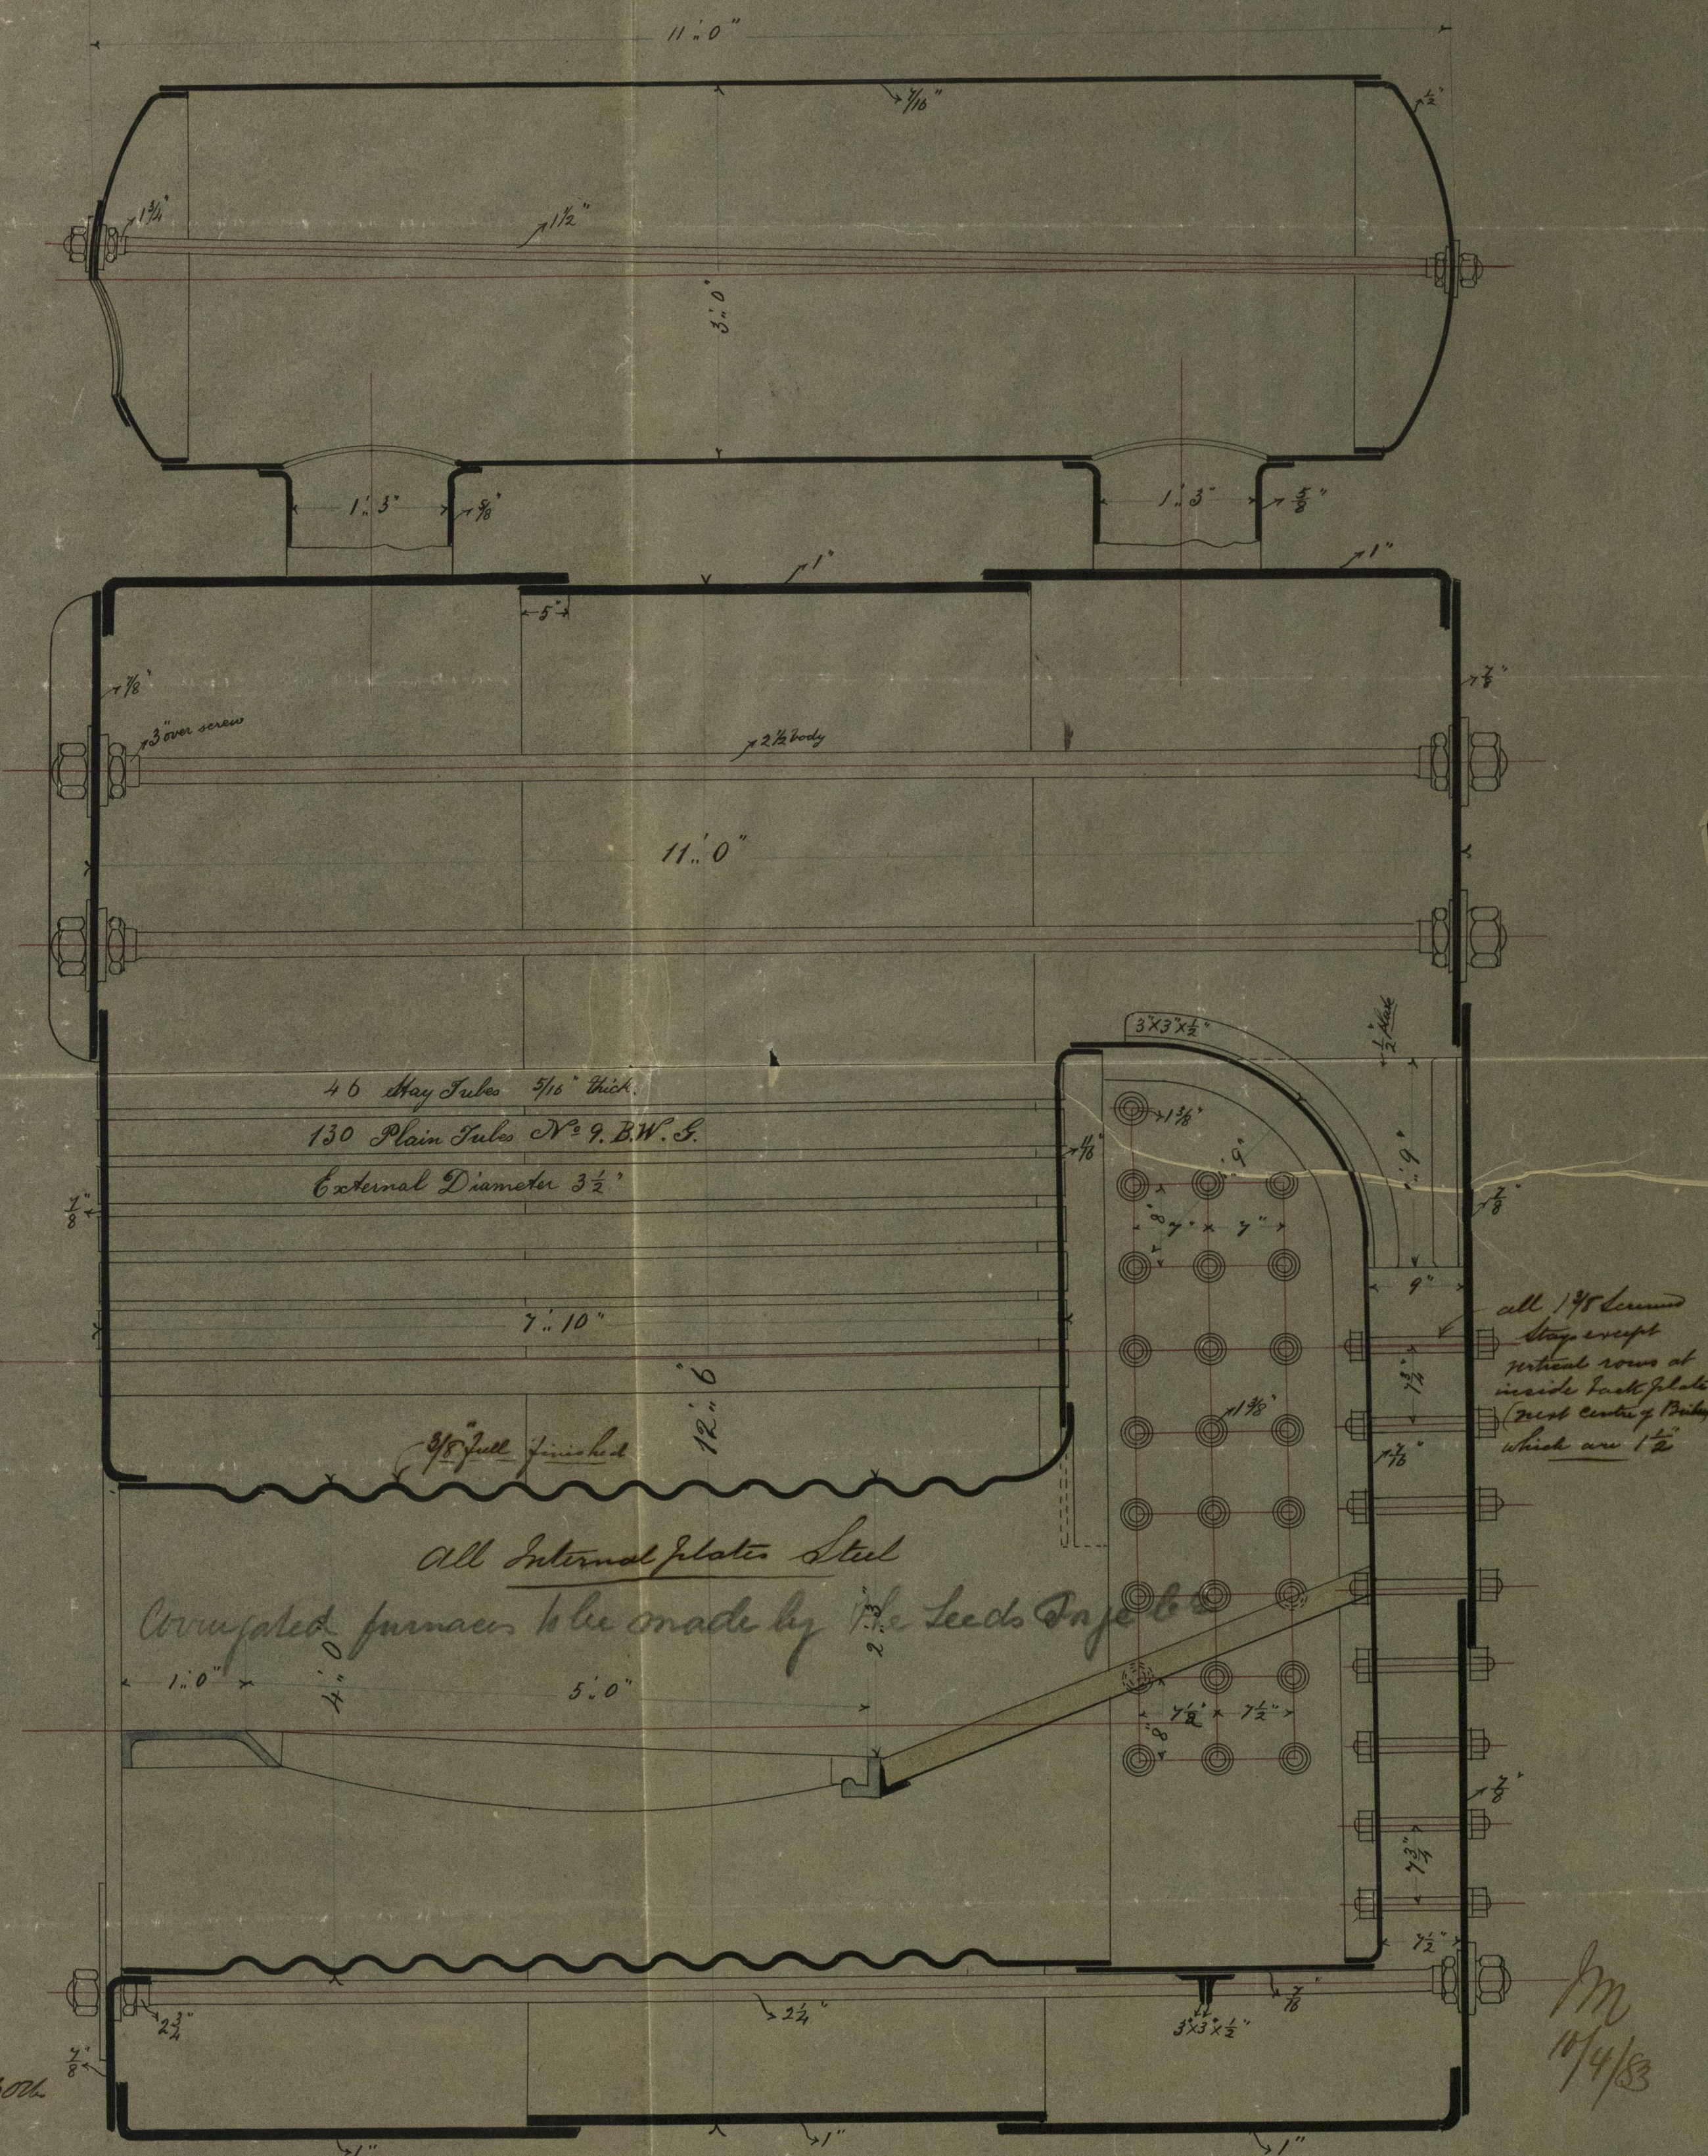

46 Stay Tubes 5/16" thick.
130 Plain Tubes No. 9, B.W.G.
External Diameter 3 1/2"

All Internal plates Steel
Corrugated furnace to be made by Leeds Forge Co.

all 1/8" seams
stay except
vertical rows at
inside back plate
which are 1/2"

17/4/83