



Dr. B. G. L.
14/3/83.

Ship "Solankhe" Glasgow Report No. 6257.
Ship "Maediarmid" do 6347

Deck 3
Deck 4

— Length B. P. 244.0 —
— Breadth M^d 37.11 —
— Depth of Hold 22.6 —
— Depth M^d 24.9 —

Ship No. 250
Midship Section
Scale 1/2" = one foot

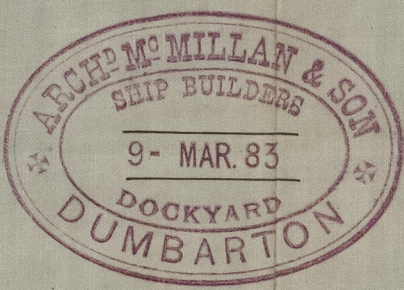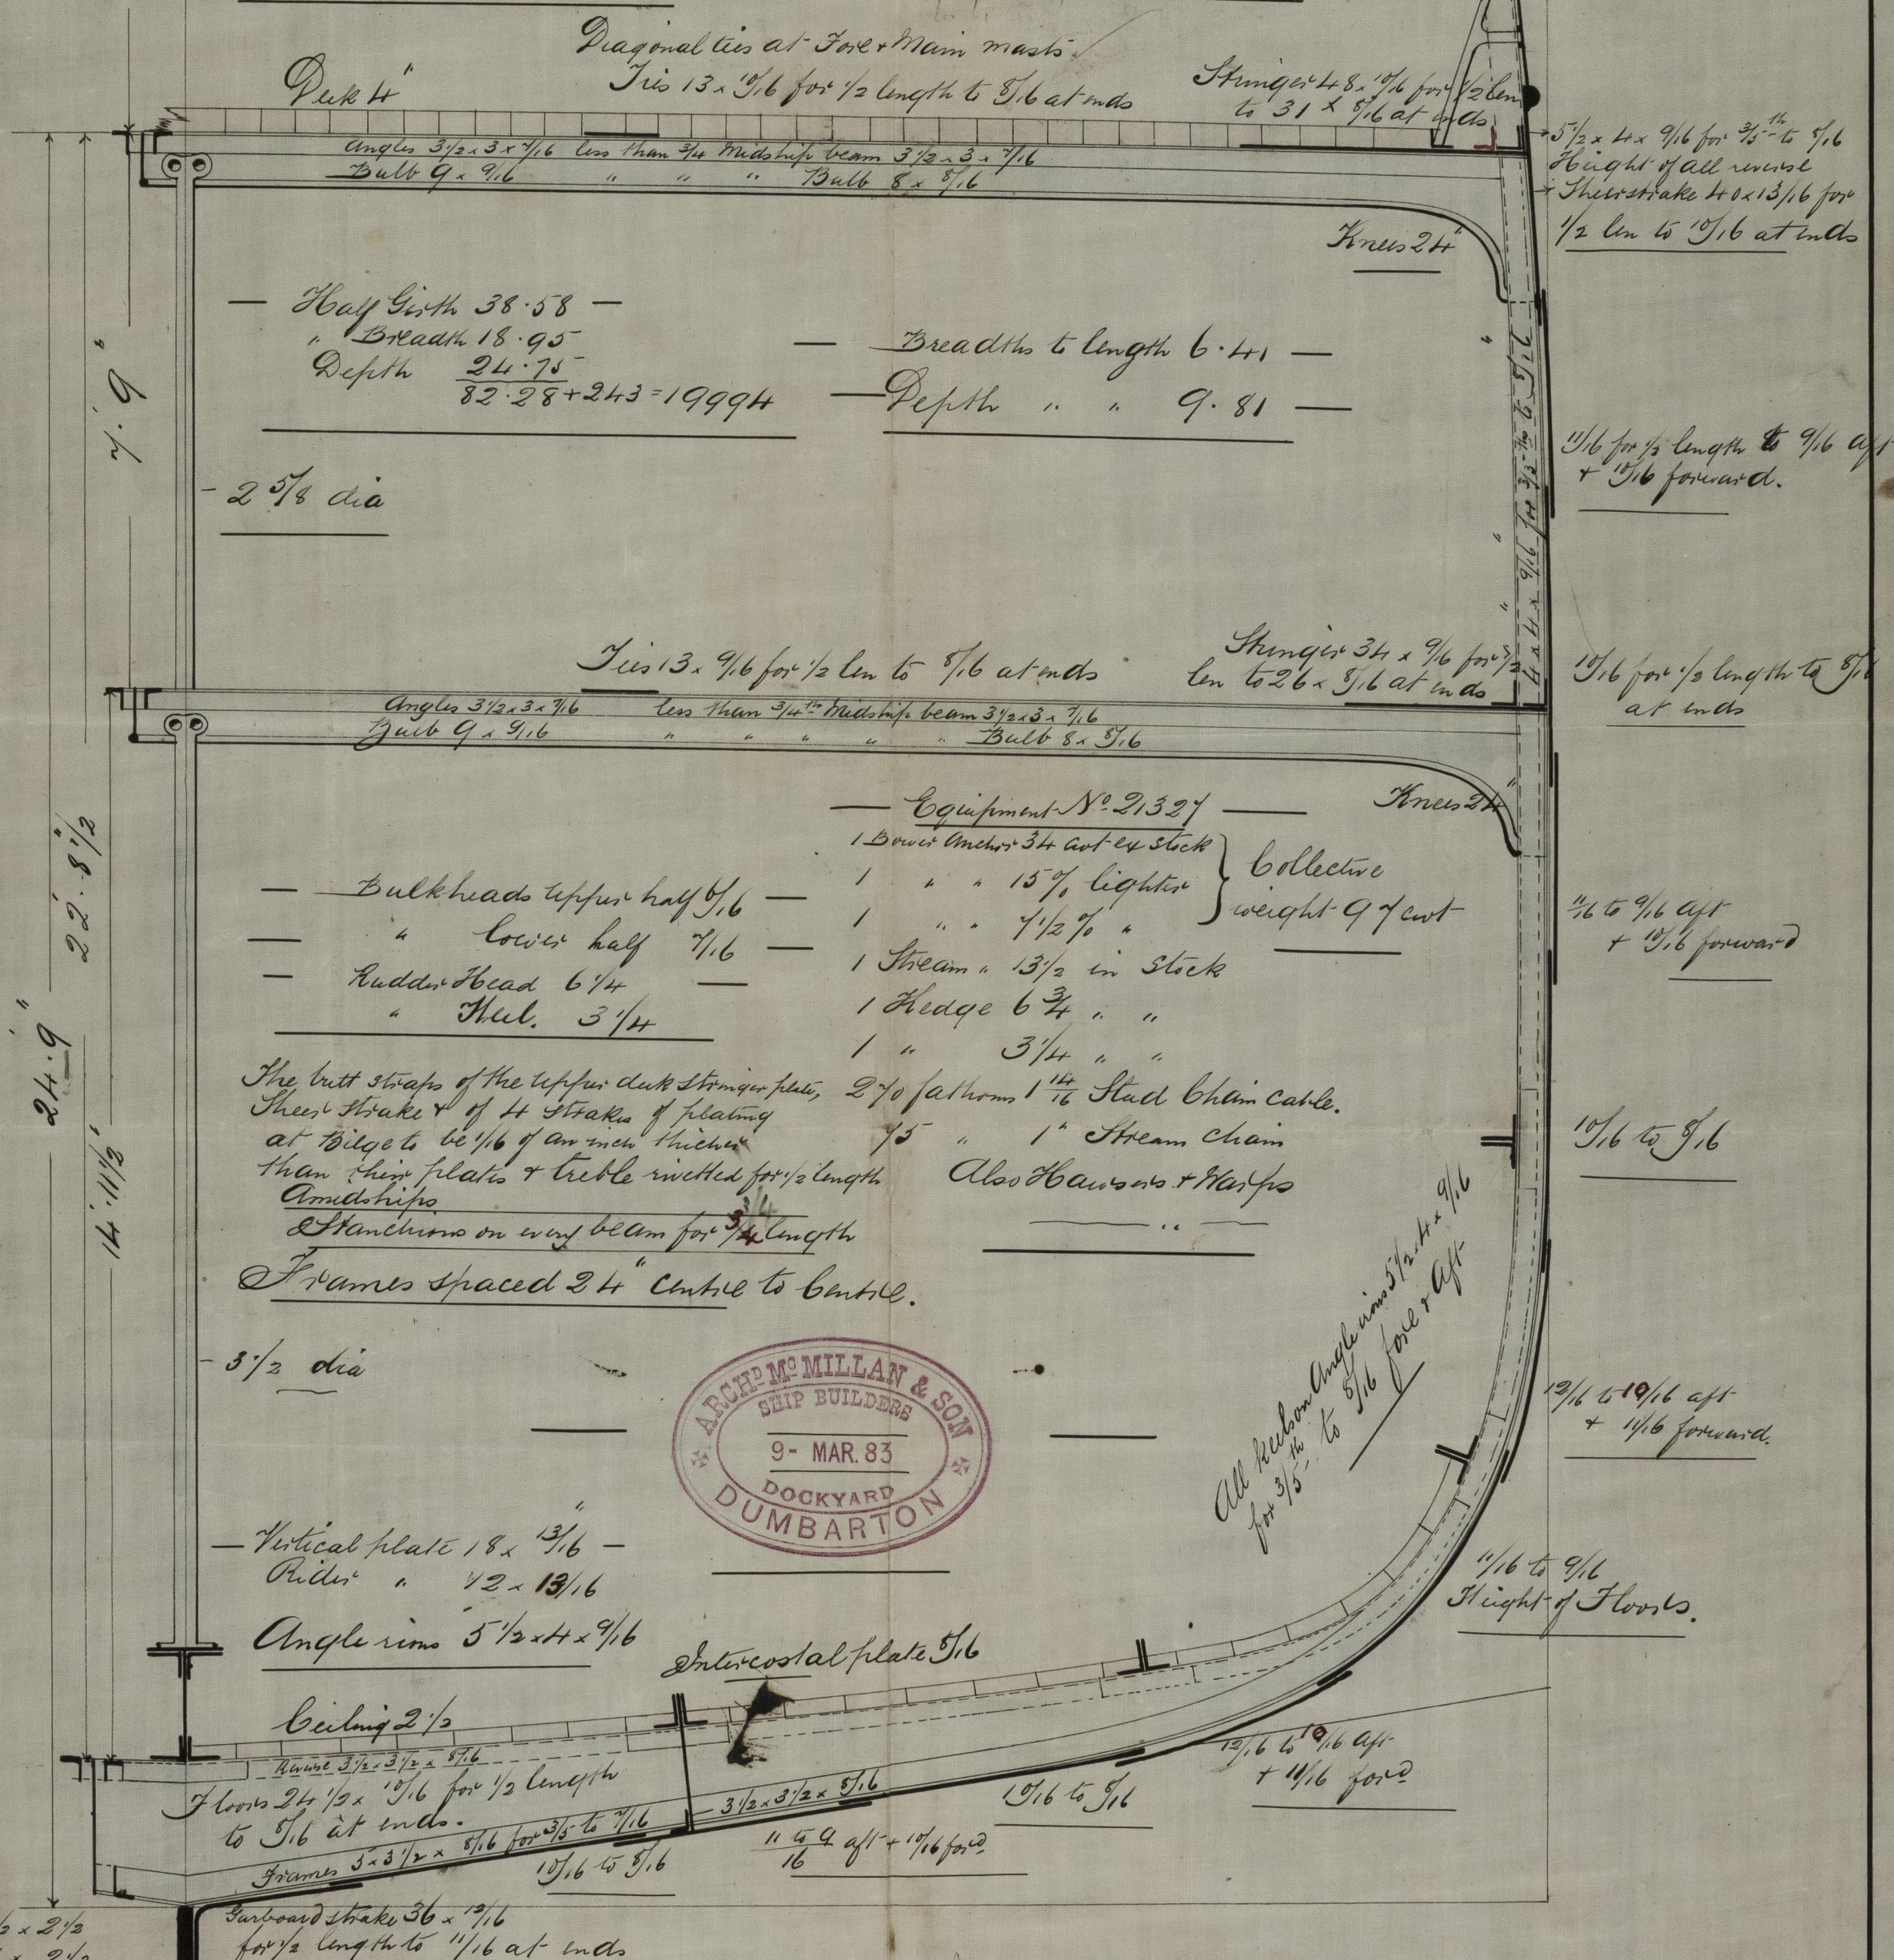

J. G. L.
13/3/83