

REGISTRY OF SHIPPING
 23 AUG. 83
 LONDON

(Received in the London Office,

P. _____
 No. 86 REPORT ON SHIP FORGINGS.

Sir,

I beg leave to report that the undermentioned Forgings, manufactured by
The Govan Forge Co of Glasgow
 for the Vessel No. 282, being built by Messrs John Elder & Co
 of Glasgow have been inspected by me in course
 of being forged and smithed, and found to be, so far as can be seen, sound and
efficient

M 23/8/83

Mark on Forging.

Lloyd's
 No. 86
 G.N

I am, Sir,


Your Obedient Servant,

George Newcomb
Glasgow

The Secretary,
 London.

	STERN FRAMES.	RUDDER FRAMES.	STEMS.
Material* - - - -	<i>Scrap iron</i>	/	/
How made - - - -	<i>Forged</i>		
Dimensions - - - -	<i>11" x 4"</i>		
Progress on Inspection -	<i>Forged & smithed</i>		
Dates when Inspected -	<i>6.11.30/4/83. 9.11.25/7/83 4.10.13.17/8/83.</i>		

SKETCHES OF FRAMES SHEWING POSITION AND DESCRIPTION OF WELDS.

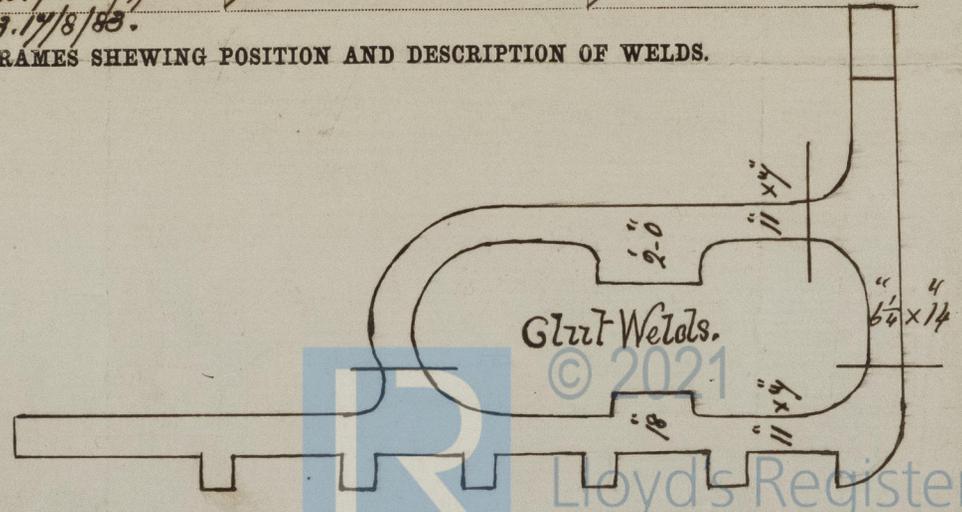

* If of iron, state whether scrap or puddled iron.