

Glasgow Report No 6341

Lloyd's Register of British and Foreign Shipping.

(Received in the London Office,

F.

No. 86

REPORT ON SHIP FORGINGS.

Sir,

I beg leave to report that the undermentioned Forgings, manufactured by
The Govan Forge Co of *Glasgow*
 for the Vessel No. 282, being built by *Messrs John Elder & Co*
 of *Glasgow* have been inspected by me in course
 of being forged and smithed, and found to be, so far as can be seen, *sound and efficient*

D.G.
12/11/83

Mark on Forging.

Lloyd's

No. 86

G.N

The Secretary,
London.

I am, Sir,


Your Obedient Servant,

George Newcomb

Glasgow

	STERN FRAME.	RUDDER FRAME.	STEM.
Material*		Scrap iron	
How made		Forged	
Dimensions		98 4 1/2	
Progress on Inspection		Forged & smithed	
Dates when Inspected		25/4/83. 11.19/9/83. 3.11.18. 23.30/10/83. 8.9/11/83.	

SKETCHES OF FRAMES SHEWING POSITION AND DESCRIPTION OF WELDS.

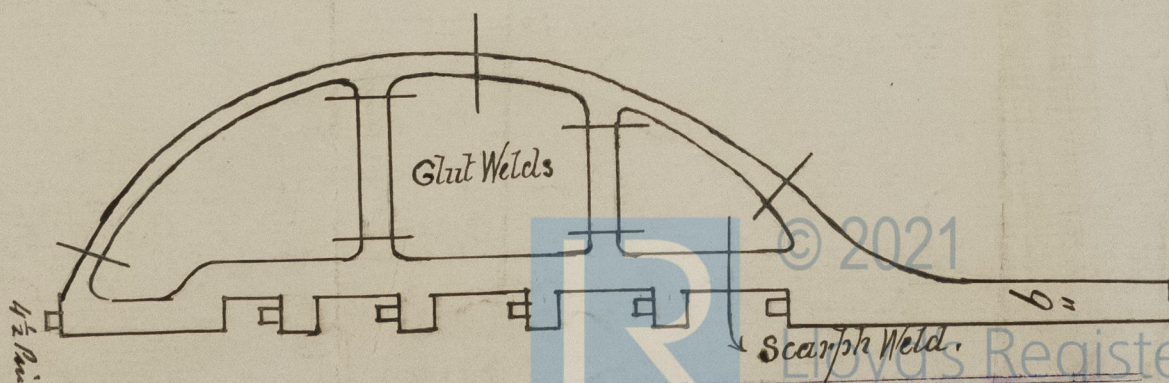

* If of iron, state whether scrap or puddled iron.