


Glasgow Report No. 6405.

Lloyd's Register of British and Foreign Shipping.

(Received in the London Office,

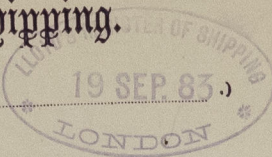

F.

No. 450

REPORT ON SHIP FORGINGS.

Sir,

I beg leave to report that the undermentioned Forgings, manufactured by The Dennystown Forge Co of Dumbarton for the Vessel No. 252, being built by Messrs A. Mc Millan & Son of Dumbarton have been inspected by me in course of being forged and smithed, and found to be, so far as can be seen, sound and efficient

Mark on Forging.

Lloyd's

No. 450

G.N

I am, Sir,

Your Obedient Servant,


George Newcomb

The Secretary,
London.

Glasgow

| | STERN FRAME. | RUDDER FRAME. | STEM. |
|--------------------------|--|---------------|-------|
| Material* - - - - | Scrap iron | | |
| How made - - - - | Forged | | |
| Dimensions - - - - | 12 x 25/16 | | |
| Progress on Inspection - | Forged & smithed | | |
| Dates when Inspected | 10.24/7/83. 23.30/8/83. 4.10 & 13/9/83. | | |

SKETCHES OF FRAMES SHEWING POSITION AND DESCRIPTION OF WELDS.

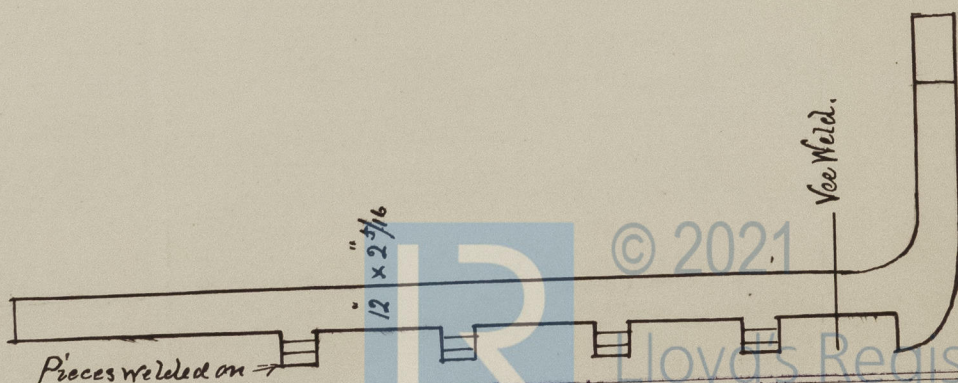

* If of iron, state whether scrap or puddled iron.