




*Dr. & Co.*  
*14/8/83.*

S. S. N<sup>o</sup> 28164

*S. S. "Glan Davidson" Glasgow Report N<sup>o</sup> 6355.*  
*S. S. "Dunedin" — do — 6449.*

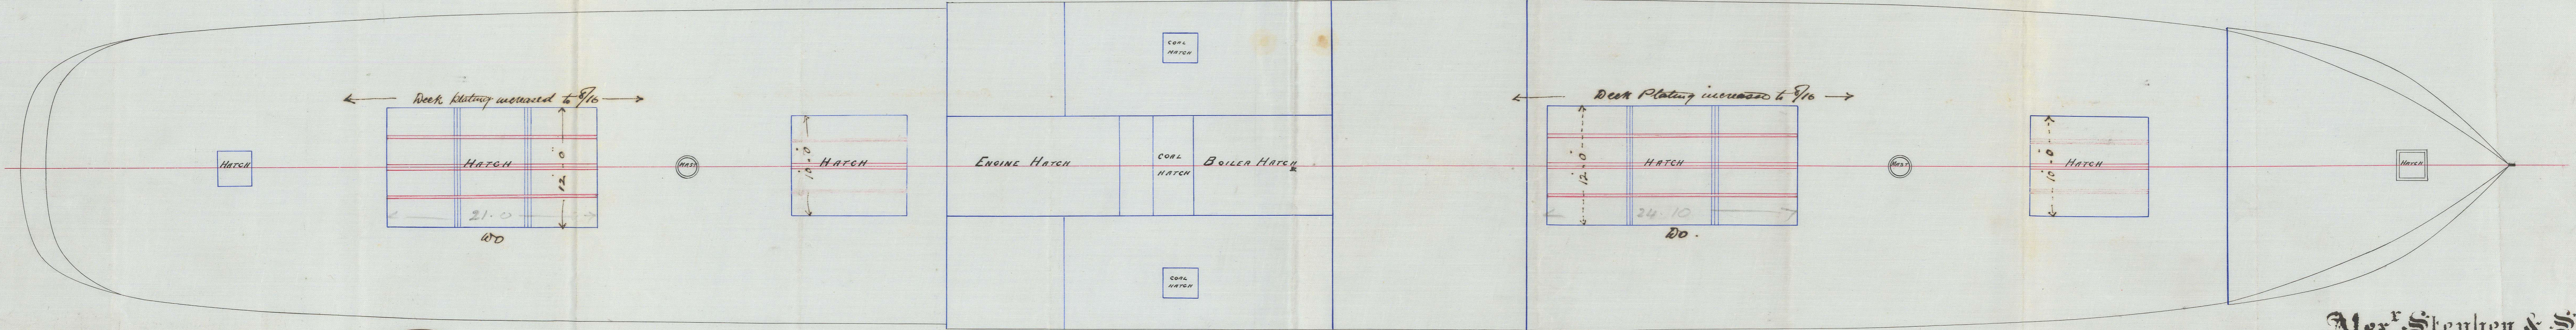

DRAWING N<sup>o</sup> 3118 10/8/83  
SCALE 1/4 INCH TO A FOOT

*14/8/83*

Alex<sup>r</sup> Stephen & Sons  
SHIPBUILDERS & ENGINEERS  
GLASGOW

