

Glasgow Report No. 6487
Lloyd's Register of British and Foreign Shipping.

(Received in the London Office,

F.

No. *581*

REPORT ON SHIP FORGINGS.

Sir,

I beg leave to report that the undermentioned Forgings, manufactured by *Messrs Wm Dixon & Co, Ltd,* of *Glasgow* for the Vessel No. *255*, being built by *Messrs A. McMillan & Son* of *Dunbarton* have been inspected by me in course of being forged and smithed, and found to be, so far as can be seen, *sound and satisfactory*

Mark on Forging.

Lloyd's
 No. *581*
G. N.

The Secretary,
 London.

I am, Sir,


Your Obedient Servant,

George Newcomb

Glasgow 2/1/84.

	STERN FRAME.	RUDDER FRAME.	STEM.
Material* - - - -	/	<i>Scrap iron</i>	/
How made - - - -		<i>Forged</i>	
Dimensions - - - -		<i>6" & 3"</i>	
Progress on Inspection -		<i>Forged and smithed</i>	
Dates when Inspected		<i>4.15.19.28/12/83.</i>	

SKETCHES OF FRAMES SHEWING POSITION AND DESCRIPTION OF WELDS.

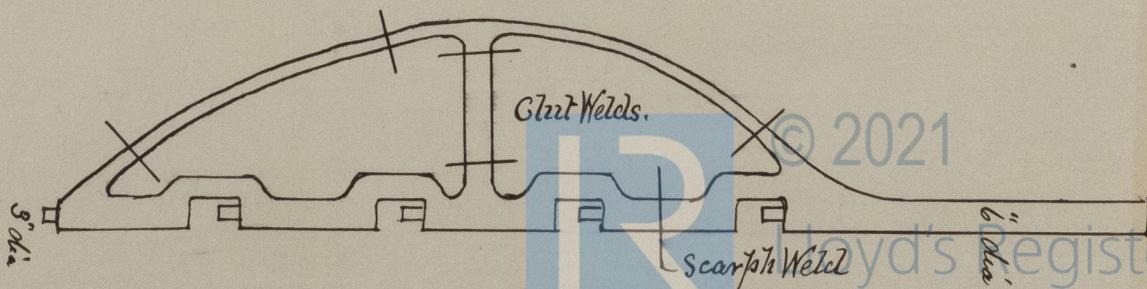

* If of iron, state whether scrap or puddled iron.