

S. S. "Copack" Glasgow Report No 6435.
 S. S. "Kingshow" do do 6442.

LOYD'S REGISTER OF SHIPPING
 10, ABchurch Lane, LONDON, E.C. 4
 1893

Str. Glasgow
 11/8/83

— STEEL MASTS AND YARDS —

— SS N° 262 No 3 —


— SCALE 1/4" = ONE FOOT —



Lower Upper Yard 2 plates in the round of steel
 seams 1/2" single riveted
 rivets 1/2" butts both riveted
 doubling plates at slings to extend beyond brass hoops
 plates 1/2" to 1/2" at ends

Lower Yard 2 plates in the round of steel
 seams 1/2" single riveted
 rivets 1/2" butts both riveted
 doubling plates at slings to extend beyond brass hoops
 plates 1/2" to 1/2" at ends

Mast 3 plates in the round of steel
 seams 1/2" double riveted to head
 3 single below
 1/2" rivets in 1/2" plates and all thicker
 1/2" rivets in 1/2" thinner
 Bulstraps both riveted 7/8" thicker than their plates above deck
 double below deck
 Doubling plates at deck 7/8" rigging hoops
 Plates 1/2" at head 1/2" at deck 1/2" at mast 1/2" main mast at deck
 1/2" to 1/2" deck to frames 1/2" head 1/2" above head to 1/2" remainder
 plates 5 diameters apart.

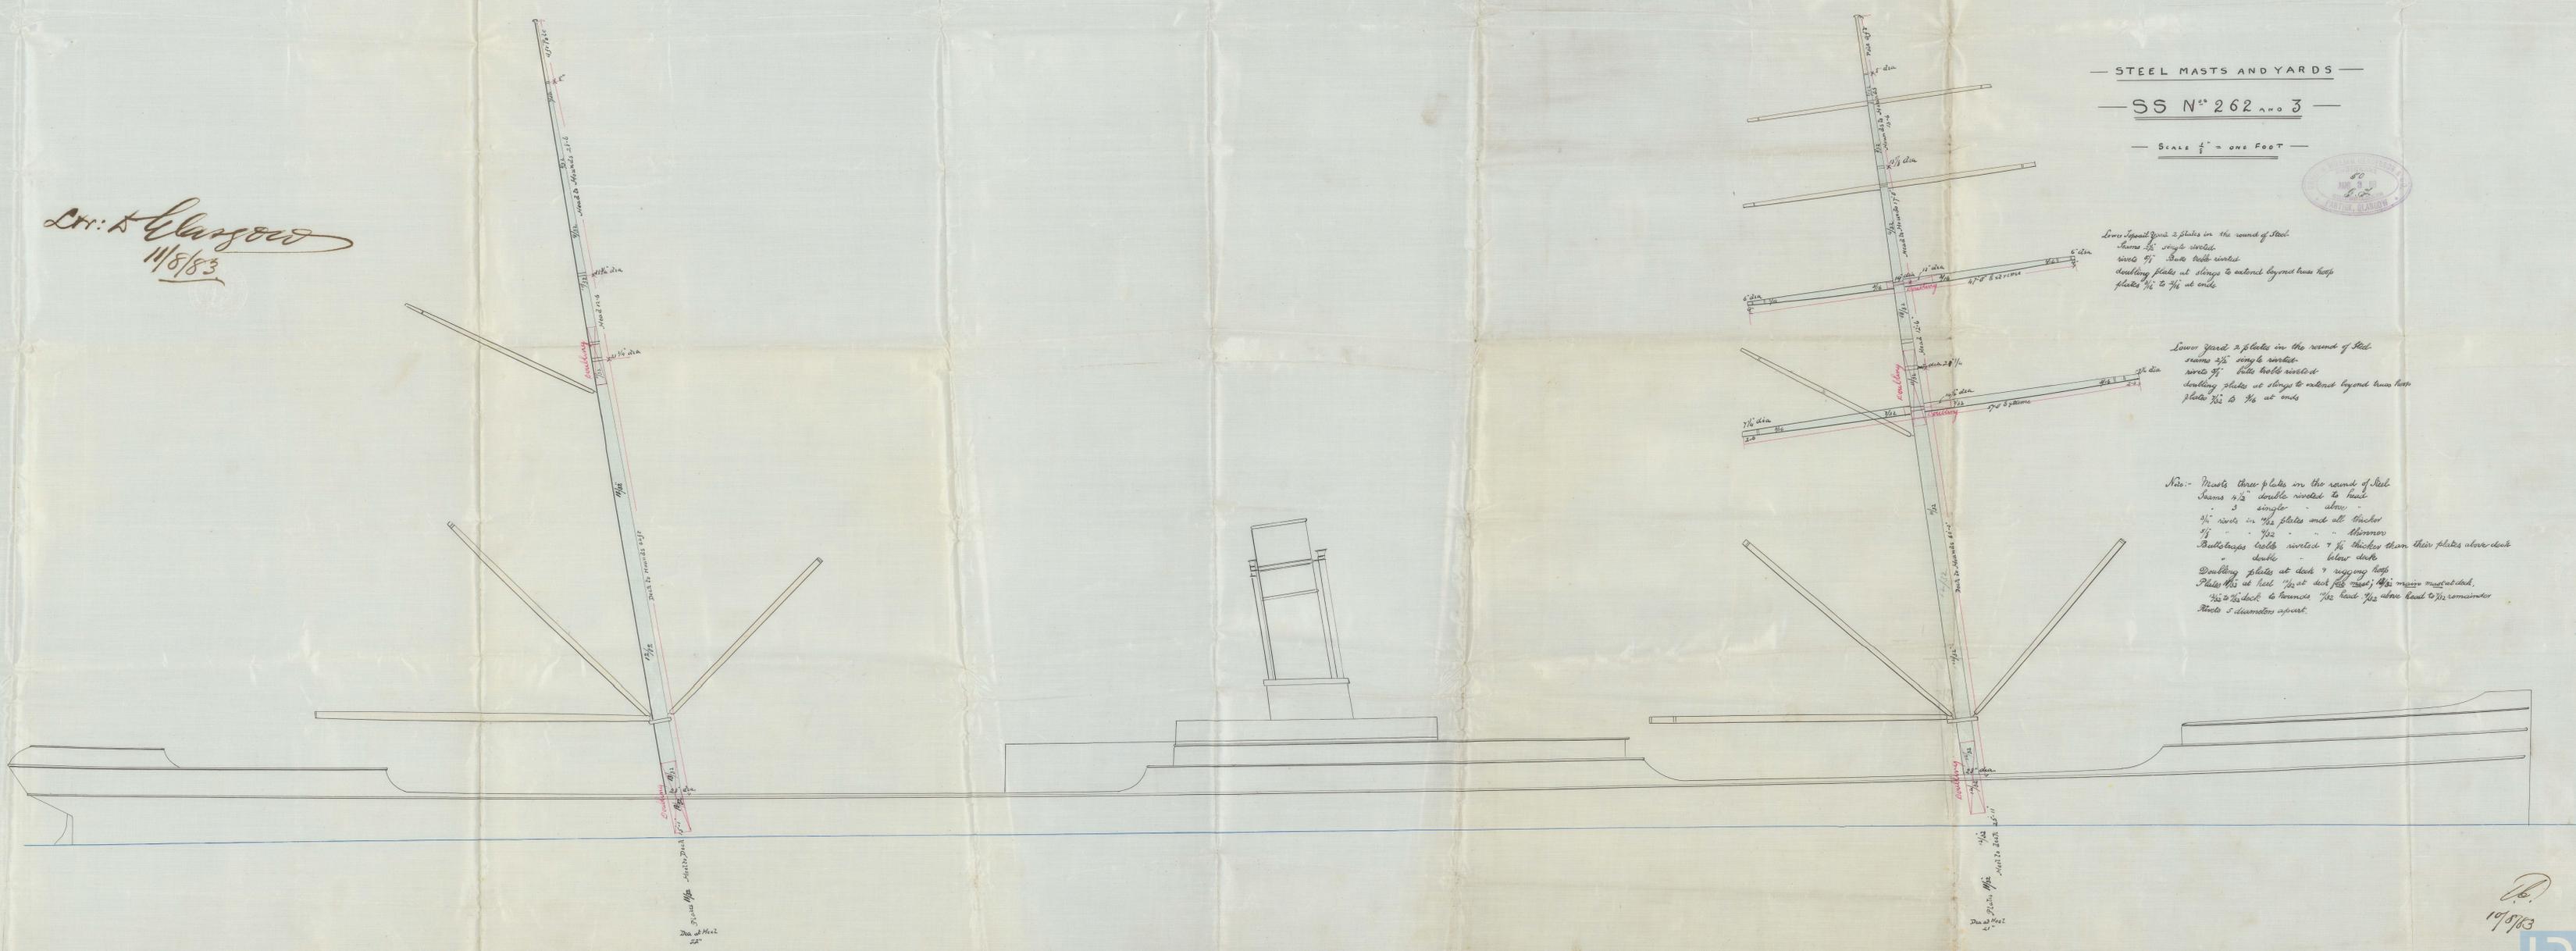

11/8/83