

RECEIVED 101 FEB. 83.
RECEIVED 24 MAR. 83.
RECEIVED 1 APL 83.

Mr. L. S. G.

20/2/83.

12/3/83.

19/4/83.


No: 262-3

S. S. "Gopack" Glasgow Report No 6435.

S. S. "Kingshow" do do 6442 Longitudinal Section

S. S. 350' x 41' 6" x 26' 3".

Scale $\frac{1}{8}$ " = One Foot.

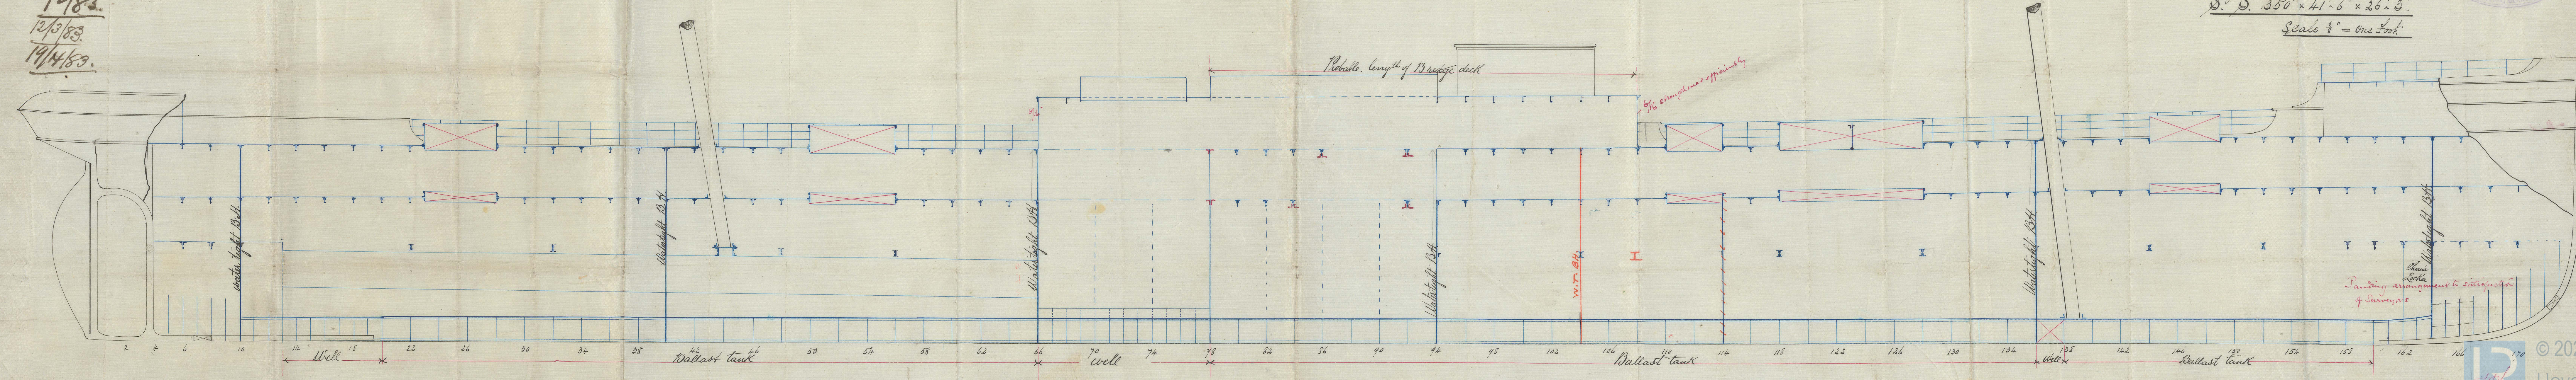

Chain Locker
Packing arrangement to satisfaction
of Surveyors

© 2021

Lloyd's Register
Foundation

GLS198-0036