

RECEIVED 20 MAR. 88.  
RECEIVED 110 APL. 88.

2 OCT. 83  
LONDON

Gr: L.L.S.

20/2/83.

12/3/83.

19/4/83

11/8/83


Ship's Section - Nos: 262-3

Builders Dimensions -  
S.S. 350 x 41.6 x 25.3 Moulded -

Scale 1/2" = one foot.

To Class 100A. 3 tested -

S.S. "Copack" Glasgow Report No 6435.  
S.S. "Kinchow" do do 6472.

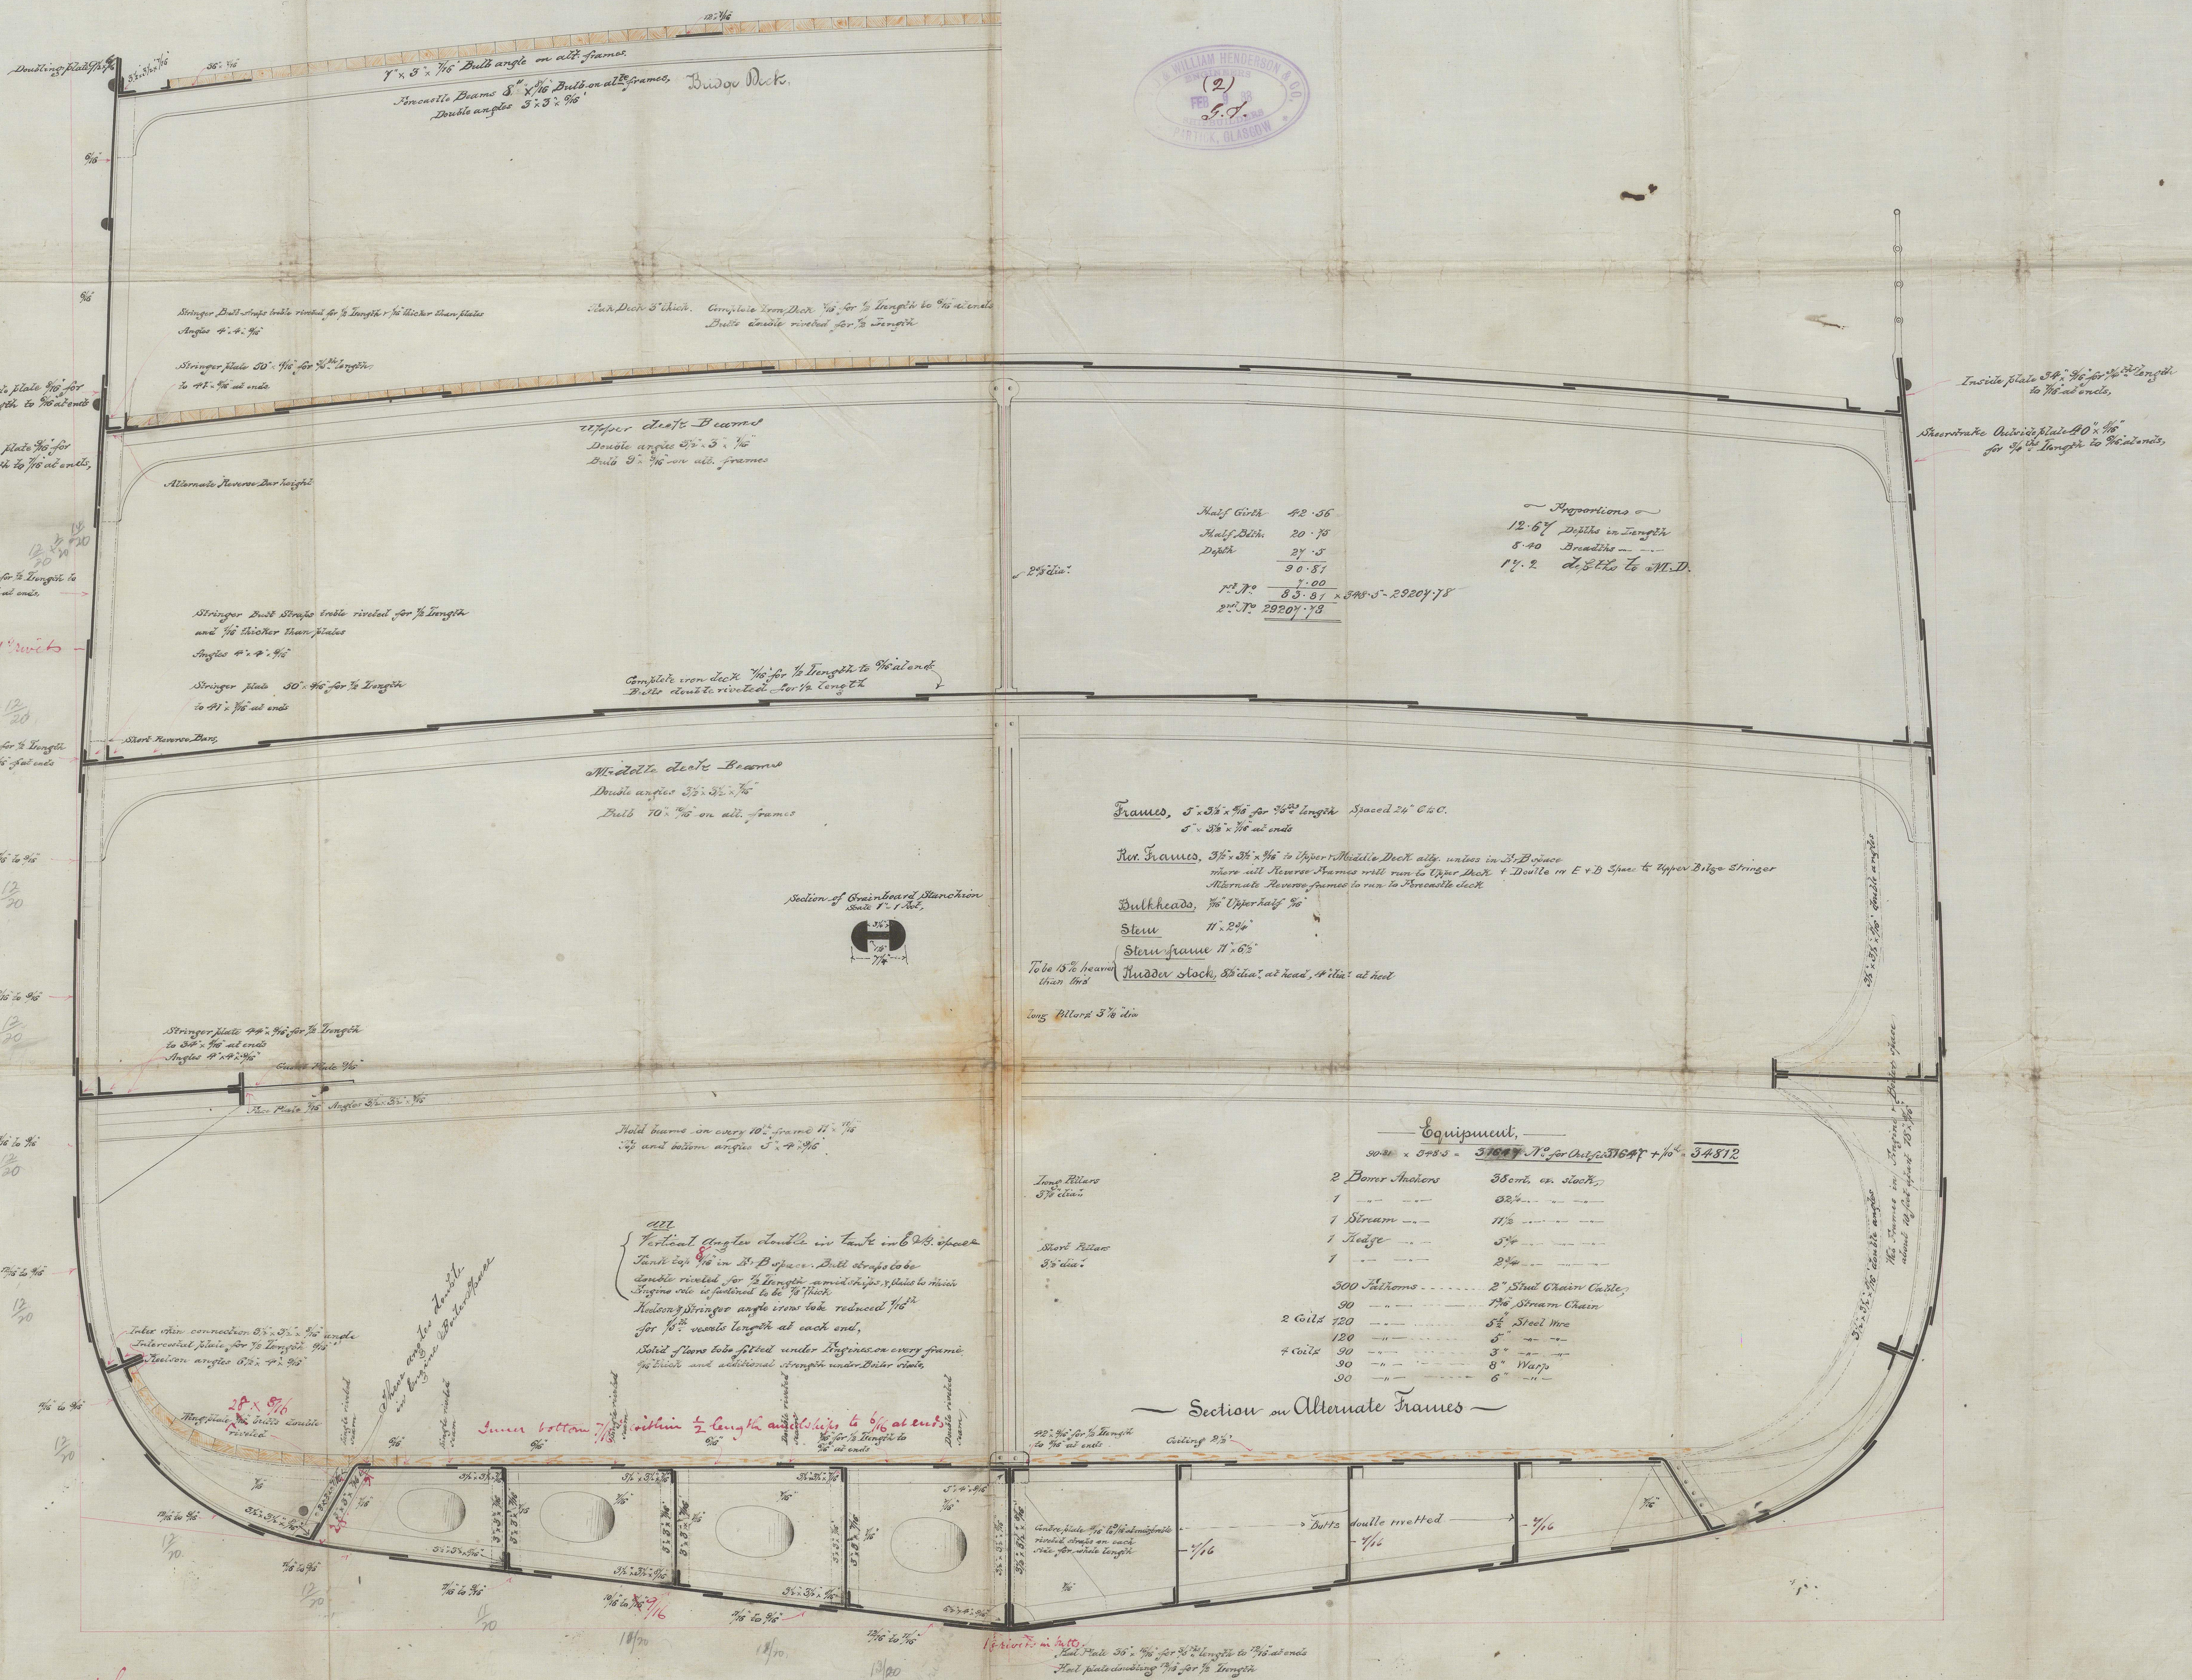

Half Girth 42.58  
Half Ditch 20.75  
Depth 24.5  
90.87  
1.00  
11.70 85.87 = 548.5 - 2224.75  
22.70 2224.75

Proportions  
12.67 Depth in Length  
5.00 Breadth  
14.2 L to B to H.D.

Frames, 5.35 x 1/2" for 1/2" length Spaced 26" C.C.  
5.35 x 1/2" at ends

For Frames, 3/8" x 3/8" to Upper Middle Deck only, unless in B.D. space  
where all Reverse Frames will run to Upper Deck & Double in E & B Space to Upper Deck Stringer  
Alternate Reverse frames to run to Forecastle deck

Bulkheads, 1/2" Upper half 1/2"

Stern 11.25"

Stern frame 11.65"

Header Stock, 3/8" dia, at head, 1/2" dia at heel

To be 1/2" heavier than head

Long Mould 5 1/2" dia

Equipment,  
300 x 500 S - 3168.7" for Outfit 3168.7" + 1/2" = 3487.2

Long Pillars 3/8" dia	2 Bone Ankers 35 cent. ea. stock
1	1
1 Strain	11 1/2
1 Ridge	5 1/2
1	2 1/2
500 Pillars	2" Steel Chain Cable
30	1 1/2" Strain Chain
2 Cais 120	5 1/2" Steel Wire
120	5
7 Cais 30	5
30	8" Warp
30	6

Section on Alternate Frames

15/8  
19/8/83