
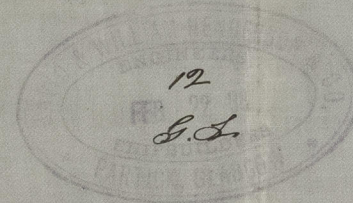


S.S. "Copack" Glasgow Report No. 6435.
S.S. "Ningchow" — do — 6442.

Sketch showing side of Tank

"S.S. 262"


Scale 1" = 1 Foot.

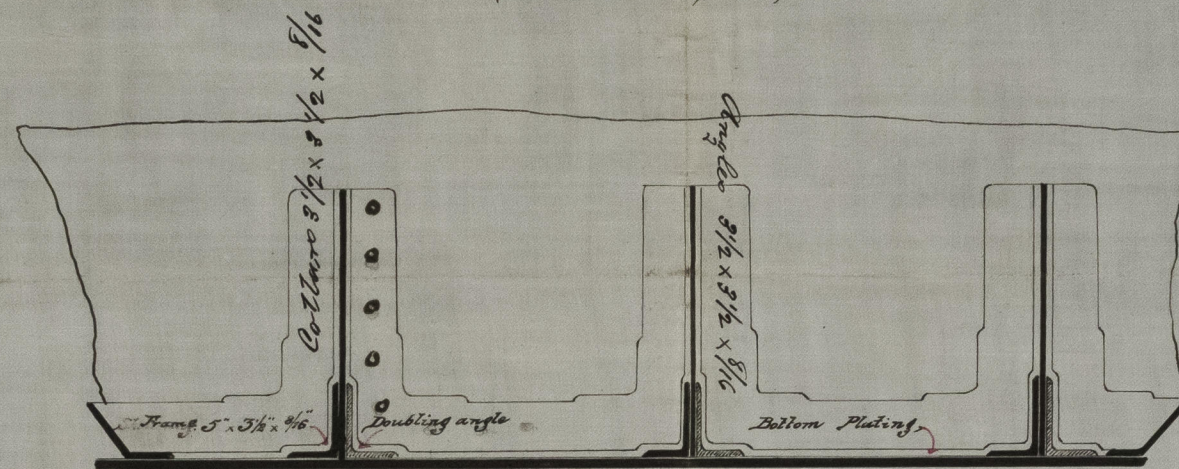

Section of W.B. Tank

"S.S. 262"

Scale 1/2" = 1 Foot.

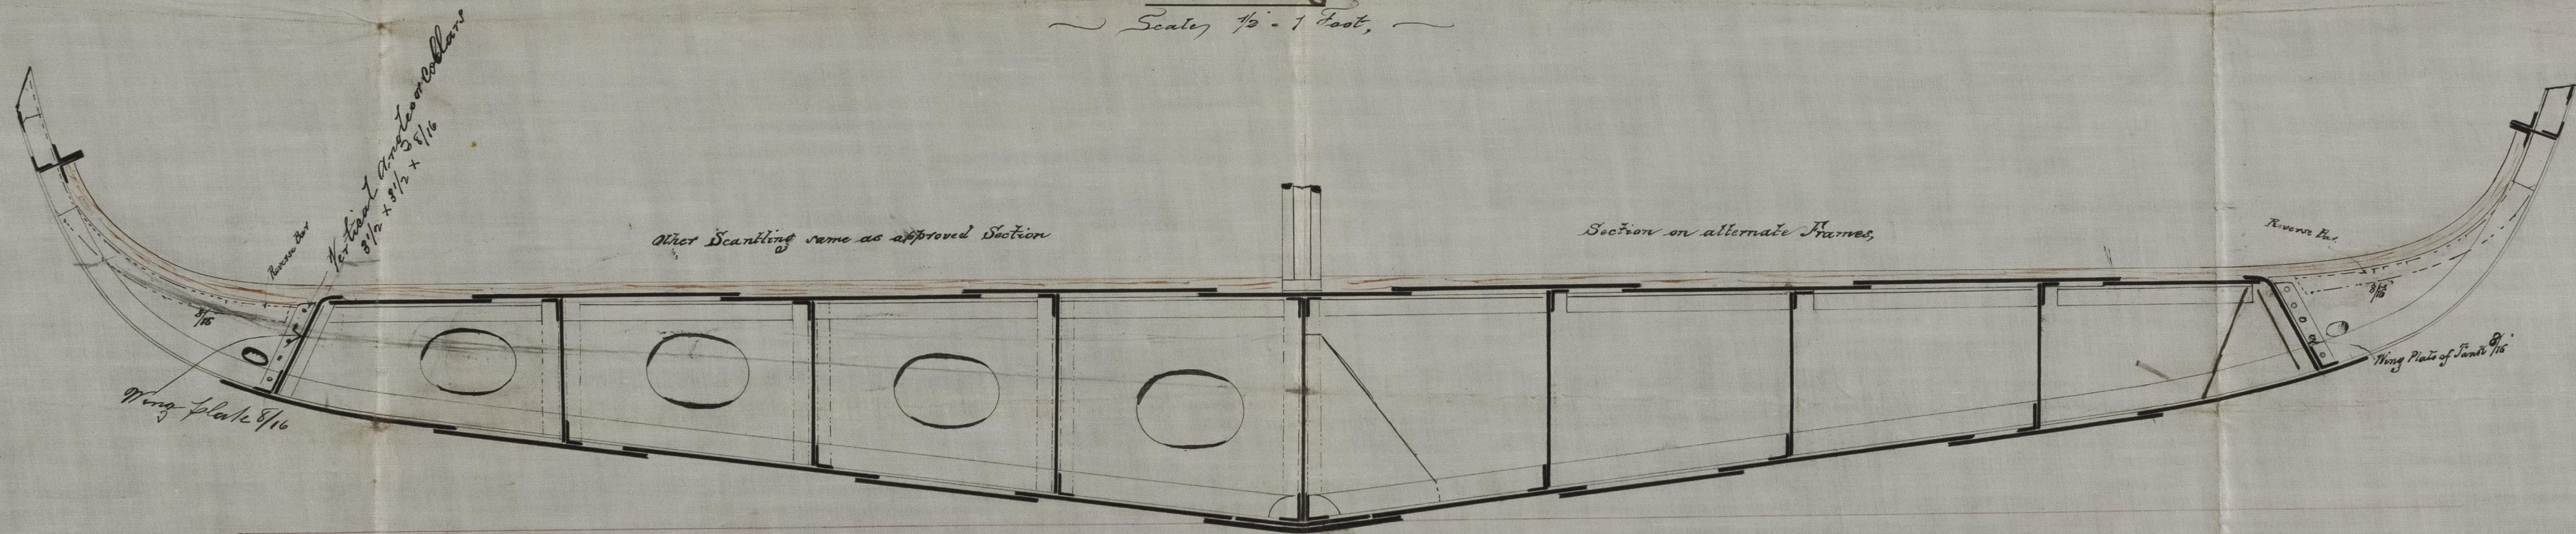

Dr. Hills:
24/2/83.
12/3/83.
19/4/83

YBM
24/2/83
J.H.