

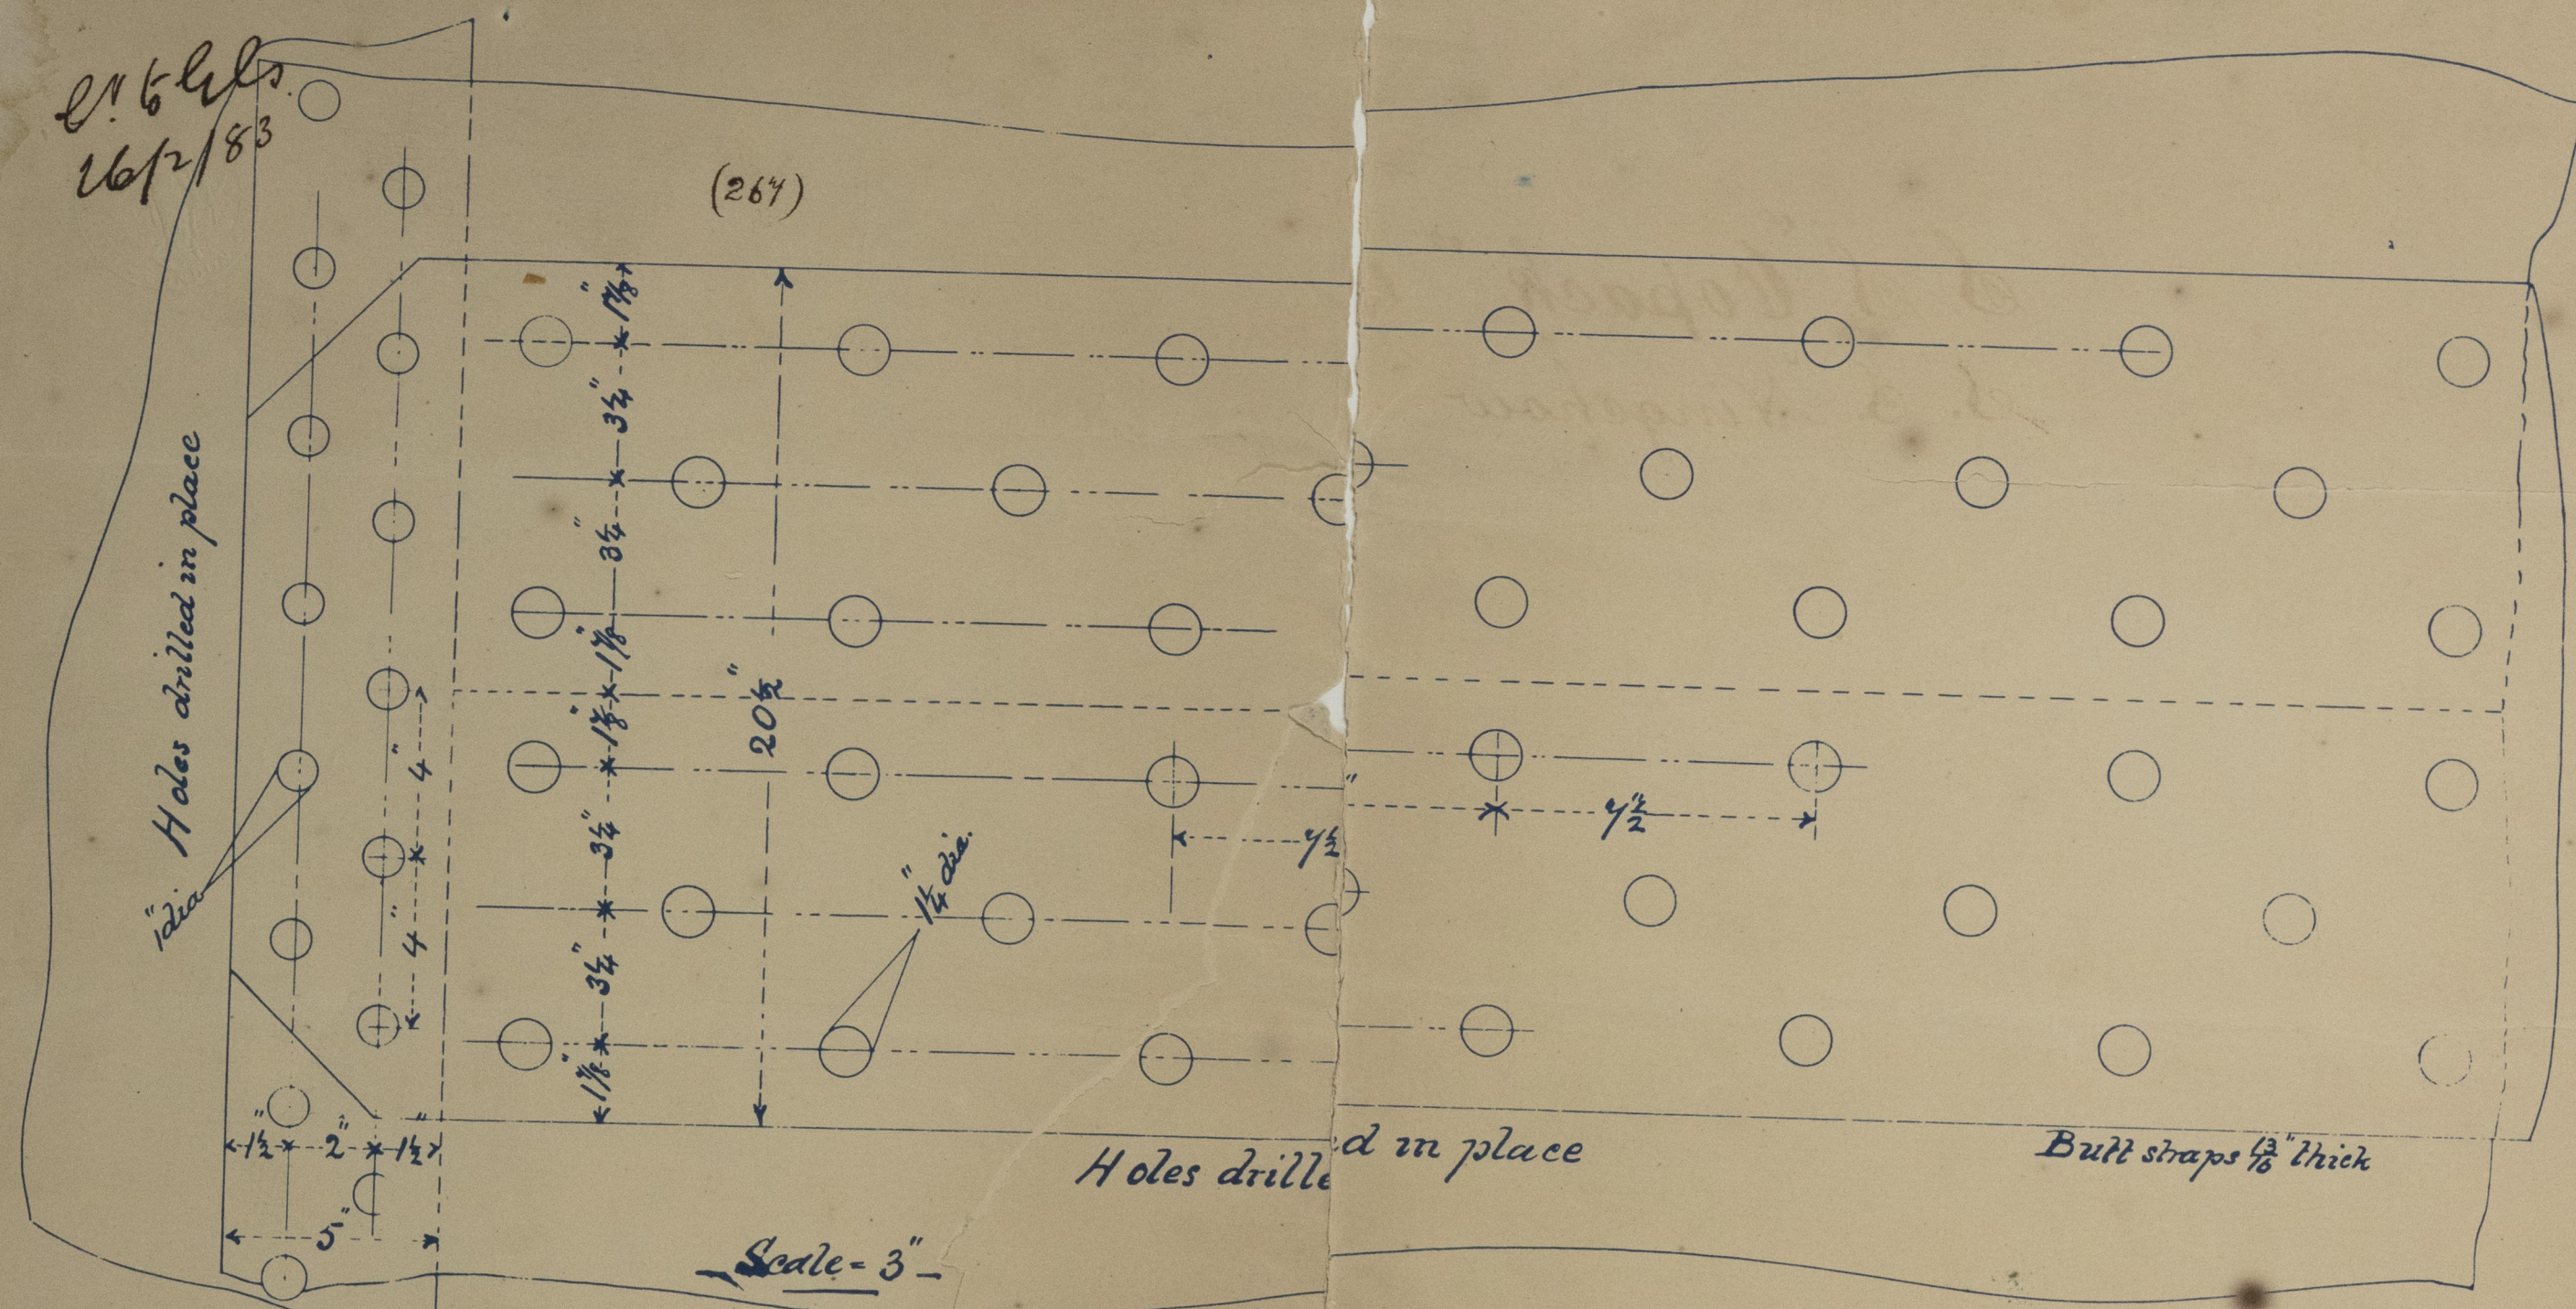


216 lbs
Up 83

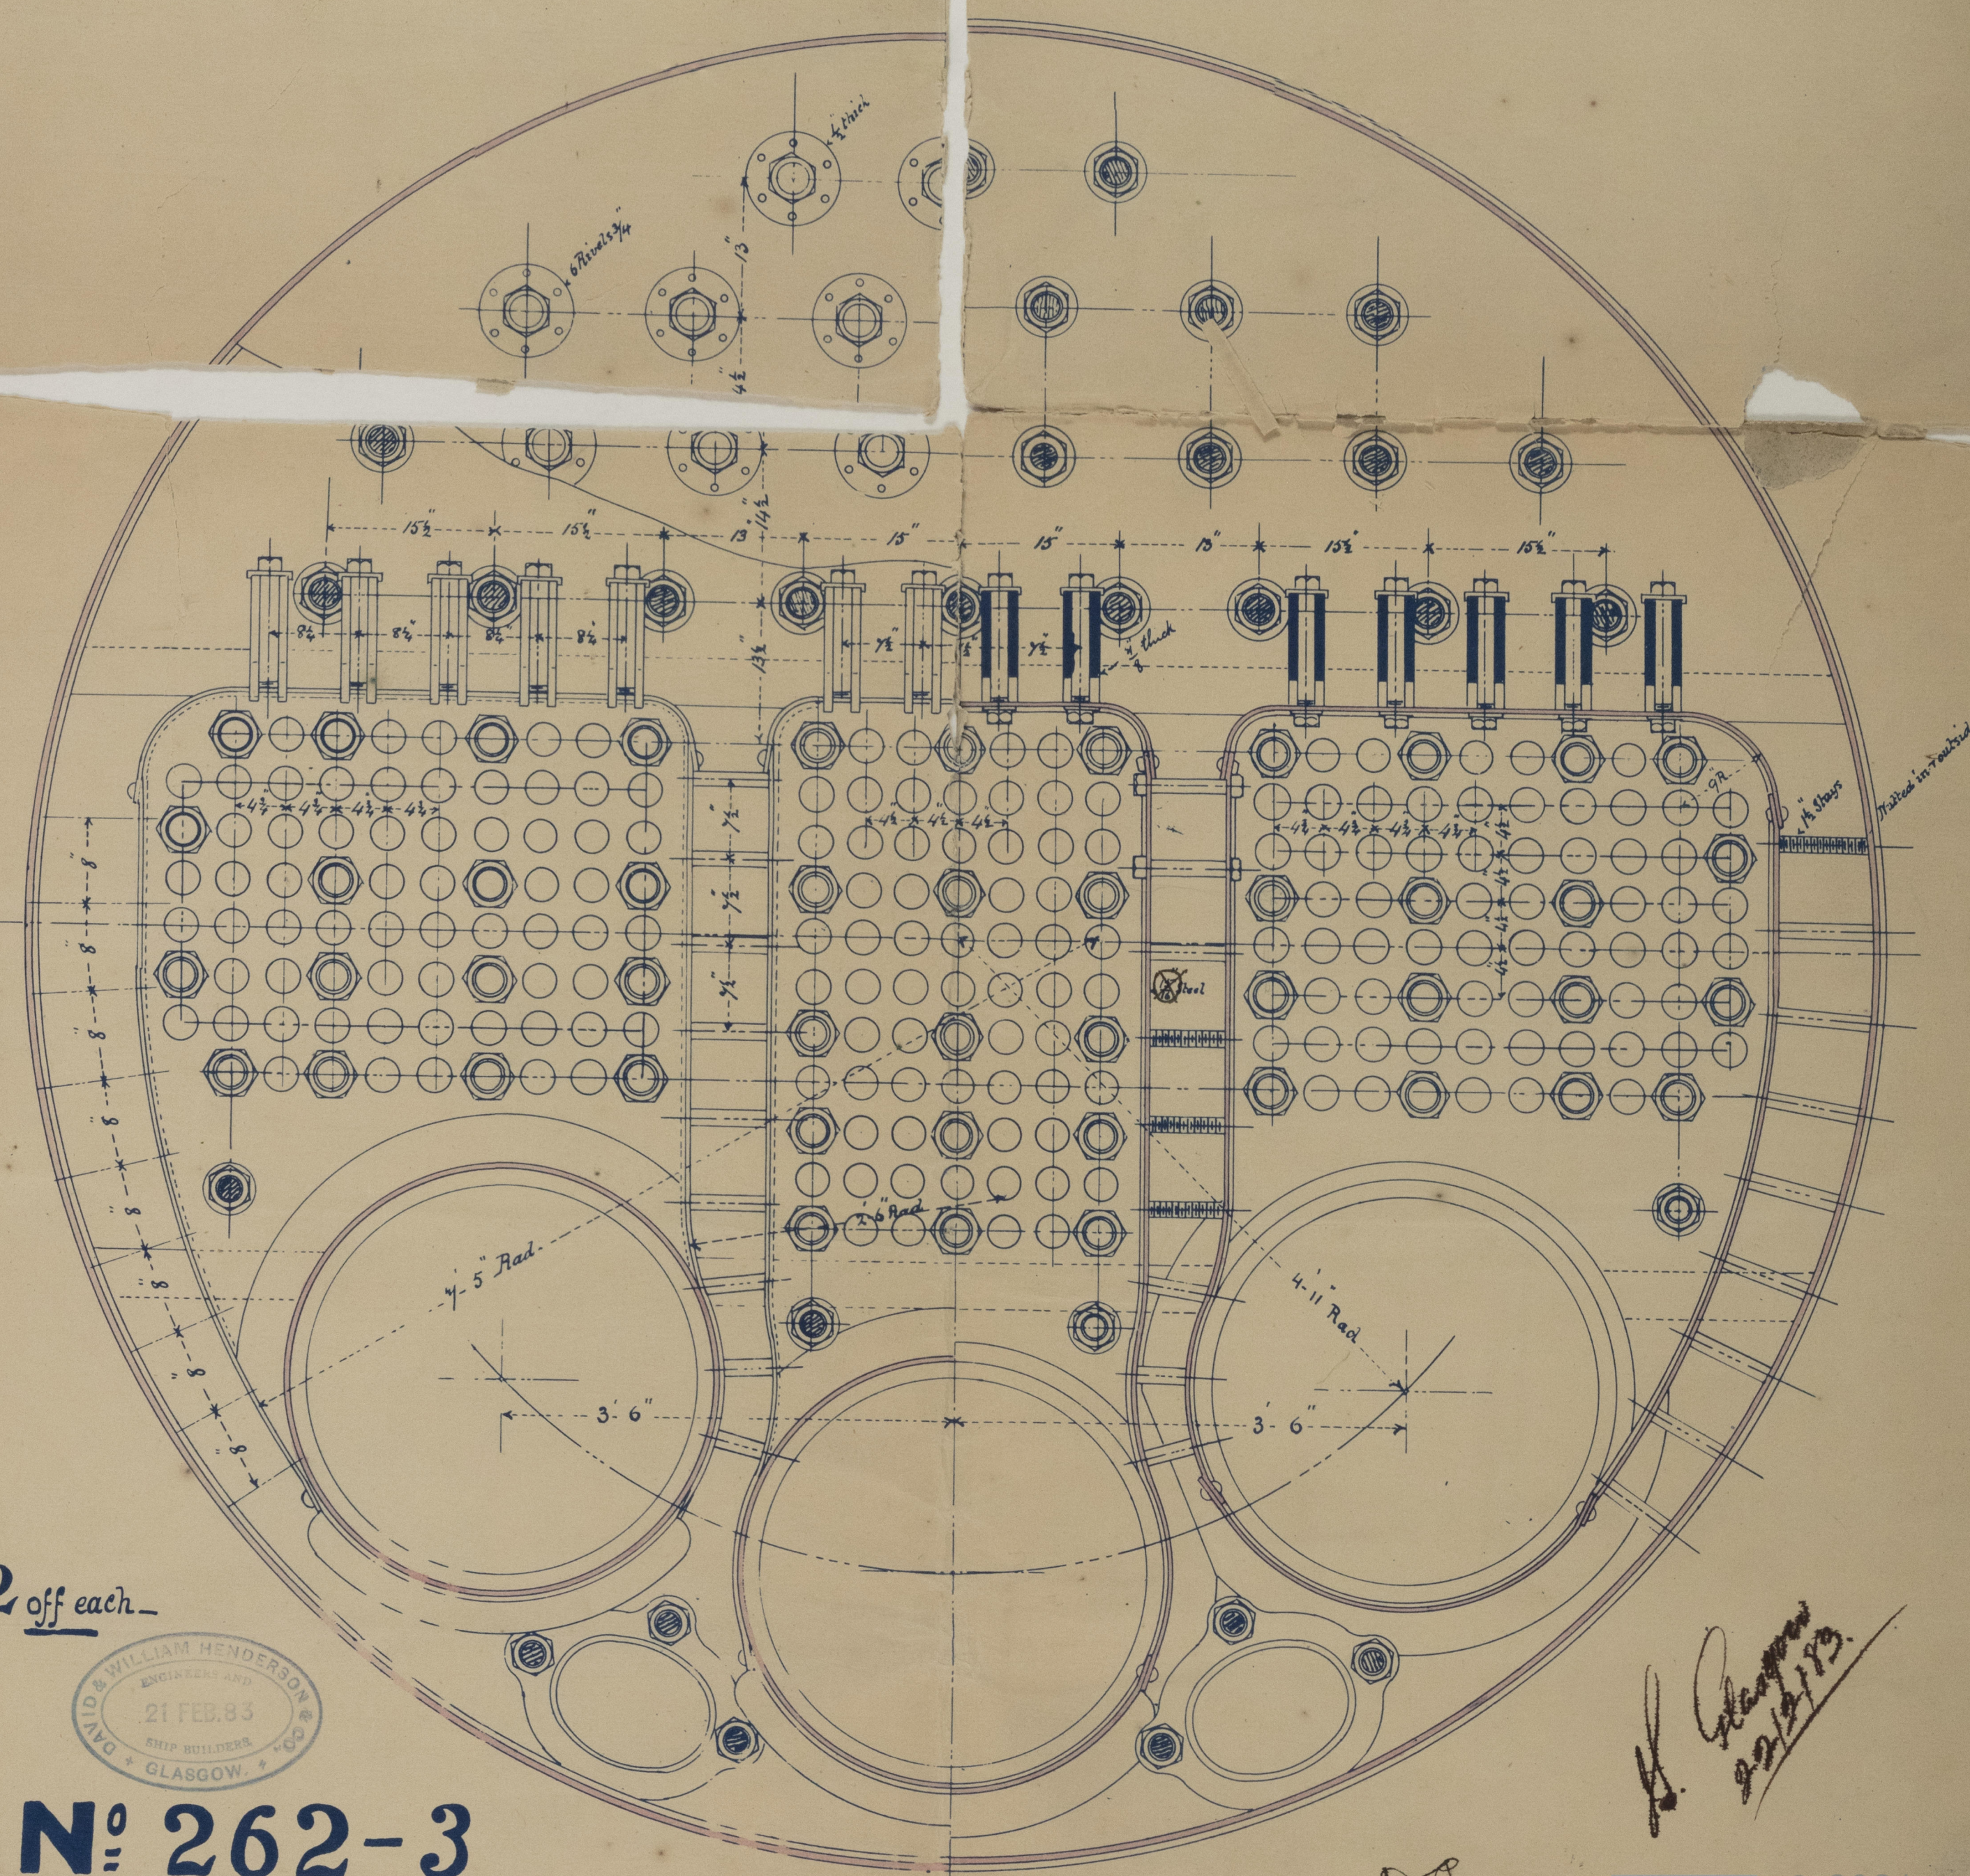

S. S. "Copack" Glasgow Report No. 6435
S. S. "Vingehow" do do "6442."

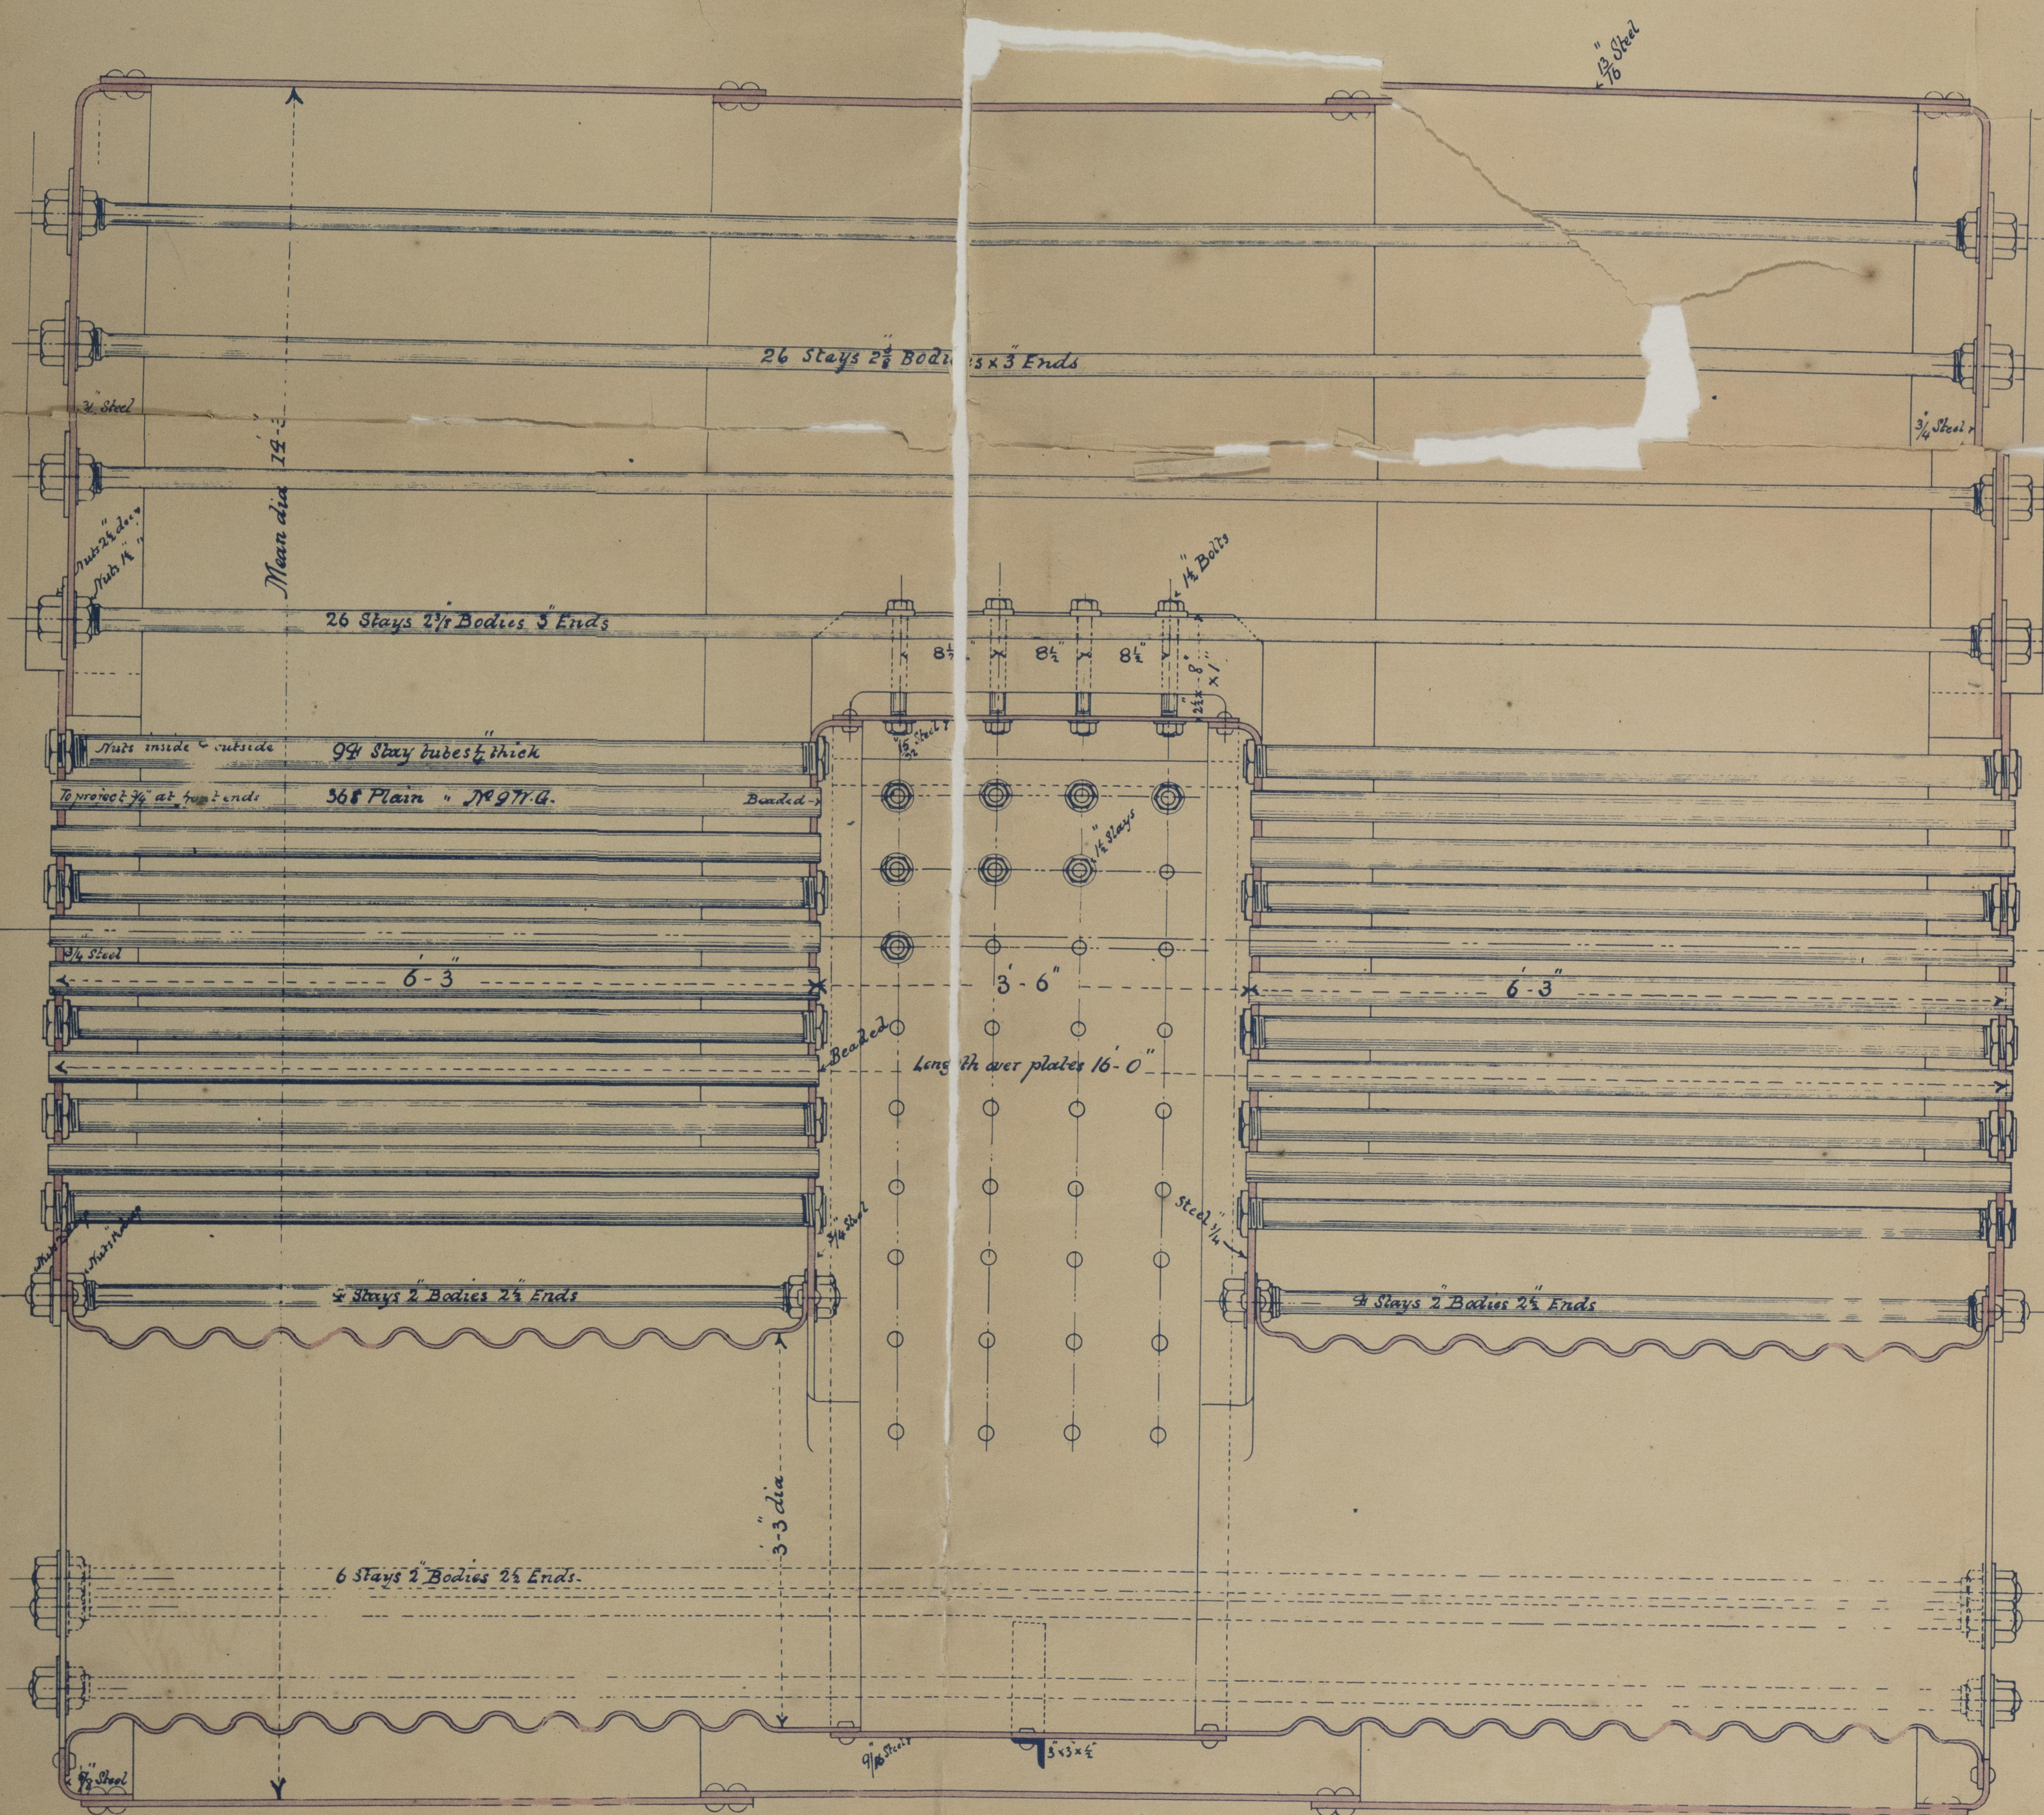

N^o 262-3

Scale - 1"

WORKING PRESSURE - 90 lbs

W.J.
24/2/83

H. S. S. S.
22/2/83



© 2021
Lloyd's Register
Glasgow & London

Mr. Boile
Henderson's
No. 262.0.

11/11





© 2021

Lloyd's Register
Foundation