
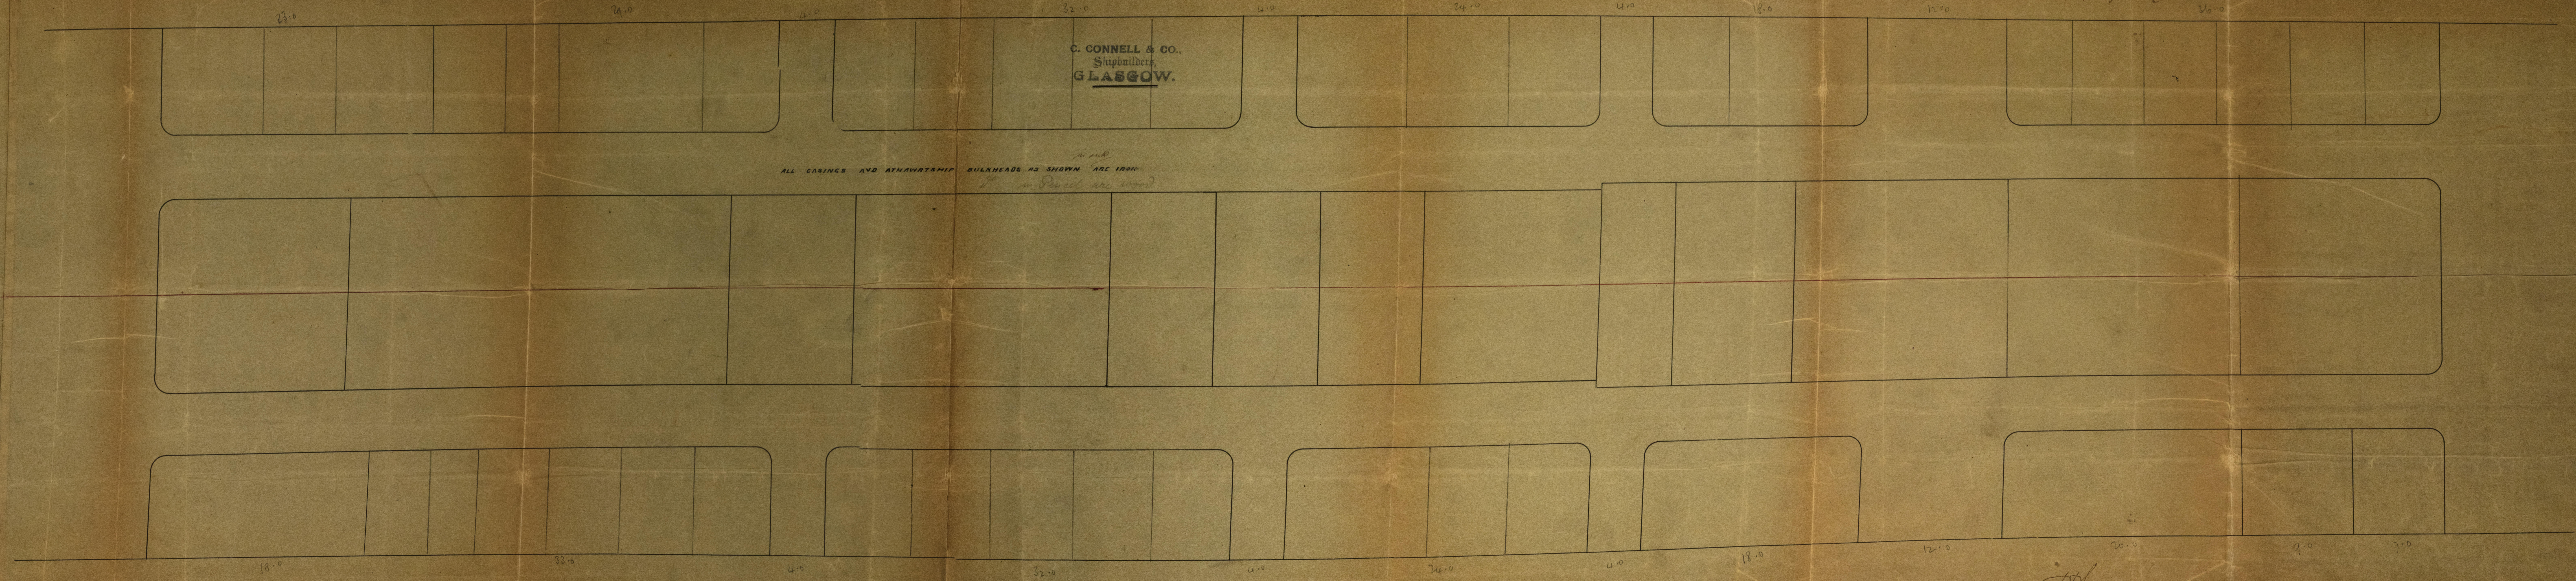


RECEIVED 23 NOV. 82
RECEIVED 13 NOV. 82

SKETCH SHEWING BULKHEADS UNDER BRIDGE DECK SCREW STEAMER N° 132
SCALE 1/2 INCH PER FOOT

S.S. "City of Chicago" Glasgow Report N° 6236.
S.S. "Vancouver" Glasgow Report N° 6510.

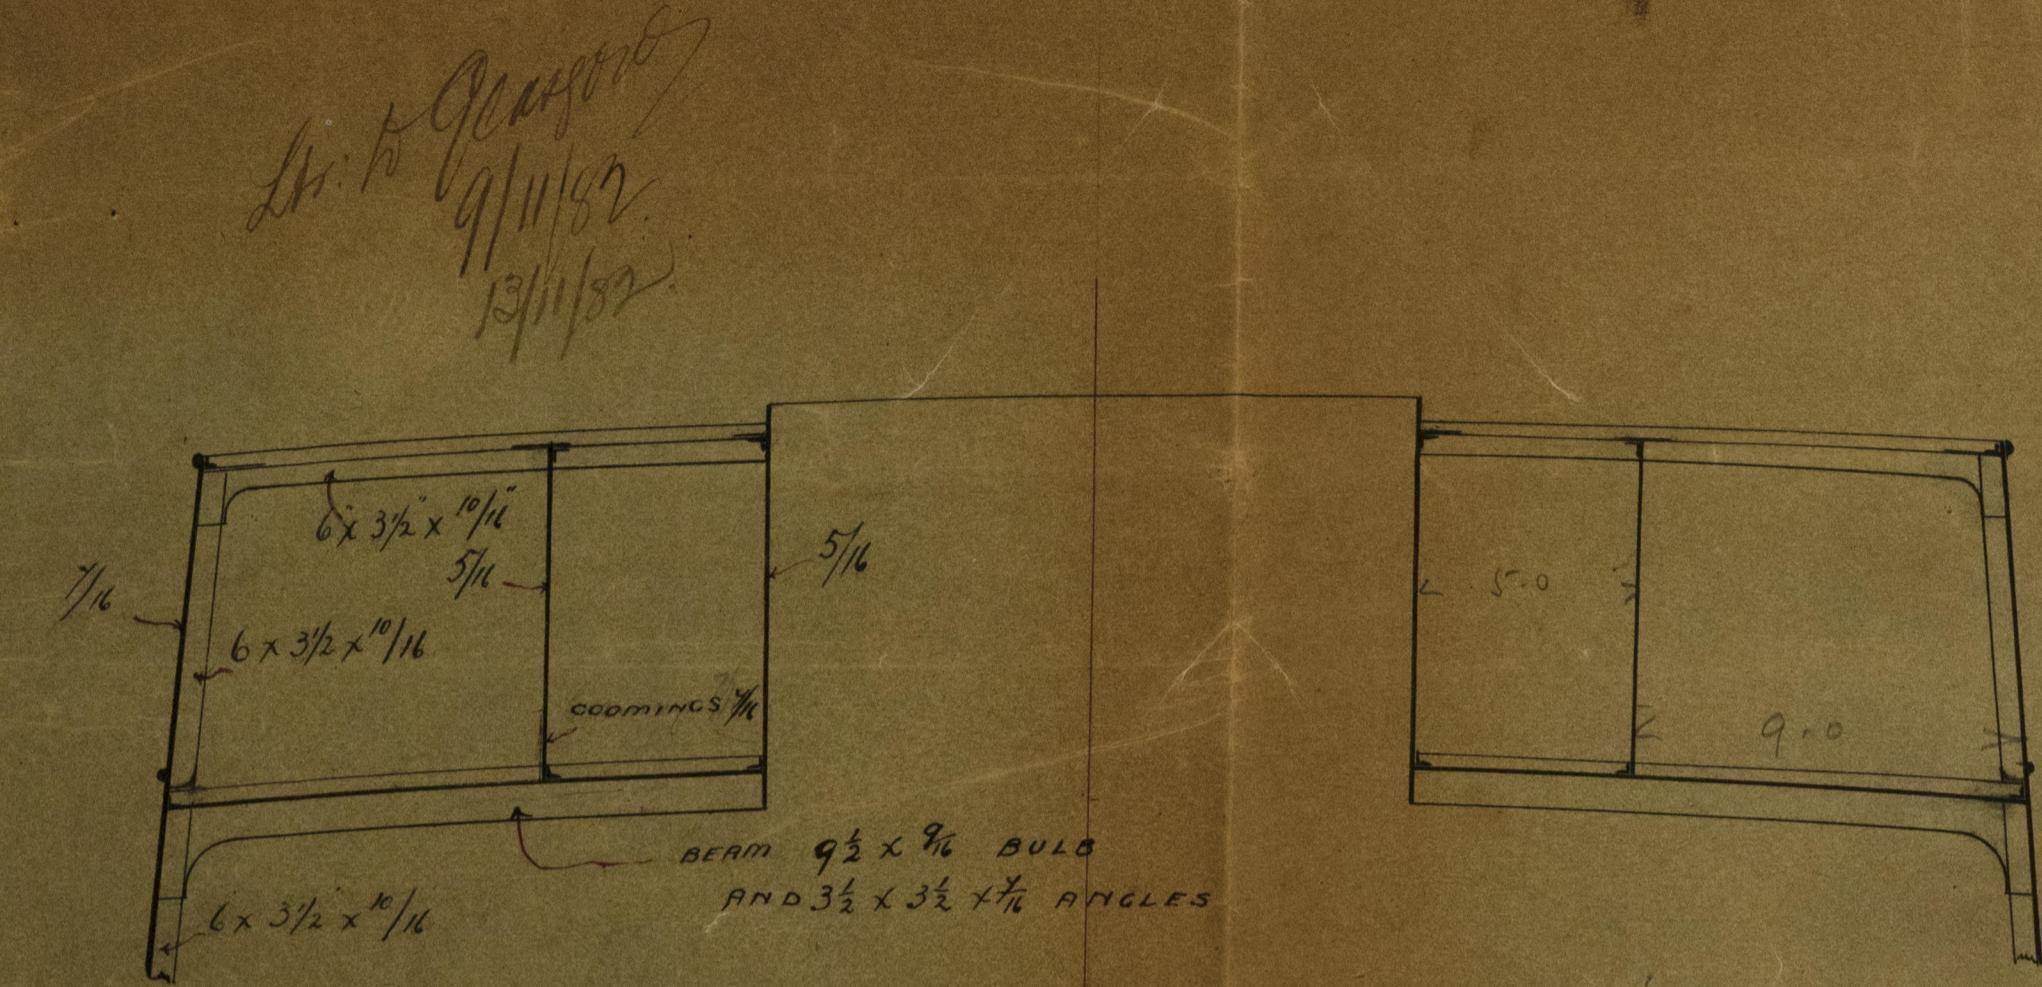

C. CONNELL & CO.,
Shipbuilders,
GLASGOW.

J.H.G.
9/11/82
13/11/82