

# Glasgow Report No. 6515

## Lloyd's Register of British and Foreign Shipping.

(Received in the London Office, .)

F.

No. 580

### REPORT ON SHIP FORGINGS.

Sir,

I beg leave to report that the undermentioned Forgings, manufactured by  
*Messrs J & R. McIntyre & Co* of *Dalmuir*  
 for the Vessel No. *52*, being built by *Messrs Scott & Co*  
 of *Bowling* have been inspected by ~~me~~<sup>us</sup> in course  
 of being forged and smithed, and found to be, so far as can be seen, *sound and*  
*efficient*

Mark on Forging.

Lloyd's

No. 580

G. N.

The Secretary,  
 London.

We are  
~~am~~ Sir,

Your Obedient Servants


*George Newcomb*  
*J. J. House*

*Glasgow*

*3/1/84.*

	STERN FRAME.	RUDDER FRAME.	STEM.
Material*	<i>Scrap iron</i>		
How made	<i>Forged</i>		
Progress on Inspection	<i>Forged and smithed</i>		
Dates when Inspected	<i>12.13.20.30/11/83.5.11/12/83.</i>		

SKETCHES OF FRAMES SHEWING POSITION AND DESCRIPTION OF WELDS.

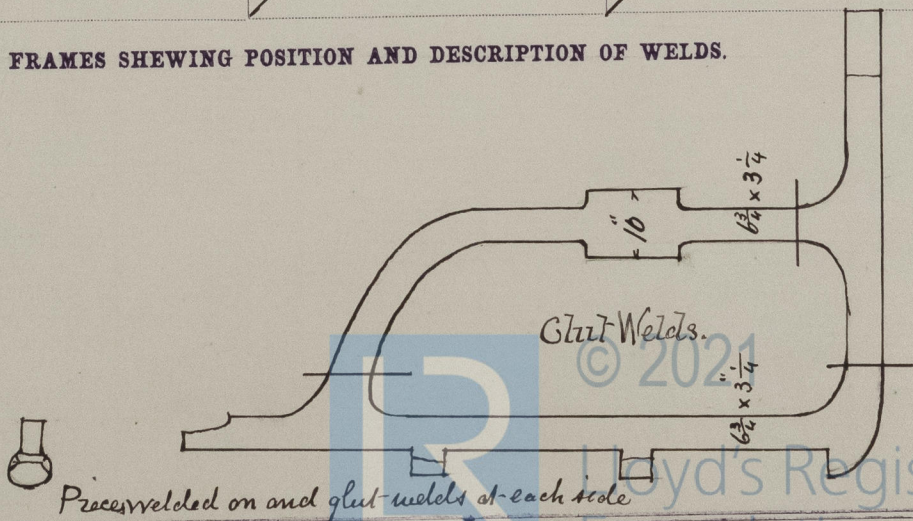

*Presswelded on and glut-welds at each side*

\* If of iron, state whether scrap or puddled iron.