

# Glasgow Report No. 6515-Office 15. 18

## Lloyd's Register of British and Foreign Shipping.

(Report on Vessel No. \_\_\_\_\_ Port \_\_\_\_\_)

### No. 580 SHIP FORGINGS OR CASTINGS.

I have to report that the undermentioned Iron ~~or Steel~~ Forgings ~~or Castings~~, manufactured by  
*The Vulcan Forge Co* of *Dalmuir*  
 for the Vessel No. *52*, being built by *Messrs Scott & Co*  
 of *Bowling* have been inspected by me as set forth below, and found  
 to be, so far as can be seen, *sound and efficient*

Mark on Forgings.


**Lloyd's**  
 No. 580  
*G. N.*

*George Newcomb*  
*Glasgow*

*13/3/84.*

	STERN FRAME.	RUDDER FRAME.	STEM.
Material* - - - -	/	<i>Scrap iron</i>	/
How made - - - -		<i>Forged</i>	
Dimensions - - - -		<i>3 3/4 to 1 7/8</i>	
Progress on Inspection -		<i>Forged and smithed</i>	
Dates when Inspected		<i>5/2/84. 6.12/3/84.</i>	

SKETCHES OF FRAMES SHEWING POSITION AND DESCRIPTION OF WELDS OF FORGINGS, OR PARTICULARS OF TESTS APPLIED TO CASTINGS.

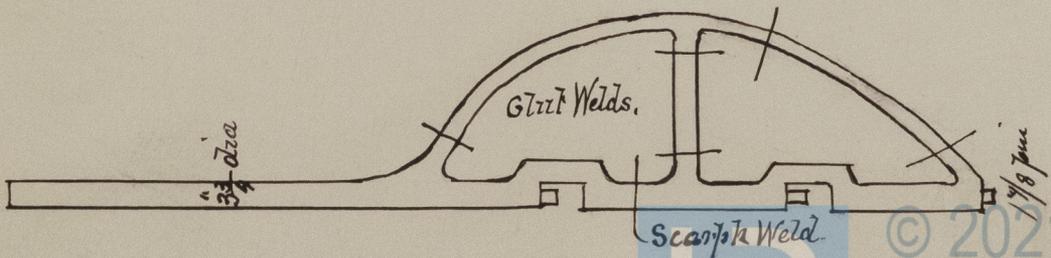

[T-2000-10/83-Trans. Ink.]

\* If of Iron, state whether scrap or puddled iron.

