

(Received in the London Office,

LLOYD'S REGISTER OF SHIPPING
 19 SEP. 83
 LONDON

F.

No. 290

REPORT ON SHIP FORGINGS.

Sir,

I beg leave to report that the undermentioned Forgings, manufactured by
The Lancefield Forge Co of *Glasgow*
 for the Vessel No. *391*, being built by *Messrs R. Napier & Sons*
 of *Glasgow* have been inspected by me in course
 of being forged and smithed, and found to be, so far as can be seen, *sound and*
satisfactory

D.S.
 19/9/83

Mark on Forging.

Lloyd's
 No. 290
 G.N

I am, Sir,

Your Obedient Servant,


George Newcomb

Glasgow

The Secretary,
 London.

	STERN FRAME.	RUDDER FRAME.	STEM.
Material*	<i>Scrap iron</i>		
How made	<i>Forged</i>		
Dimensions	<i>11" x 4"</i>		
Progress on Inspection	<i>Forged and smithed</i>		
Dates when Inspected	<i>9/5/83. 17. 28/8/83. 7 & 11/9/83</i>		

SKETCHES OF FRAMES SHEWING POSITION AND DESCRIPTION OF WELDS.

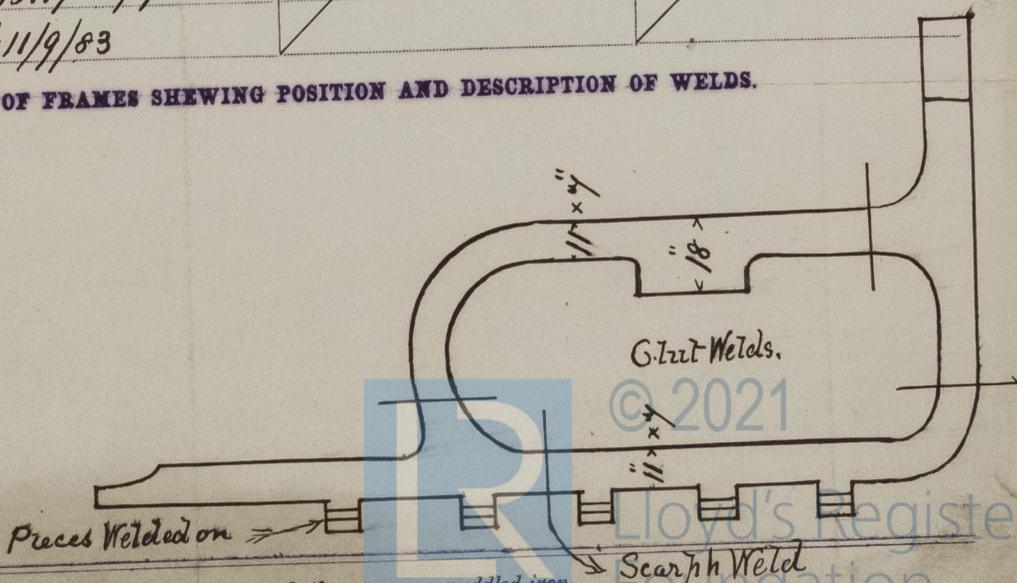

* If of iron, state whether scrap or puddled iron.