

11563
No 391

See: to Lp.
30/3/83.


S. S. "Australasian"
Glasgow Report
No. 6554.

Sketch showing arrangement of Beams Bulkheads, etc.

Scale 1/16" = 1 foot

Builder's Dimensions
350 x 44 x 33

R. Napier & Son.
21st March 1883

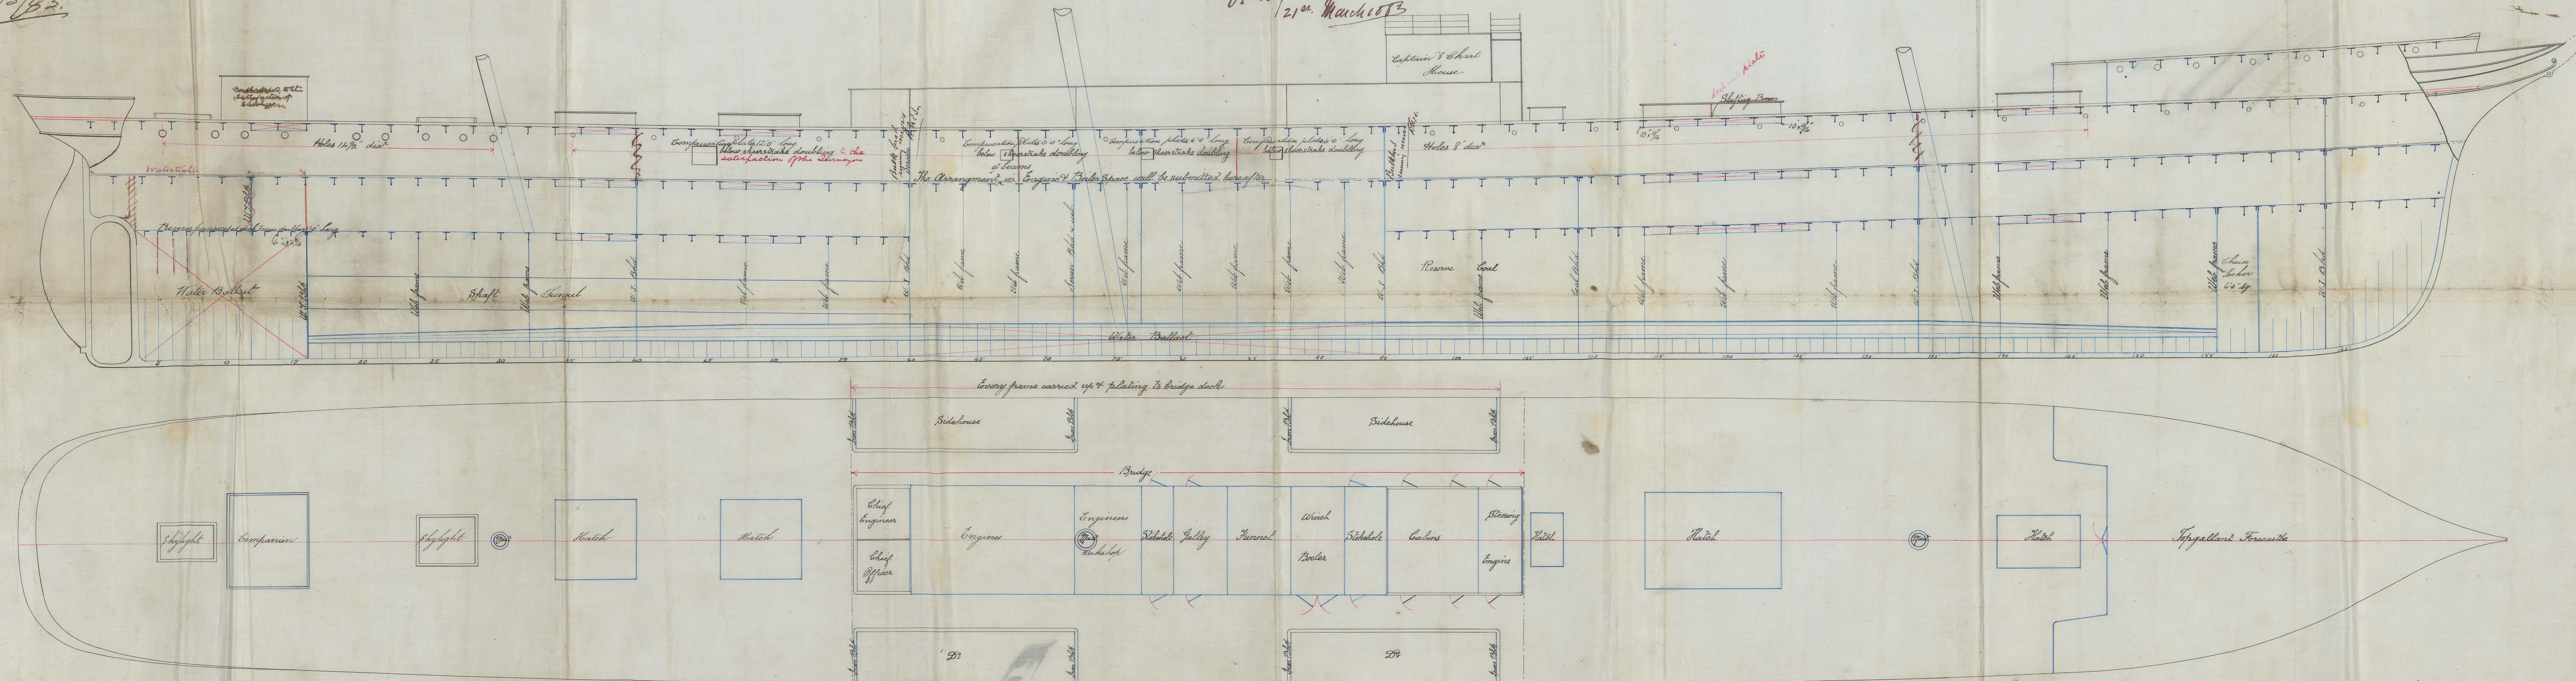

1/16
30/3/83