
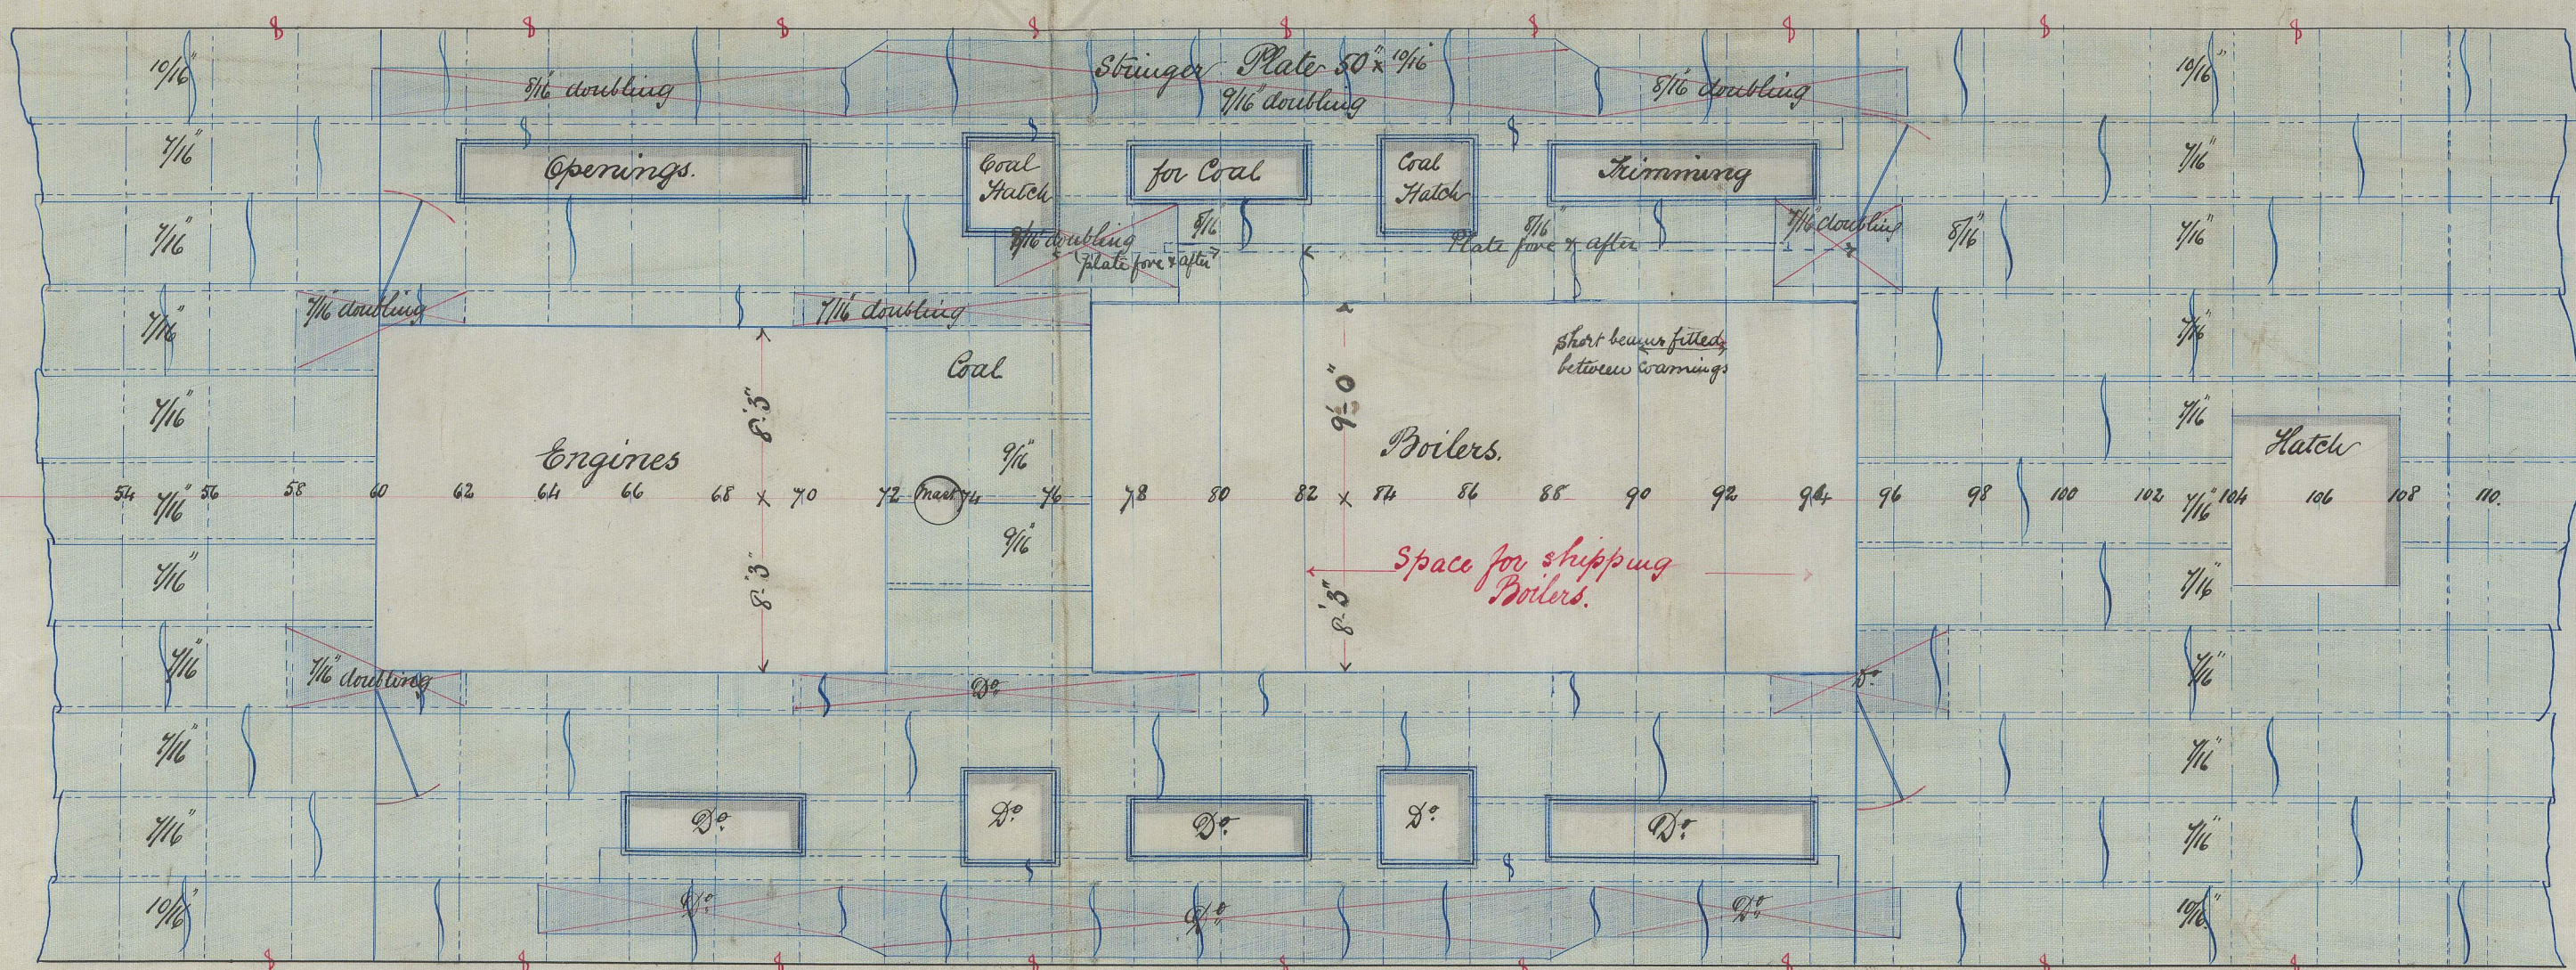
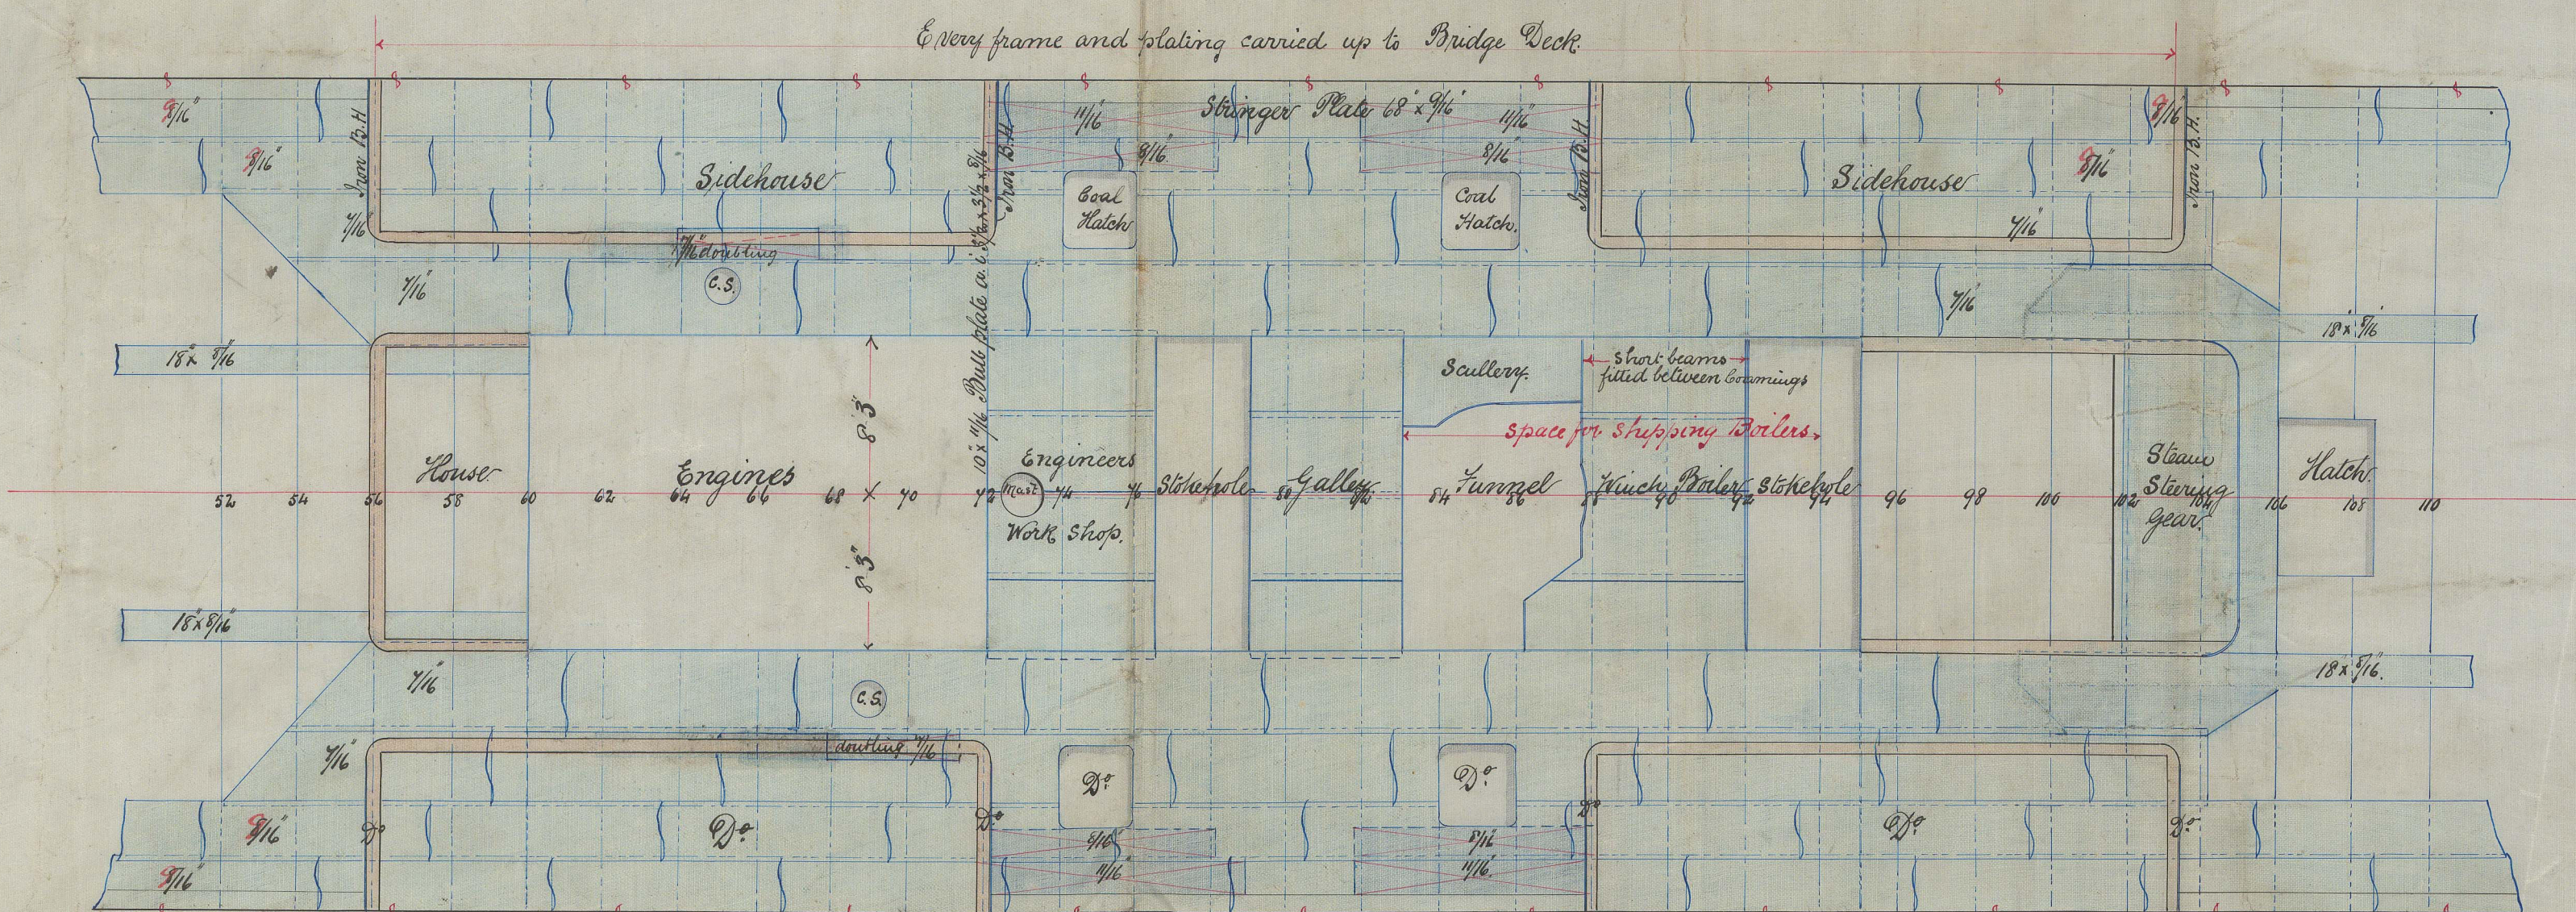


Sketch showing proposed strengthening in Engine and Boiler Space.

Scale 1/2" = 1 Foot.

Wm. Hays & Co.
Glasgow
5 July 1883

S.S. Australasian
Glasgow Report
A. 6554.

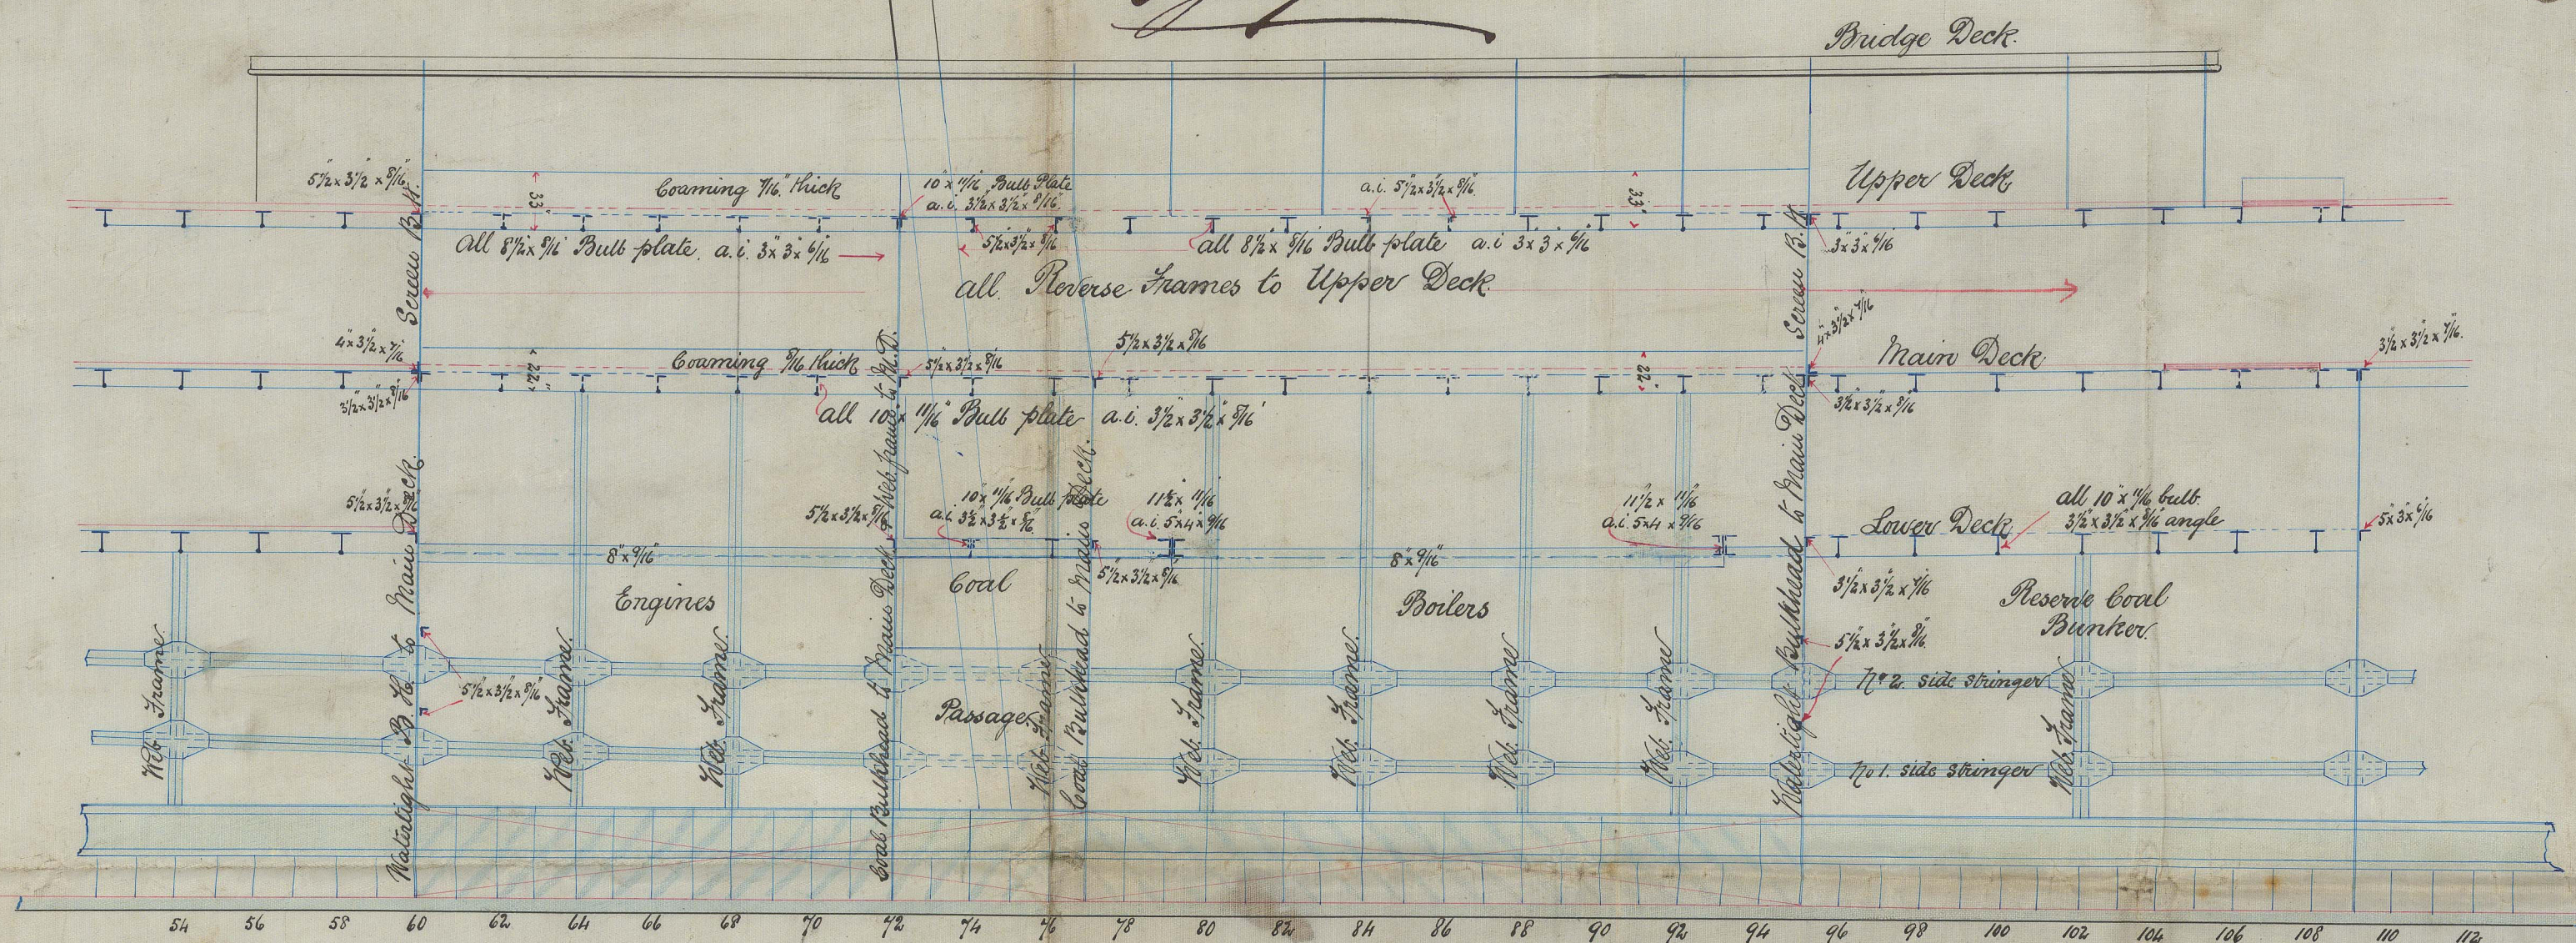

Note. Butts of Outside plating shown thus.

