

12/7/83.

6:12:83.


S.S. "Australia"
Glasgow Report
N^o 6559

— Steel. —

-Midship Section of Awning Decked. Twin Screw. N^o 29

— To Class 90 A1 At. Lloyds.

— Scale $\frac{3}{4}$ " — One Foot. —

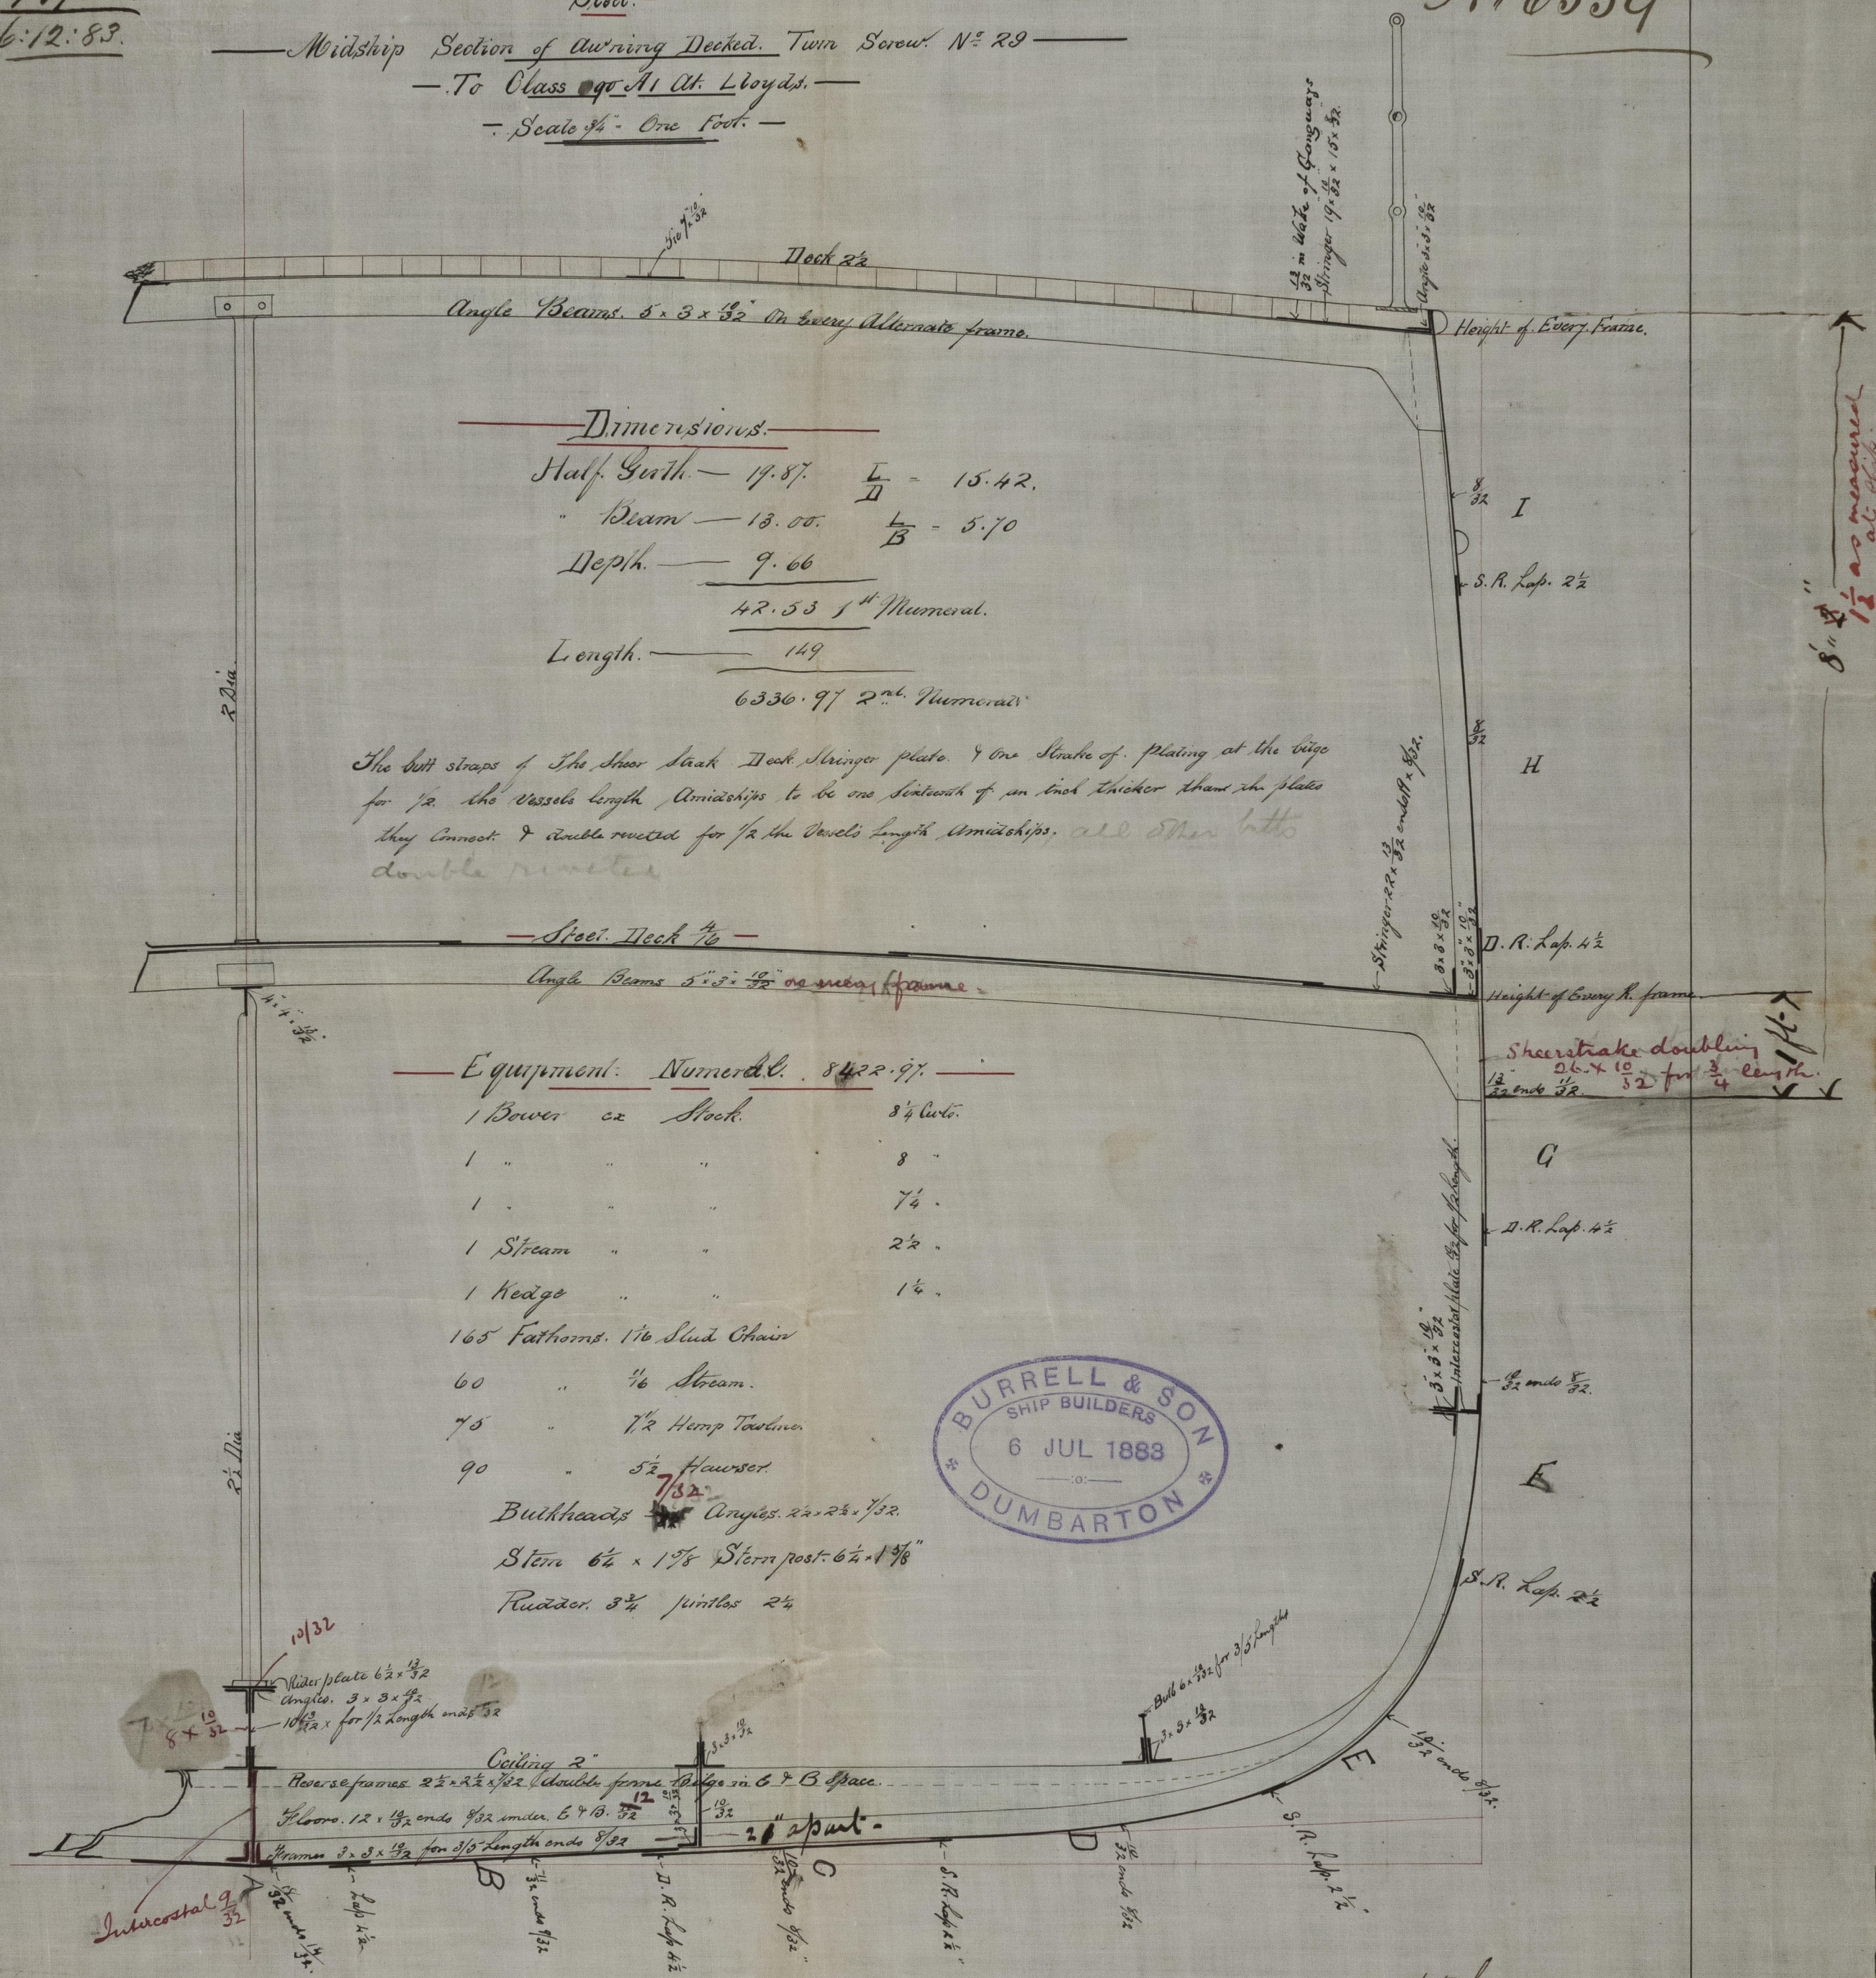

8" $2\frac{1}{2}$ " $1\frac{1}{2}$ " as measured
at ship.

J. P. L.
12
17/83