



S.S. Australia
Glasgow Report
N^o 6559

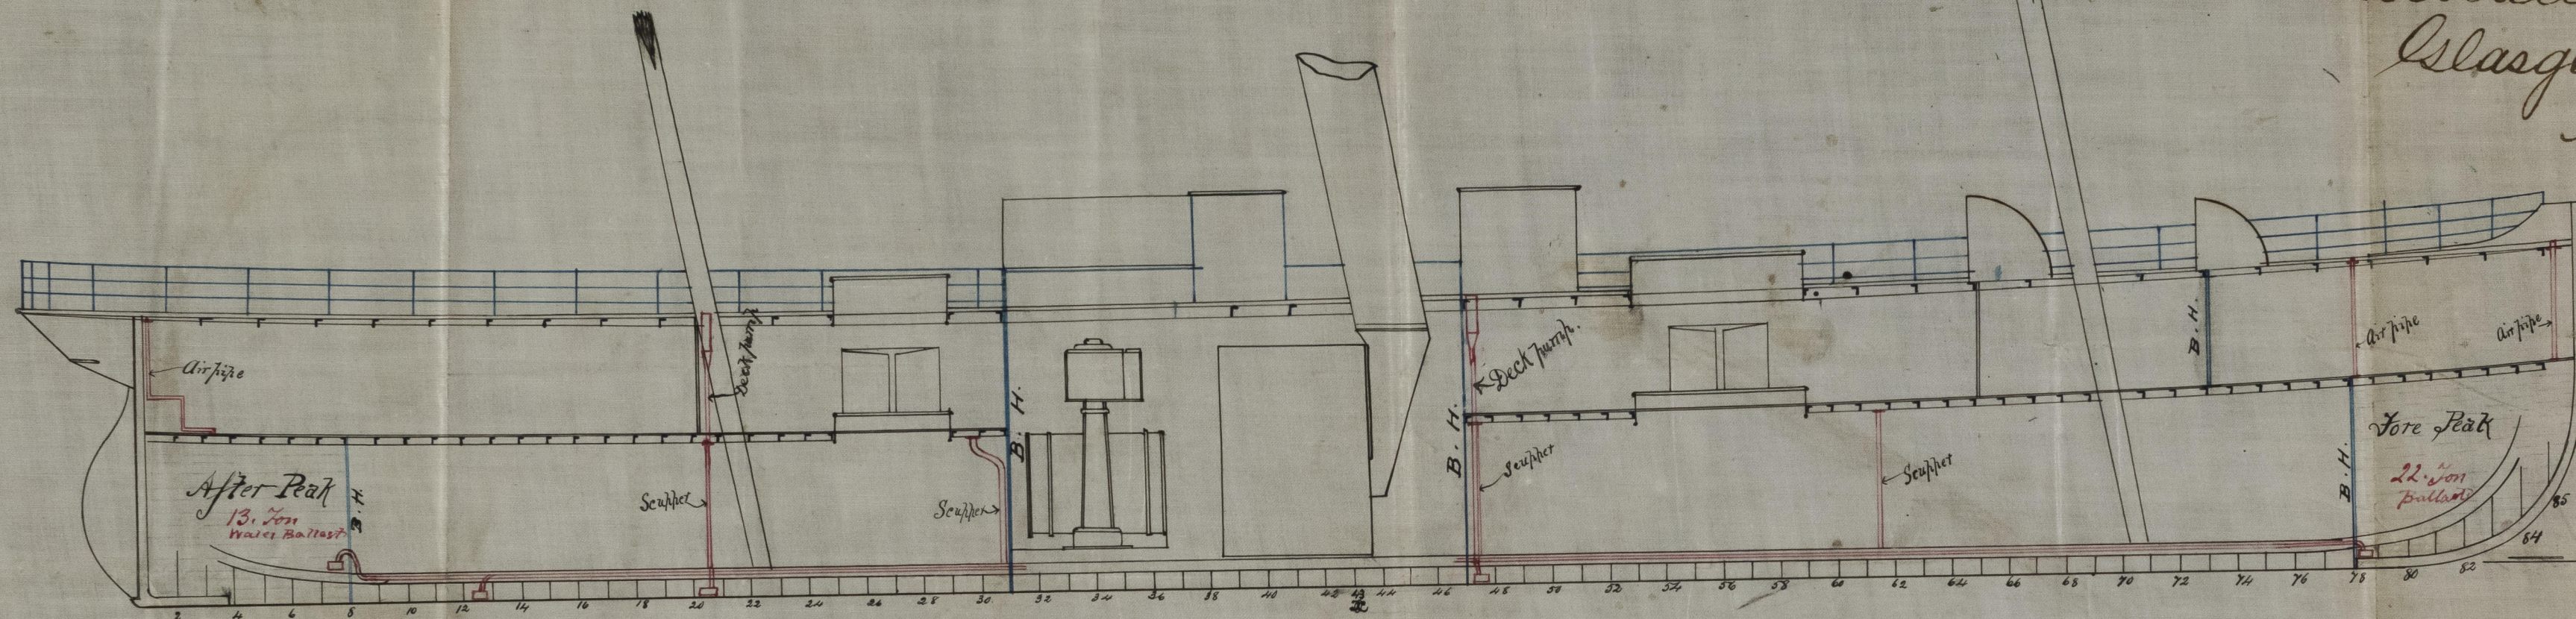

Piping Plan of Twin S.S. N^o 29.
Scale 1/8" = 1 Foot.

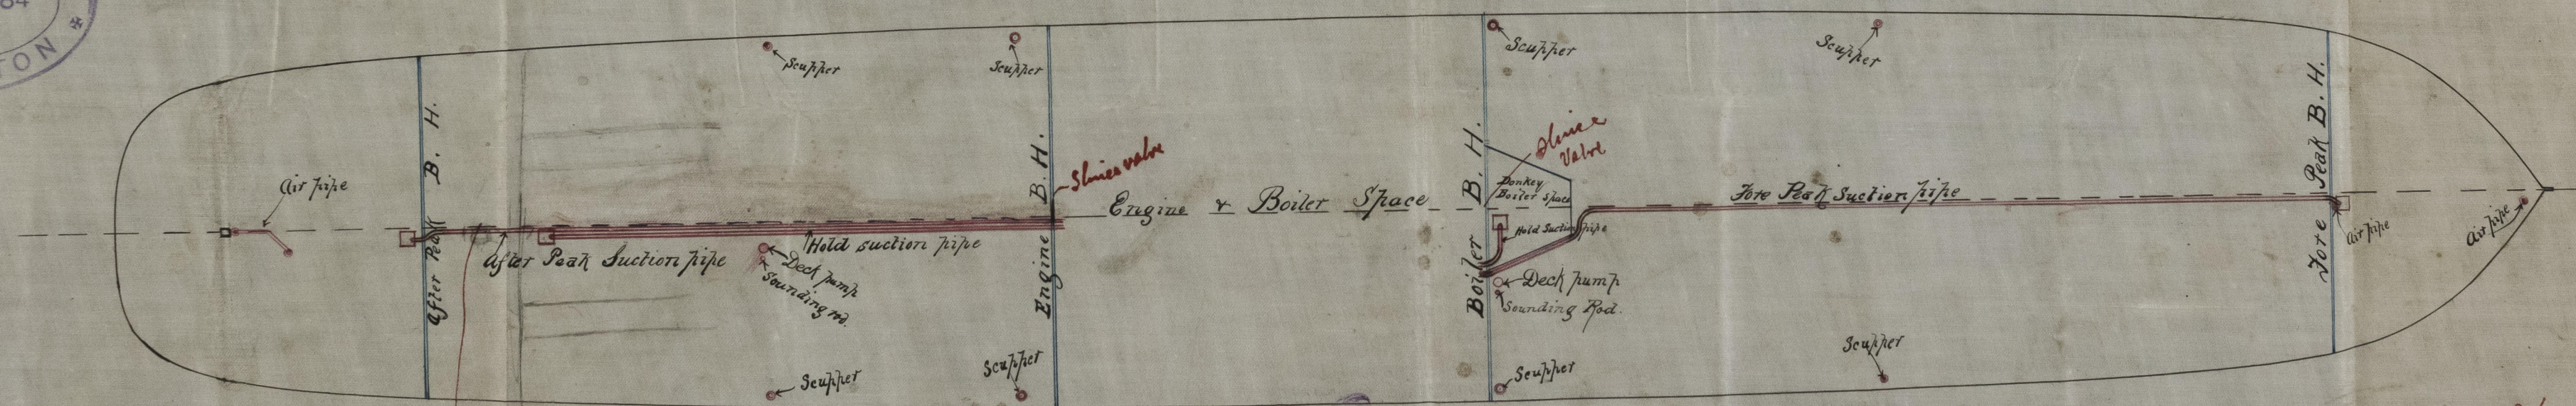

*Means to be adapted
 for sucking out clearing
 tunnels of water.*

J. H. add { James Mollison



© 2021
 Lloyd's Register
 Foundation